


T1.1

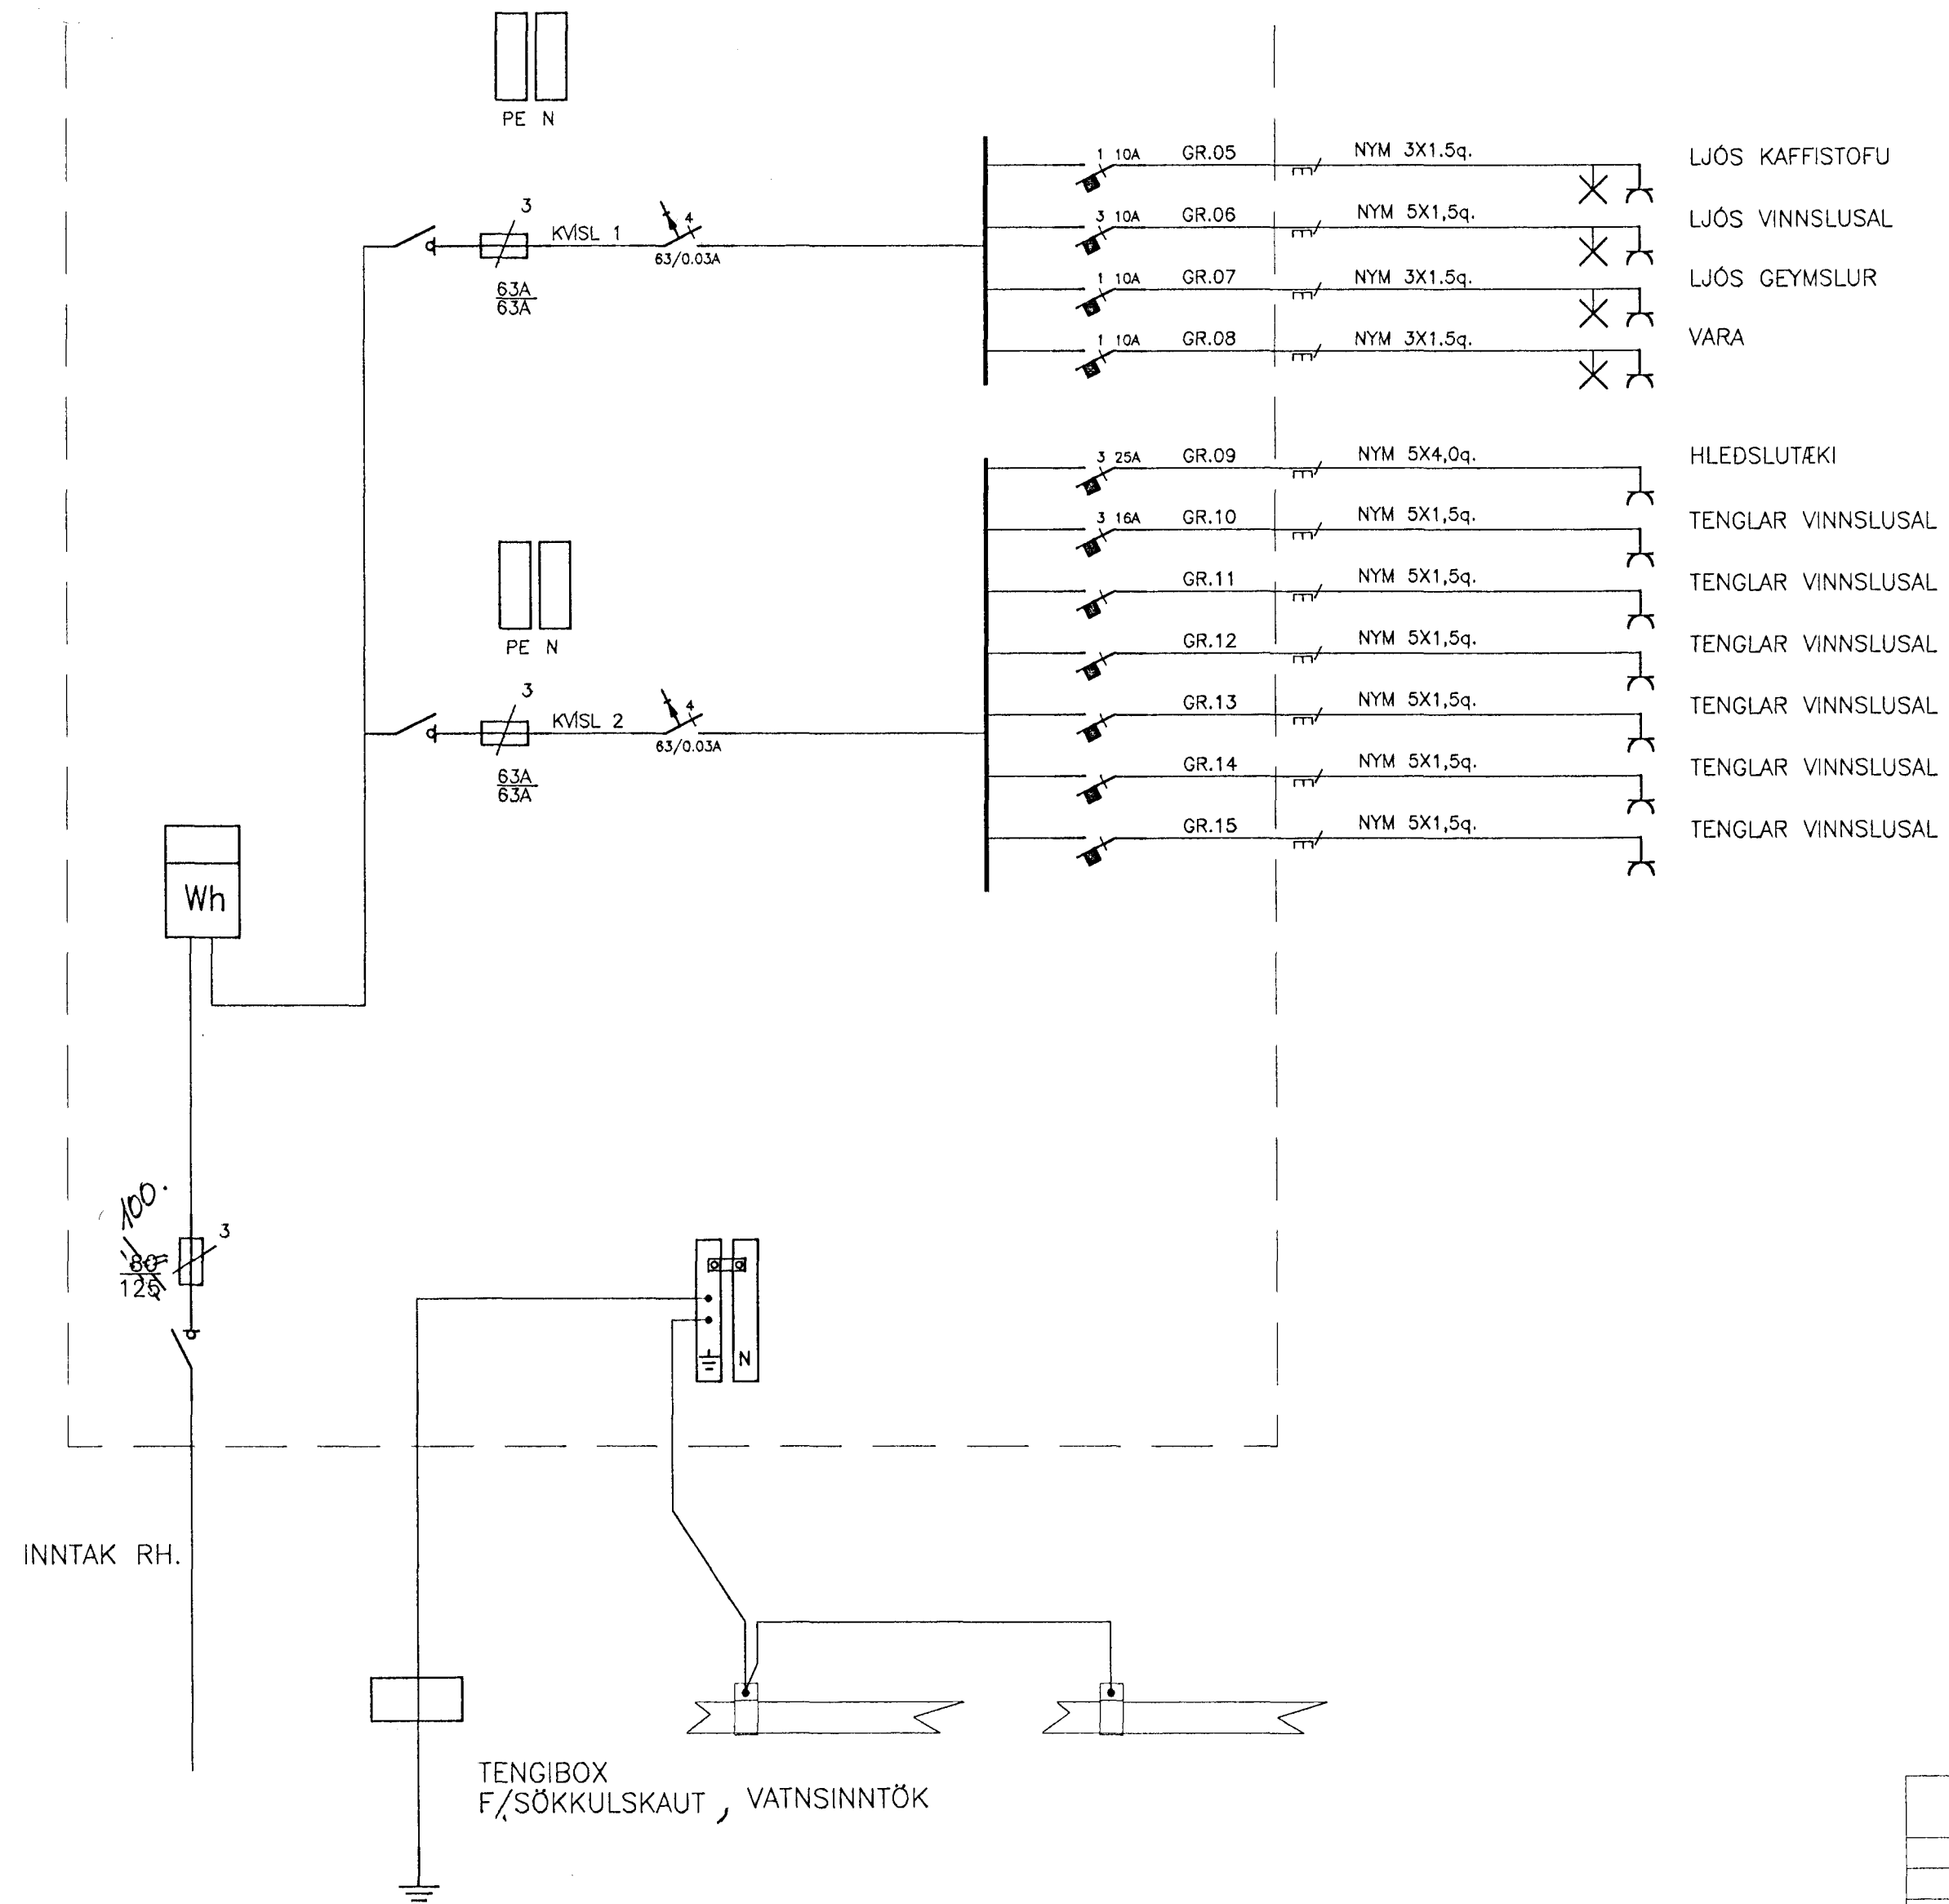

- 1 10A GR.05 NYM 3X1.5q. LJÓS KAFFISTOFU
- 3 10A GR.06 NYM 5X1.5q. LJÓS VINNSLUSAL
- 1 10A GR.07 NYM 3X1.5q. LJÓS GEYMSLUR
- 1 10A GR.08 NYM 3X1.5q. VARA
- 3 25A GR.09 NYM 5X4,0q. HLED SLUTÆKI
- 3 16A GR.10 NYM 5X1,5q. TENGLAR VINNSLUSAL
- GR.11 NYM 5X1,5q. TENGLAR VINNSLUSAL
- GR.12 NYM 5X1,5q. TENGLAR VINNSLUSAL
- GR.13 NYM 5X1,5q. TENGLAR VINNSLUSAL
- GR.14 NYM 5X1,5q. TENGLAR VINNSLUSAL
- GR.15 NYM 5X1,5q. TENGLAR VINNSLUSAL

		VERKEFNI			VERKHLUTI		MKV.
		EYRARTRÖÐ 11, HAFNARFIRÐI			EINLÍNUMYND TAFLA T1.1		ENGIN
		H	05/97	Andrés M.	ANDRÉS MAGNÚSSON SÍMI 555-2253 / 898-2253 KRÖKAMYRI 78, GARDABÆ		SAMP. <i>Andrés Magnússon</i> VERKNR. 130
		T	05/97	Andrés M.			
ÚTG.	BREYTING	DAGS.	NAFN	DAGS.	NAFN		