
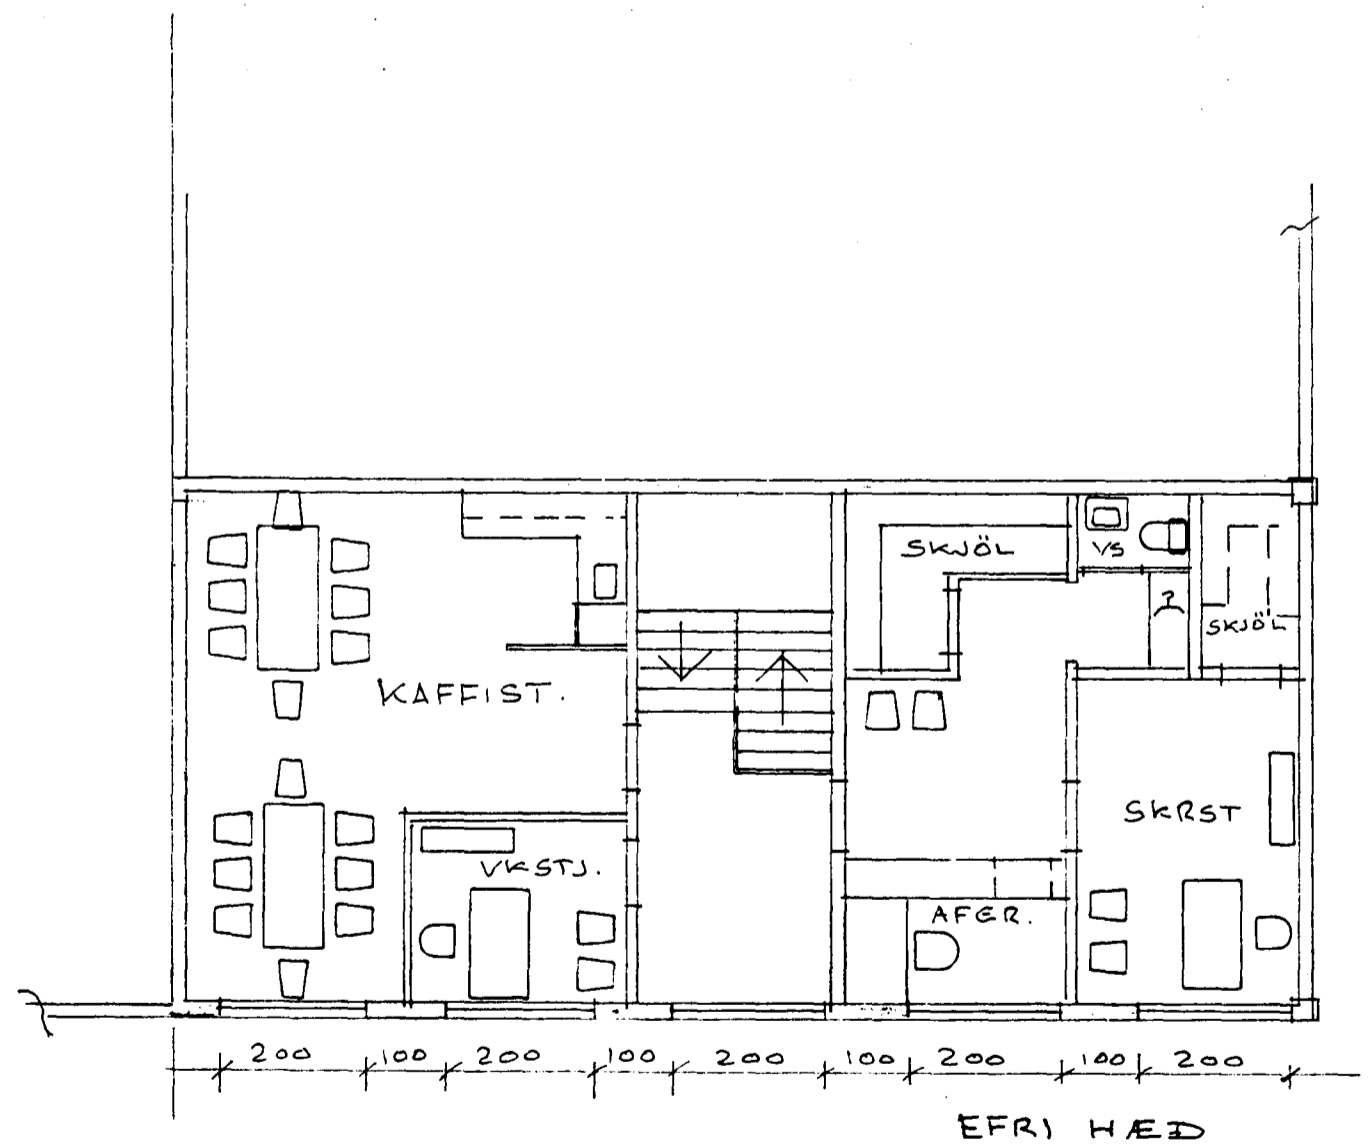


Sampykkt á fundi bygginga-  
nefndar nr. 9 / 10 1986  
BYGGINGAVALUTUN  
Í HAFNARFIRDI

*Einarsson*

Áskild: Samp. brunamálastofn. ríkisins

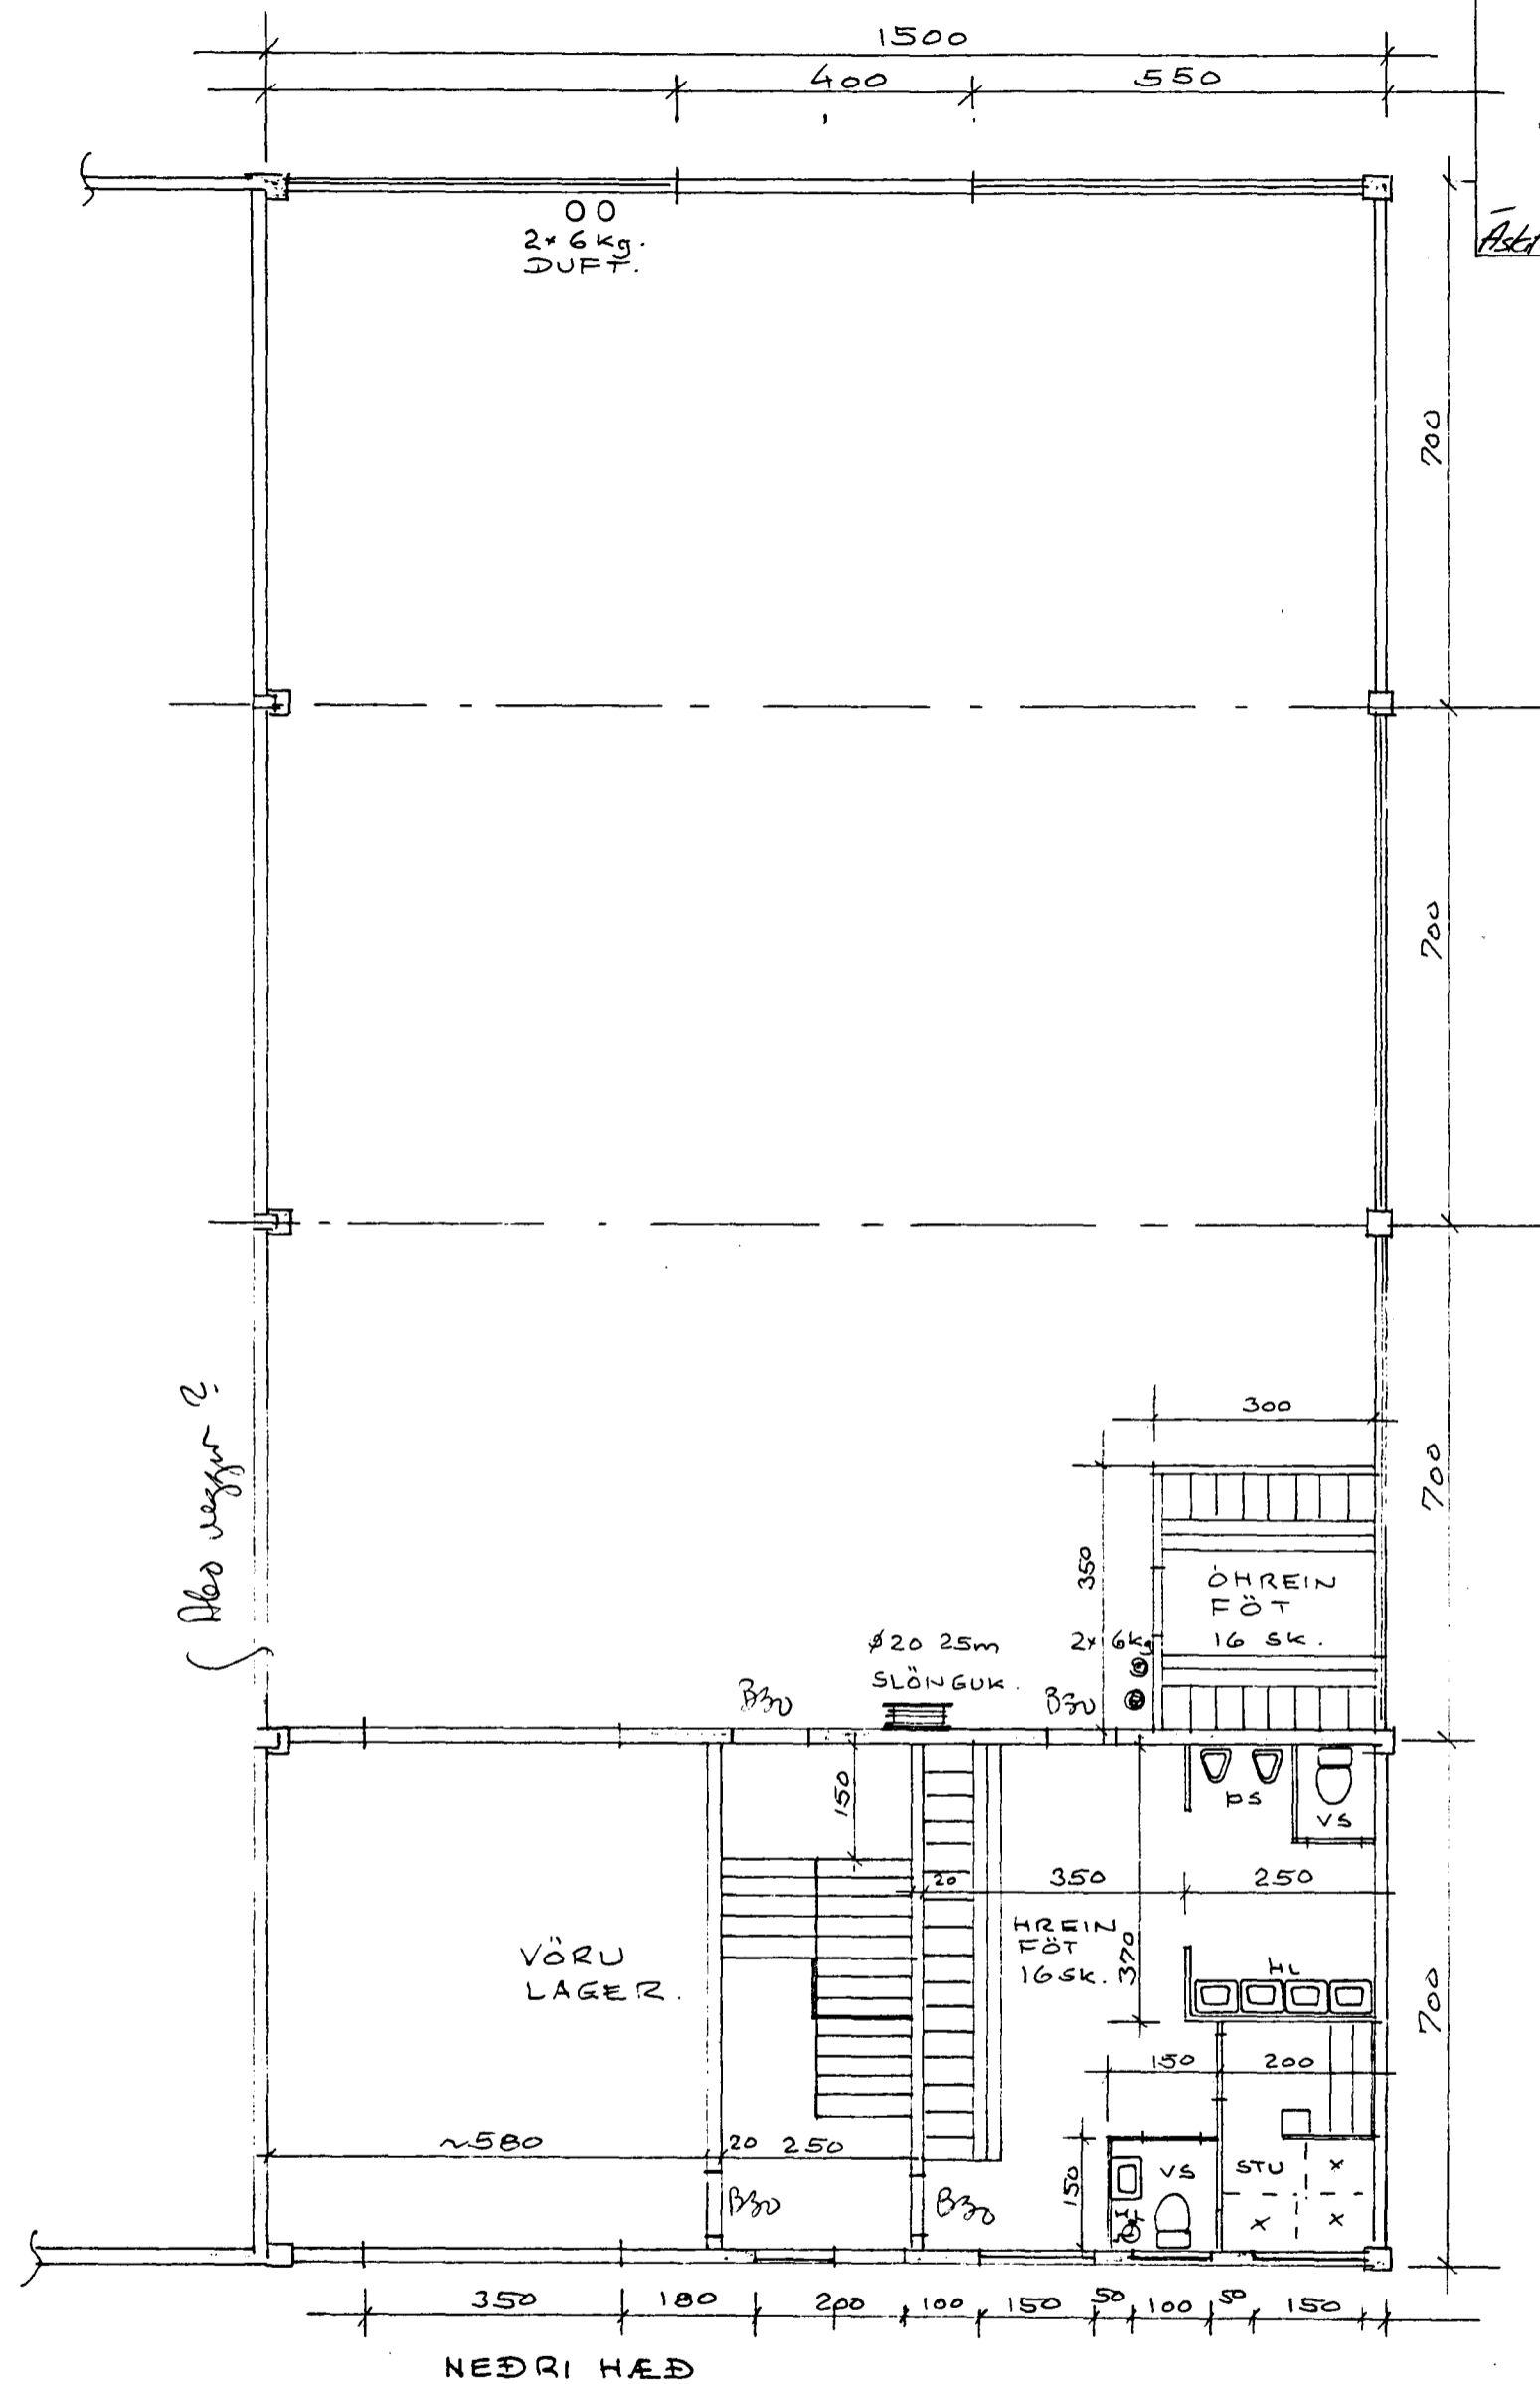

Álva vegur 2

SAMPYKKT 27/11 1986  
SBR BRÉF DAGS. 19

BRUNAMÁLASTOFNUN RÍKISINS  
*Theodor Þorvald*

DAGS	BREYTING		GJORT
HANNAD	JÓN BERGSSON	VERKFR. VERKFRÆÐIHÖNNUN	BLAD.
TEIKNAD	DIPL. ING.	M.V.F.I. SMÁRAHVAMMI 4, HAFNARF. S. 51974	4
YFIRFARID	SAMPYKKT	EYRARTRÖÐ 13	M=1:100
	VERK.	GRUNNMYND	DAGS. SEPT.