




GRUNNMYND, MILLILOFT, 1:100

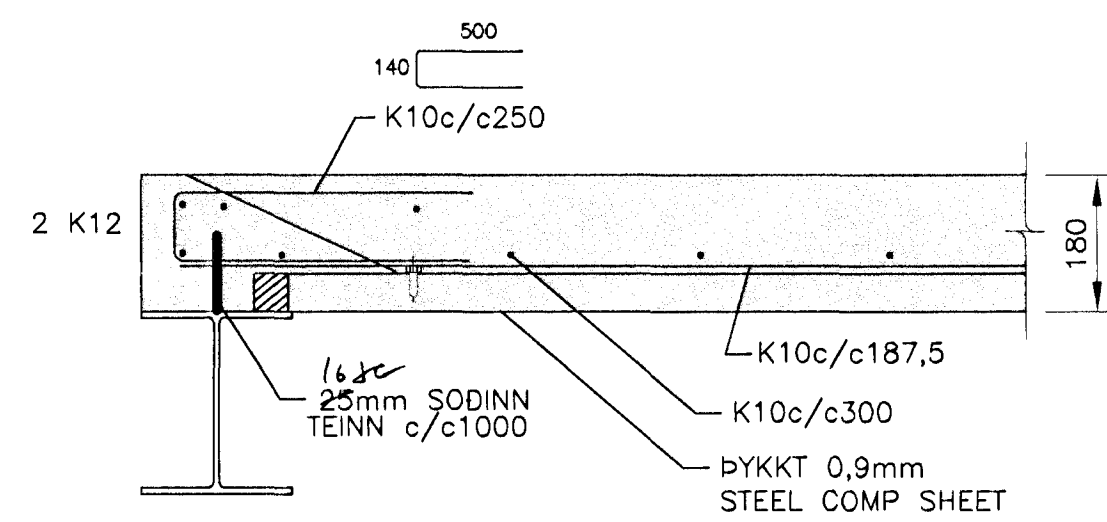

01 SNID
215/215
1:10

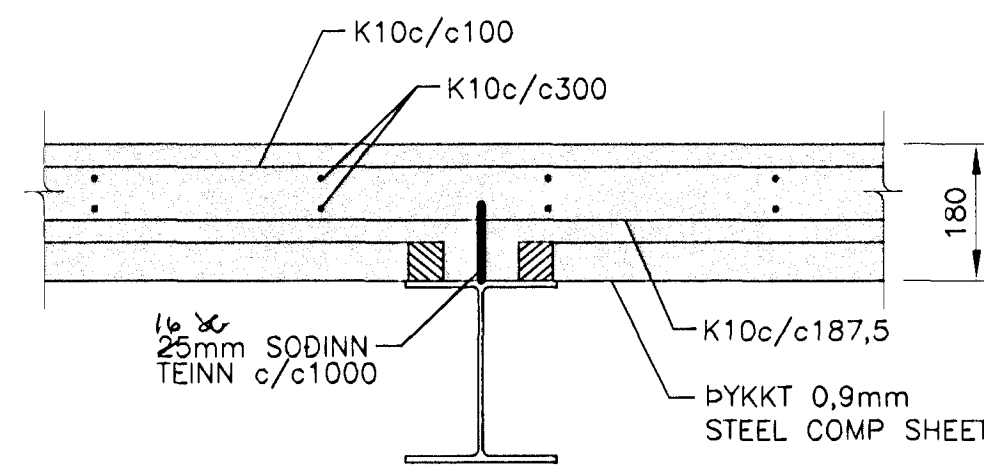


02 SNID
215/215
1:10

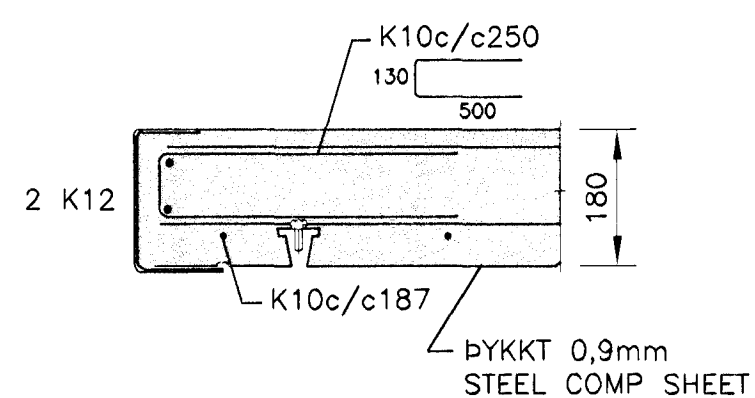

03 SNID
215/215
1:10


DAGS:	NR:	BREYTINGAR:	SAMÞYKKT:

SKÝRINGAR:
STEYPUGEDI C 30
STÁLGAÐI KS 500

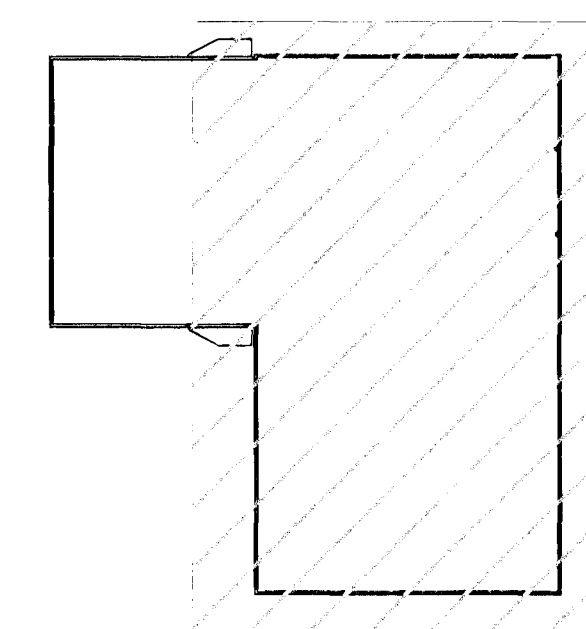

LYKILMYND

Samþykkt þann
20 APR 2001
Byggingafulltrúinn í Hafnarhúsi
Eh. Sigurbjartur Halldórsson

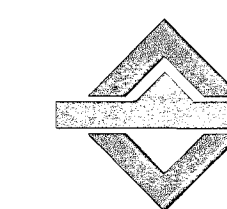

VERKFRÆÐIÞJÓNUSTAN EHF

GARÐATORG 7 · 210 GARÐABÆR · Sími: 544 8600 · FAX: 544 8601 · GSM: 862 8606, 694 3036 · NETFANG: jong@enerhill.is

HEITI VERKS: EYRARTRÖÐ 2a HAFNARFJÖRDUR	VERKNUMER: 00.041	DAGS: 06.04.01	TEIKNINGUMER: 215
FÝRIRSOÐN: BURÐARVIRKI: STEYPT MILLIPLATA GRUNNMYND OG SNID	HÓSAGERÐ: STÁLGR.HÚS	GEYMSLUNR: 215	ÚTGÁFA: B1
TEIKNAD: RMJ HANNAÐ: JG/HH	YRIFARÐI: MÆLT:	SAMÞYKKT: <i>Jong</i>	MÆLI: 1:100/1:10

