


ÖLL LÖGNIN GALV. STÁL EIMANGRAD,
SKV. REGLUG.

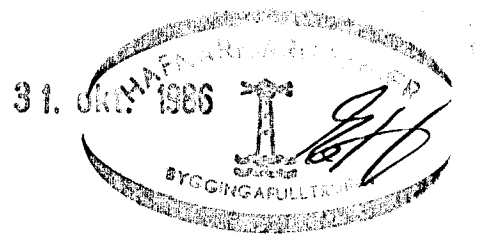

OKT 86	FÆRD LÖGN.		
DAGS.	BREYTING		GIÖRT
HÁNNAD JB	JÓN BERGSSON DIPL. ING.	VERKFR. M.V.F.I. VERKFRÆÐIHÖNNUN SMÁRAHVAMMI 4, HAFNARF. S. 51974	BLAD. 10
TEIKNAD JB	SAMPYKKT	FAGRABERG 22	M=1:~
YFIRFARID JB	VERK.	VATNSLÖGN	DAGS. OKT '65