


uppgefin kvæði.

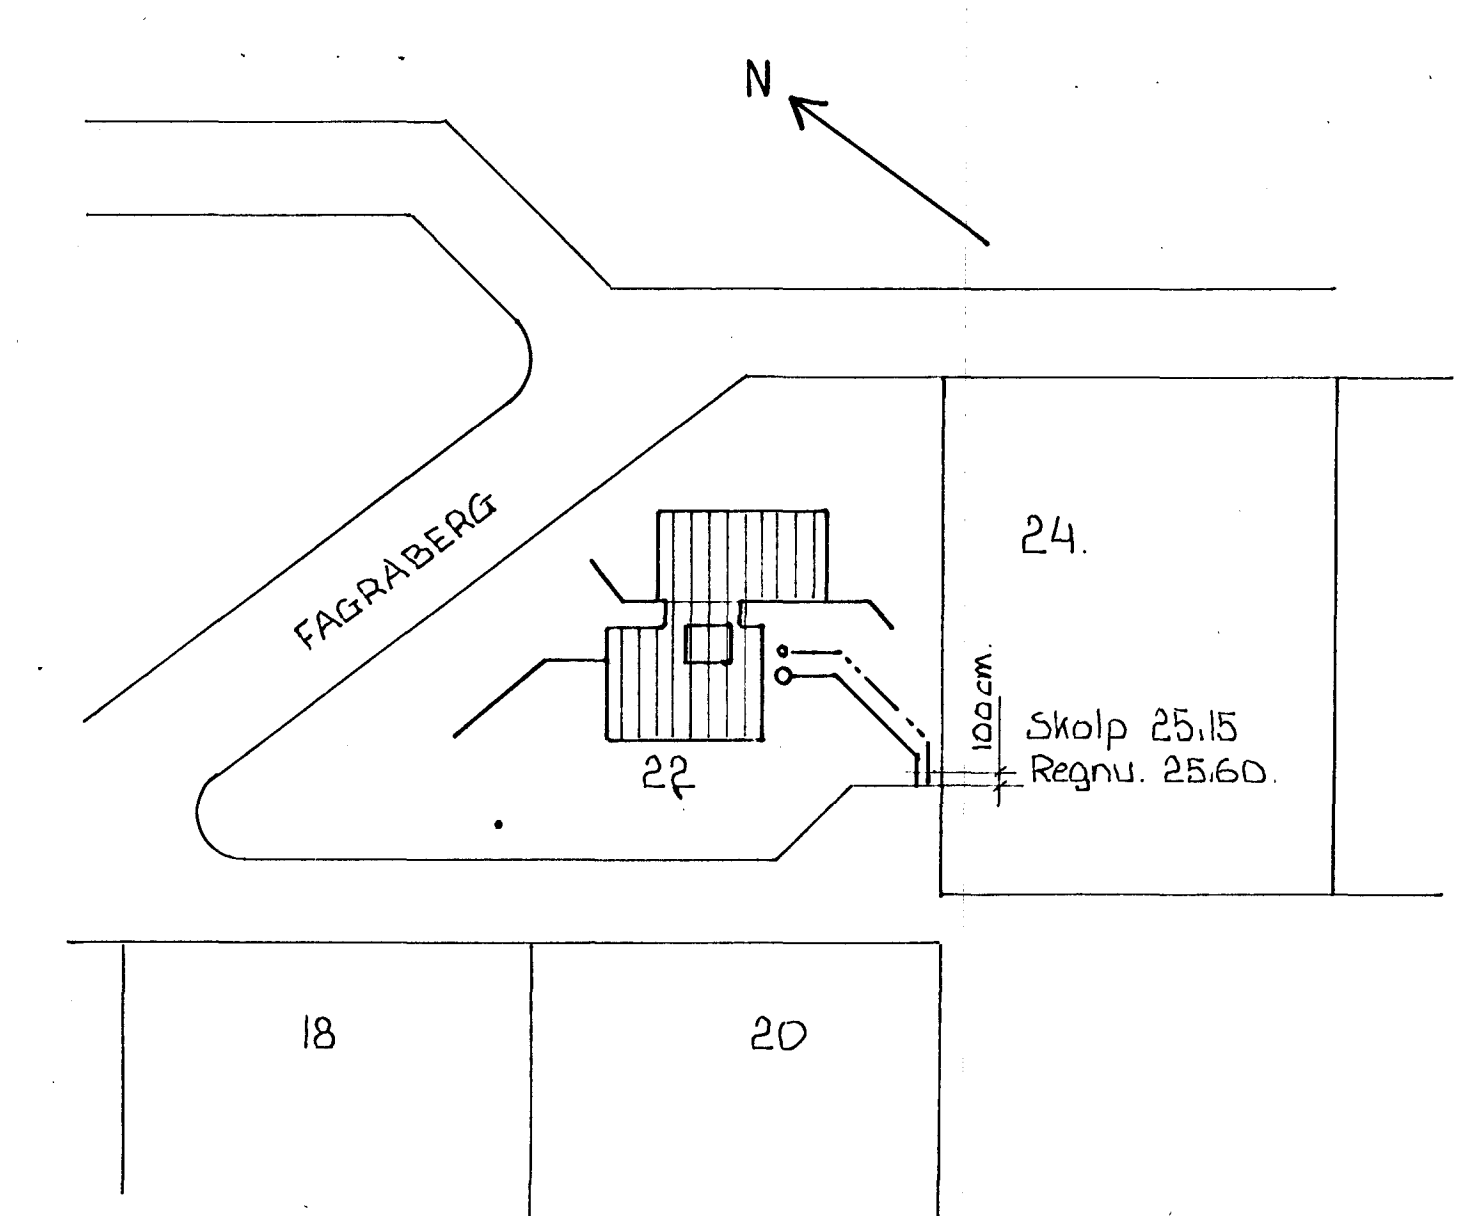

Afstæðumynd 1:500.

21. Jan 1985  
 HAFNARFIRÐI  
 Fagraberg  
 KARL ROSENKJÆR

FAGRABERG 22 HAFNARFIRÐI	
GRUNNMYND KJALLARA	
HREINLÆTISL. Í GRUNNI.	M 1:50, 1:500
KARL ROSENKJÆR FTFI	09-1984