



Samþykkt á fundi bygginga-  
nefndar þ. 17. 11 1988  
BYGGINGAFULLTRÚINN  
Í HAFNARFIRÐI

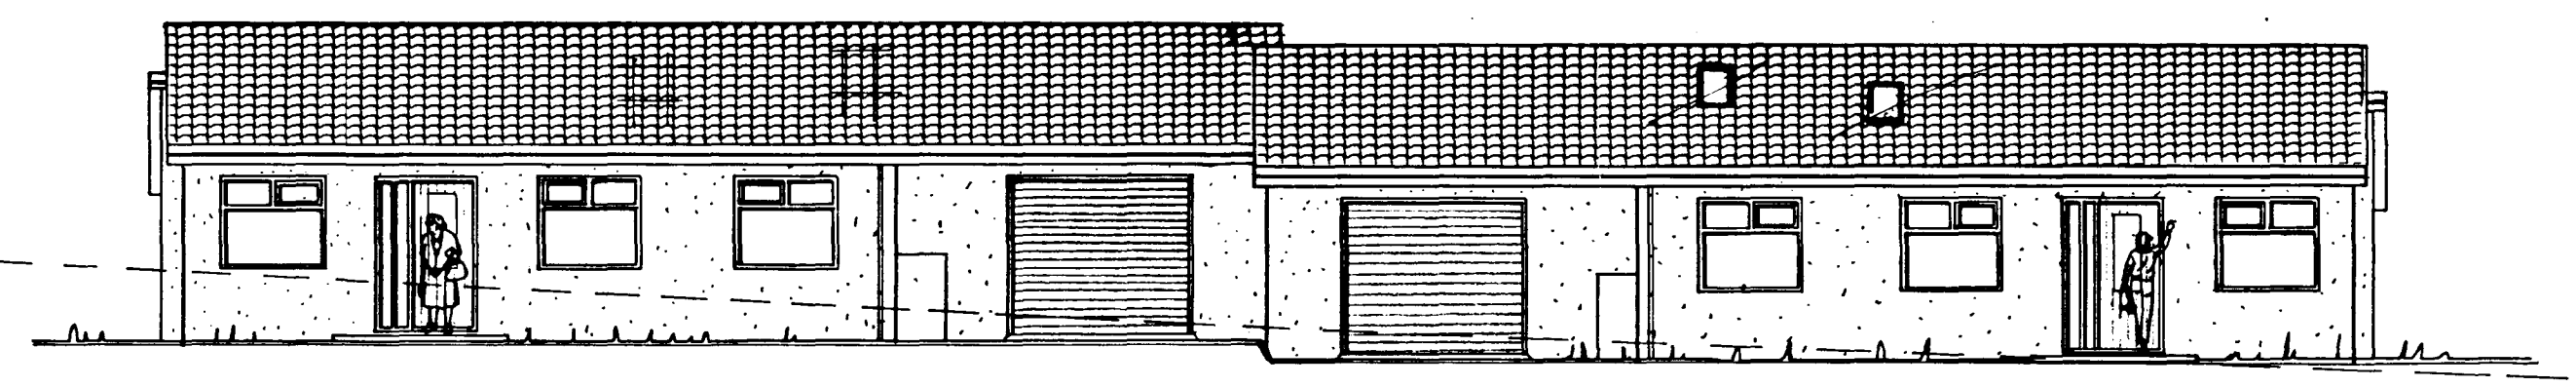


NORD - AUSTUR HLID



SUD - VESTUR HLID

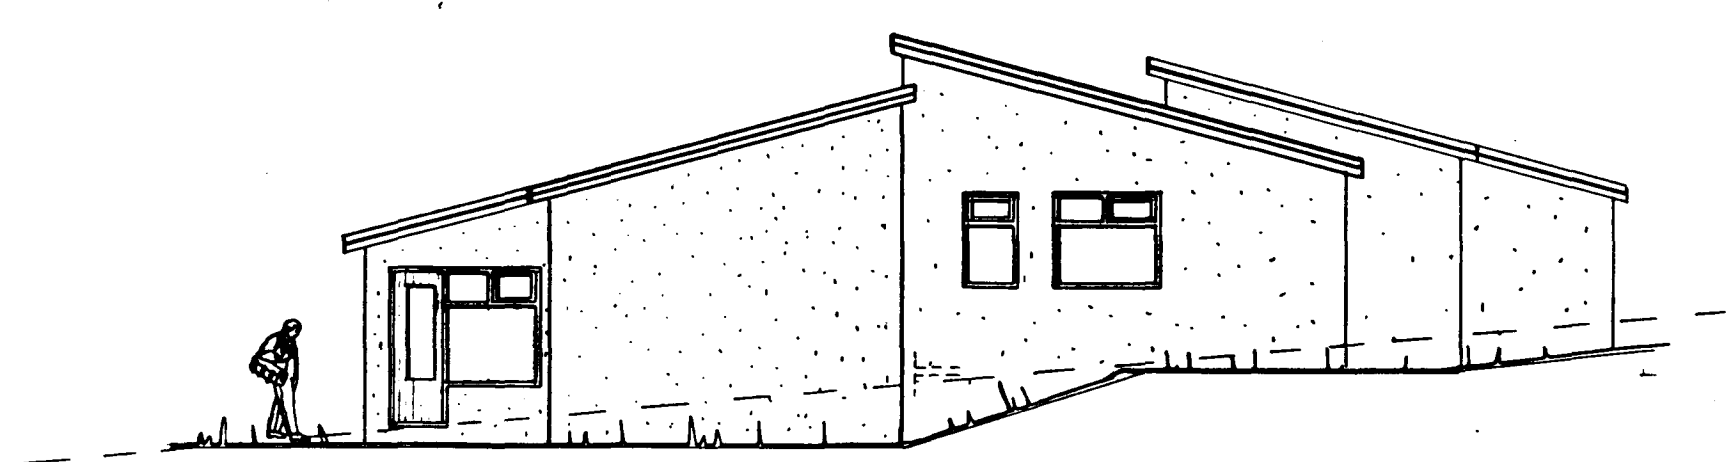

SUD - AUSTUR HLID

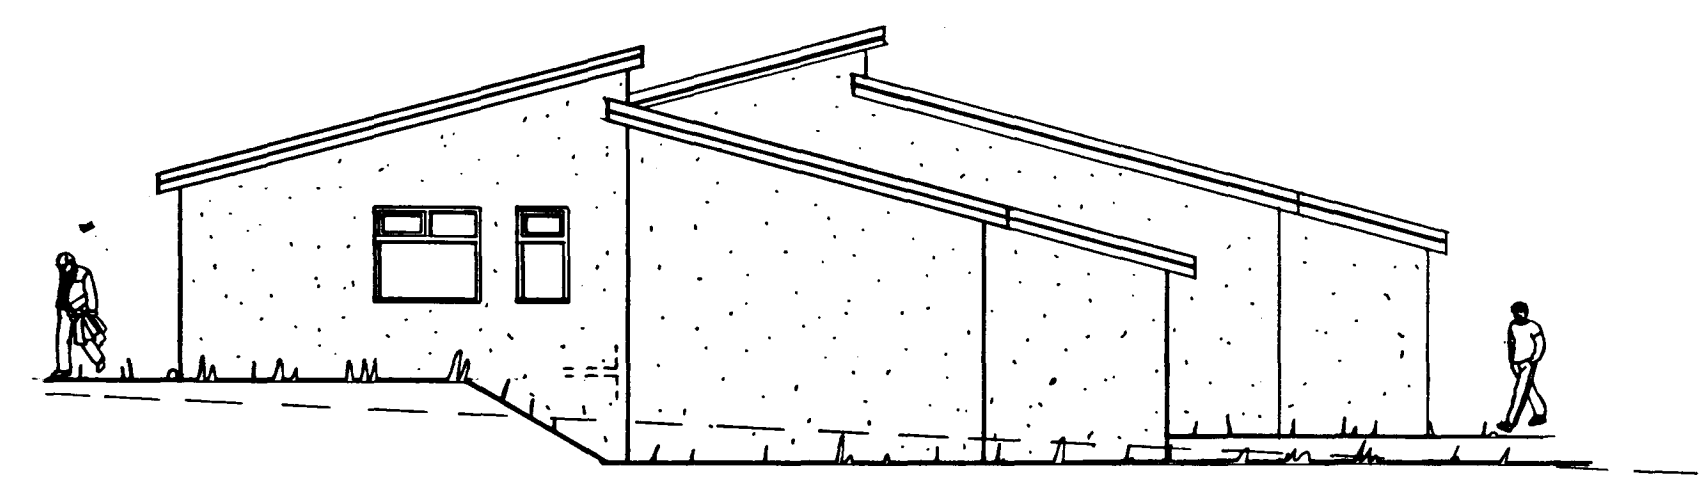

NORD - VESTUR HLID

DAGS: 08.06.10 BREYTT: PARGLUGGAR HÚS NR. 4. *PF.*

*Þorsteinn Fridþjóf*  
**ÞORSTEINN FRIDÞJÓFSSON** F.T.É.  
HRAUNBÆ 4 · REYKJAVÍK · SÍMI 82735.  
FAGRABERG 2-4, HAFNARFIRÐI  
ÚTLITSMYNDIR · MKV. 1:100 · TEIKN. NR. A 02 · MARS 1987.