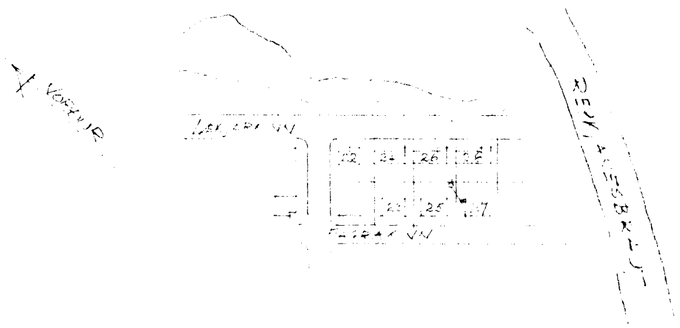

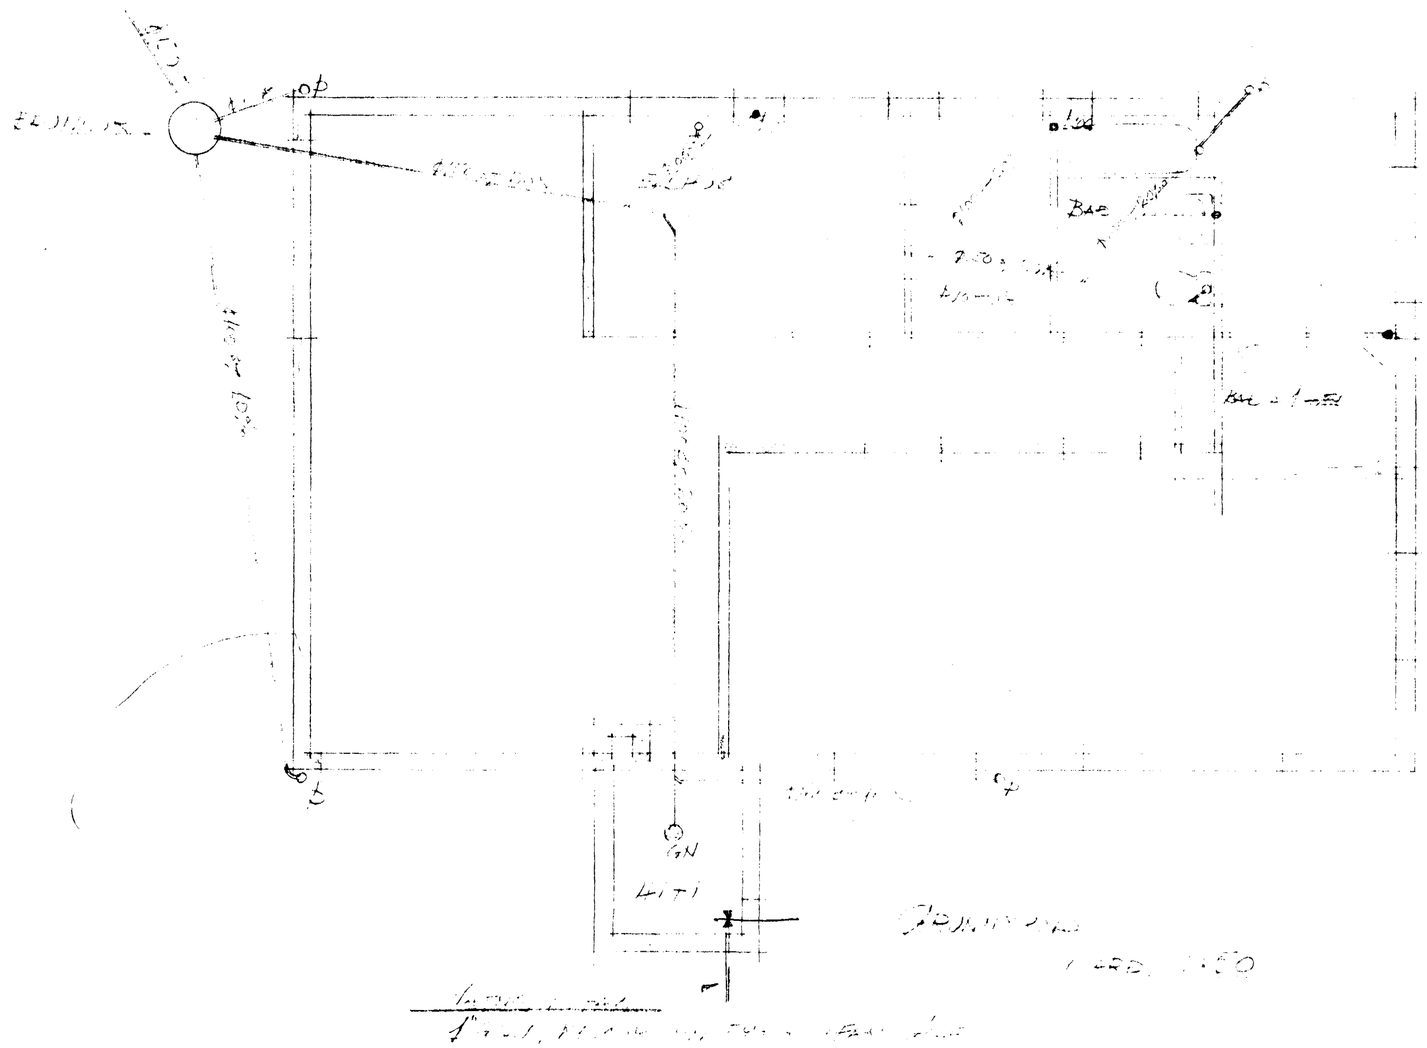

Photo 27