



AFSTÖÐUMYND M.1:500

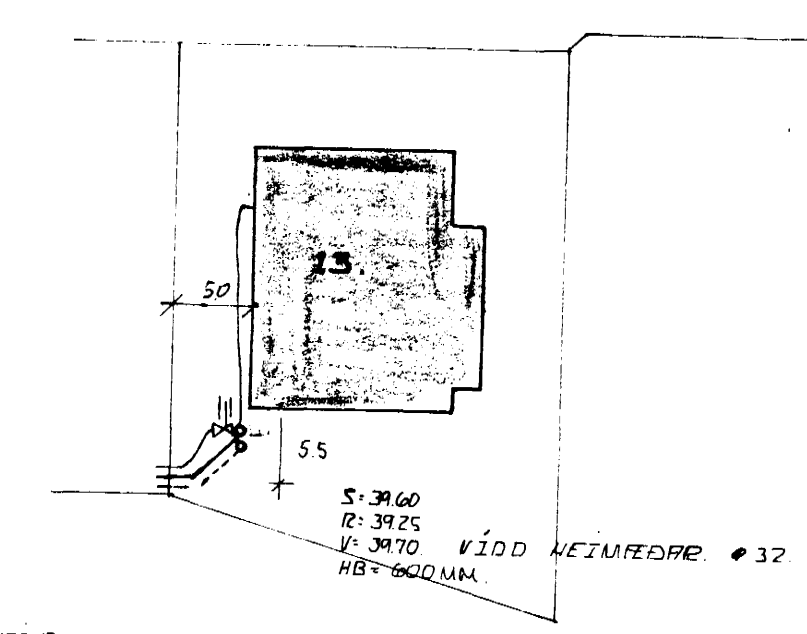

ALLT EFNI OG FRÁGANGUR STEINLAGNA SÉ SKU. HÖLDRESÞREGLUGERÐ SVEITRÆFELAGSINS. EFNI OG FRÁGANGUR PLASTLAGNA SÉ SAMK. ISL. STAÐI

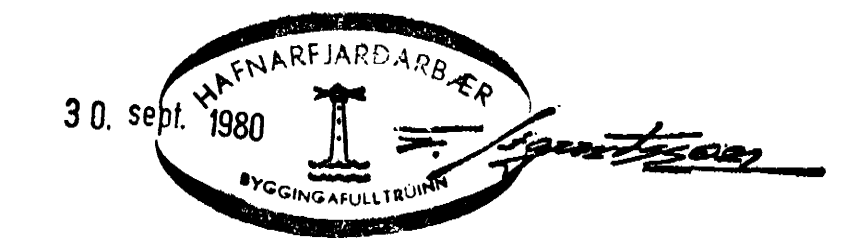

DAGS.		BR.		BREYTING VARDAR:		SIGN	
				FRÁRENNSLISLAGNIR.			
				VATNSLAGNIR I JÖRÐ.			
TEIKN:		49.		REIKN:			
YFIR:		Linn		DAGS:		30/6/80	
SAMP:				DAGS:		30/6/80	
SÆVAR GEIRSSON		BYGGINGARTEKNIÐI		M.T.F.I. S. 77816.		BLAÐ 5.0	

49
48
