


GRUNNMYND • 1:100

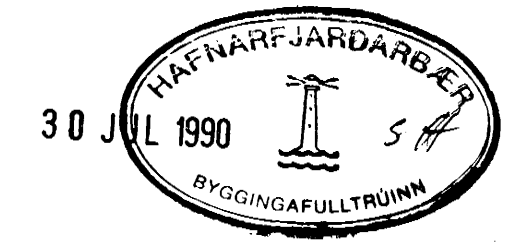

DR NR	DAGS	EDLI	BREYTINGAR	SIGN.
01	JUL 90	BETT VÍÐ LÖGNUM Í SILGEYMSLU		
FAGRIHVAMMUR 2 ABC, HAFNARFJEDI				DAGS
GRUNNMYND GRUNNLACNA.				MÁÍ 88
MELIKV. 1:100				TEIKNAR
SIGURÐUR ÞORLEIFSSON TEIKNIÞÆBINGUR F.T.F.I.				VERK NR
STRANDGÖTU 11 HAFNARFJEDI SÍMI 54751				8812
				BLAD NR
				2-02 A