


SUÐUR Mkv. 1:50

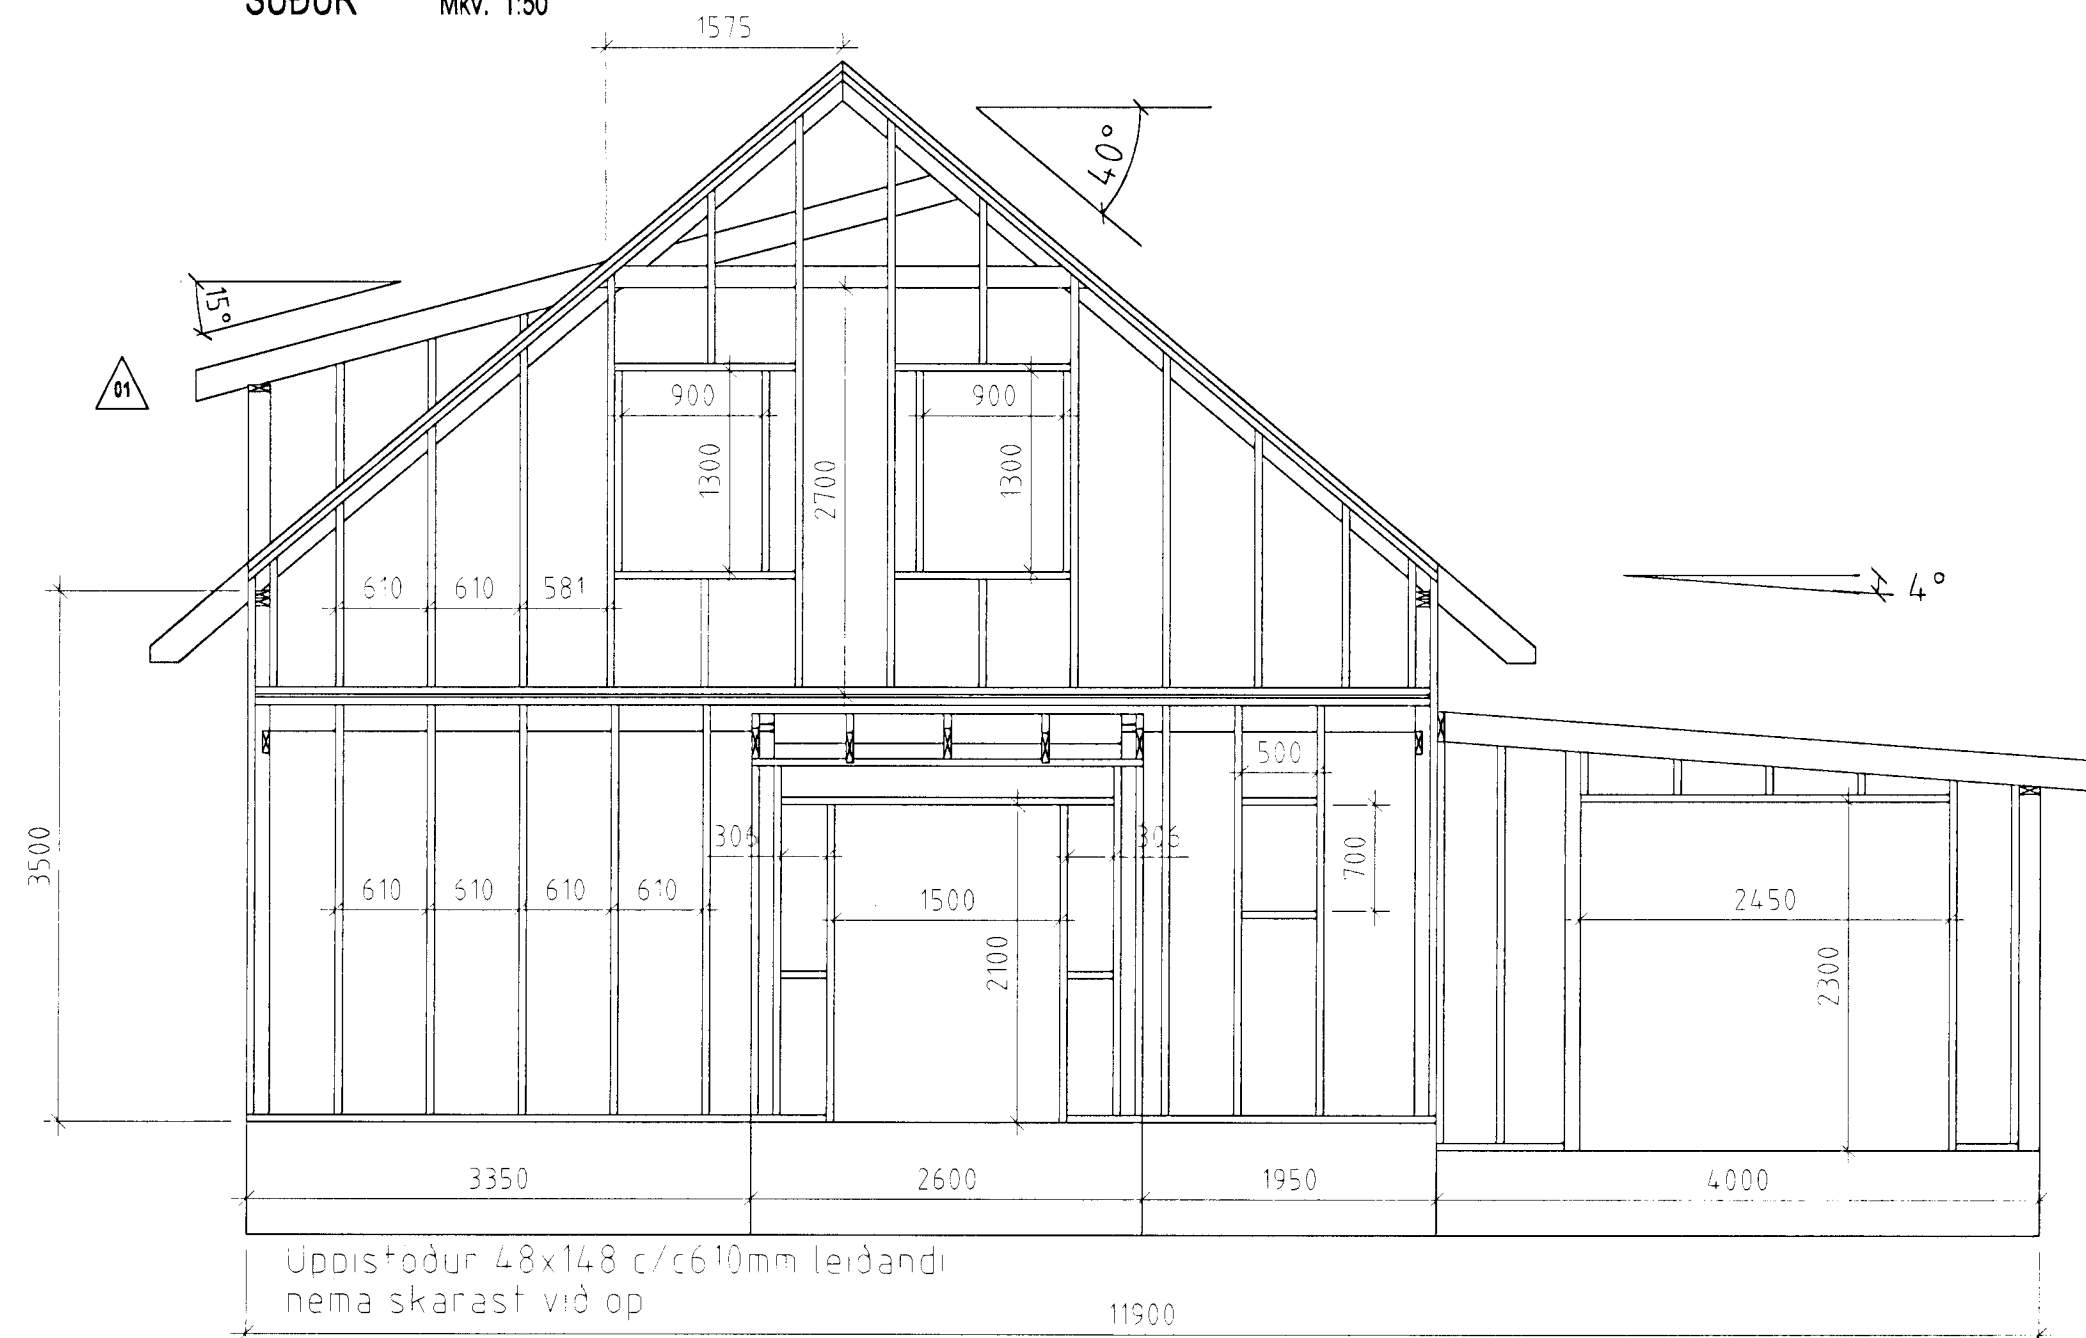

AUSTUR Mkv. 1:50

Skýringar:
 Sperrur T24 48x198mm
 Gólfbitar T24 48x222mm
 Grindaefni T18 48x148mm

Breytingar.		
Nr.:	Lýsing:	Dagss.:
01	Kvistur á suðurlhlíð	16-06-99
02		

Dagss: 20-11-98
 Kvarði: 1:50
 Hannað: STJ Yfirfarið: STJ
 Teiknað: BAR
 Teikning nr. B0.0
 Burðarvirki

Fálkakraun 10 Hafnarfirði

GRAVIS ehf.
 Kt:650398-3519
 Kaplahrauni 15 220 Hafnarfirði
 s:555-3783 fax.555-2873



Stefán Jörundsson TFI kt. 230145-7099