


Efnislisti:
 Sperrur T24 48x198mm
 Hanaband T18 38x145mm
 Gólfbitar T24 28x222mm
 Grindarefni T18 48x148mm
 Blikkstodir "U" skúffur 40x140mm
 Sperrur T24 48x198mm c/c610mm, leiðandi

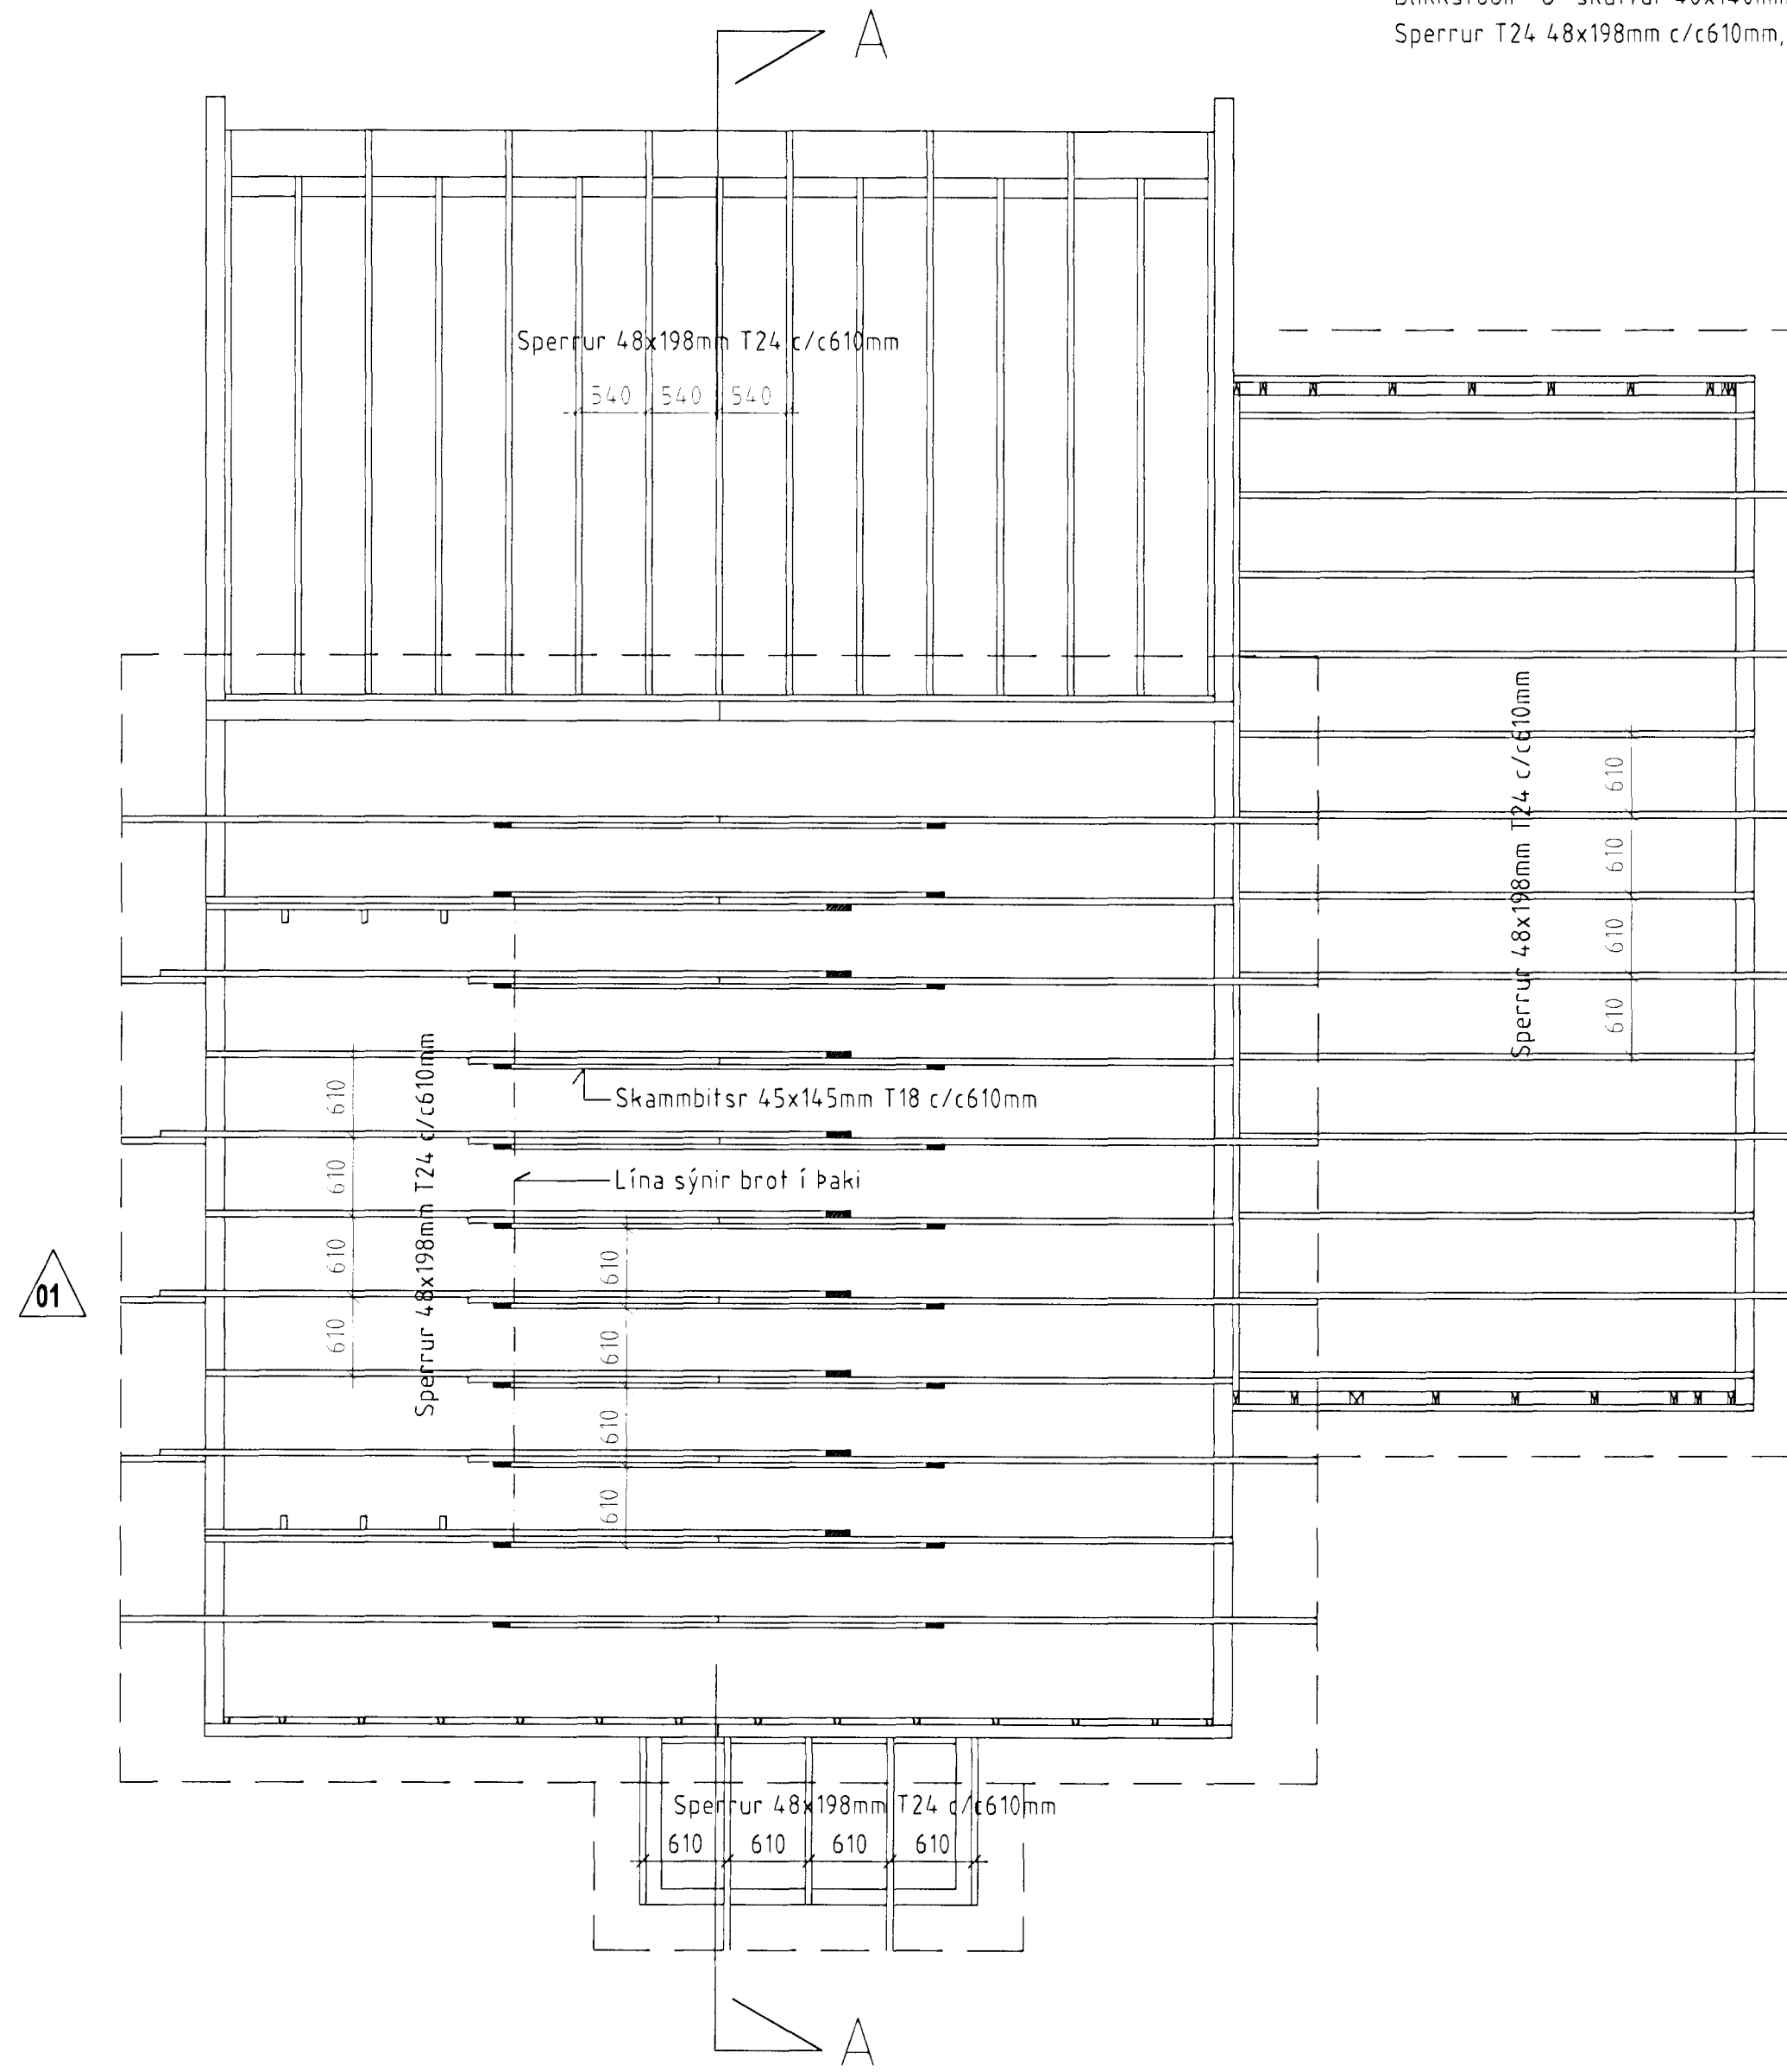

Sperrur

Mkv. 1:50

Breytingar.

Nr.:	Lýsing:	Dagss.:
01	Kvistur á suðurhlíð	16-06-99
02		

Dagss: 20-11-98

Kvarði: 1:50

Hannað: STJ

Yfirfarð: STJ

Teiknað: BAR

Teikning nr. B0.3

Burðarvirki, Sperrur

Fálkakraun 10 Hafnarfirði


GRAVIS ehf.

Kt:650398-3519

Kaplahrauni 15 220 Hafnarfirði

s:555-3783 fax.555-2873

Stefán Jörundsson TÍÍ kt. 230145-7099

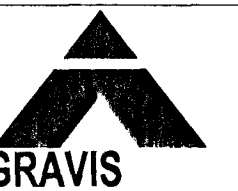

Stefán Jörundsson