
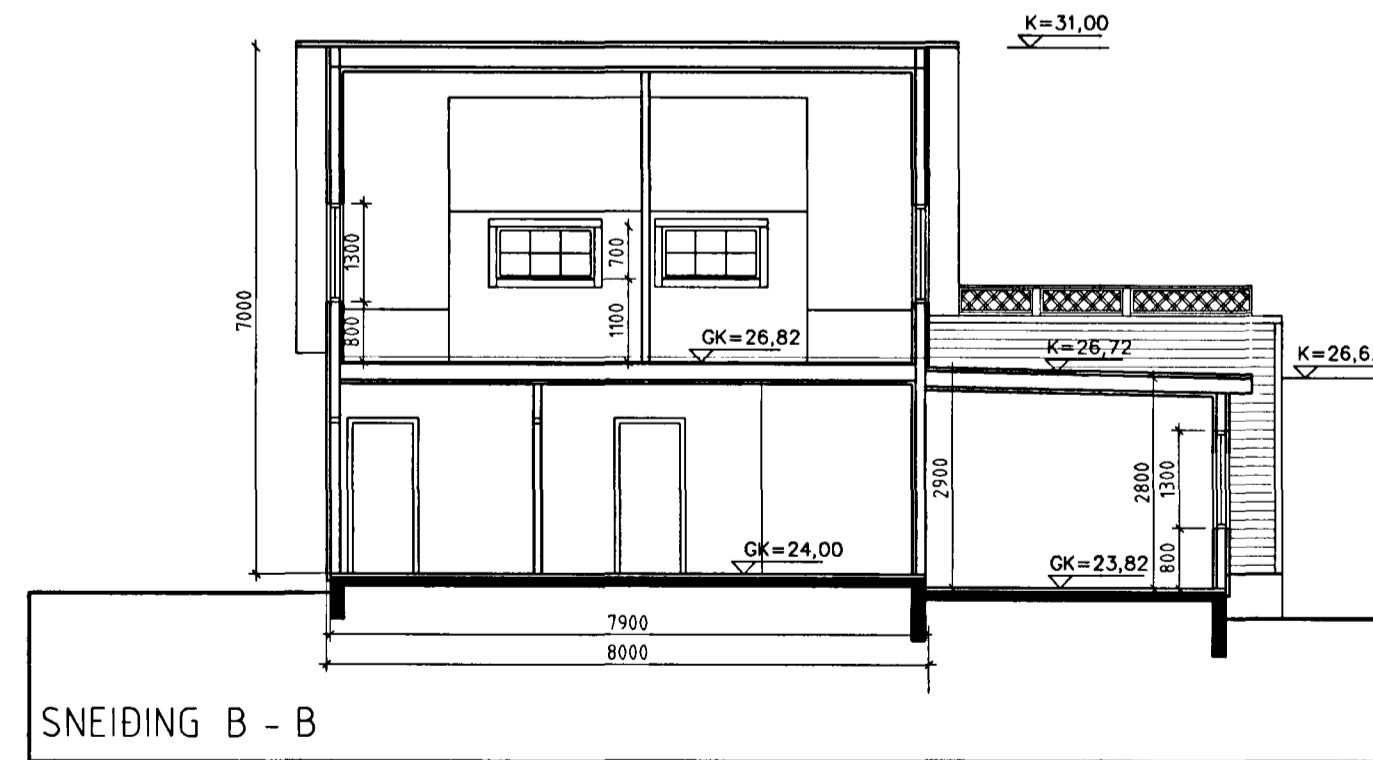
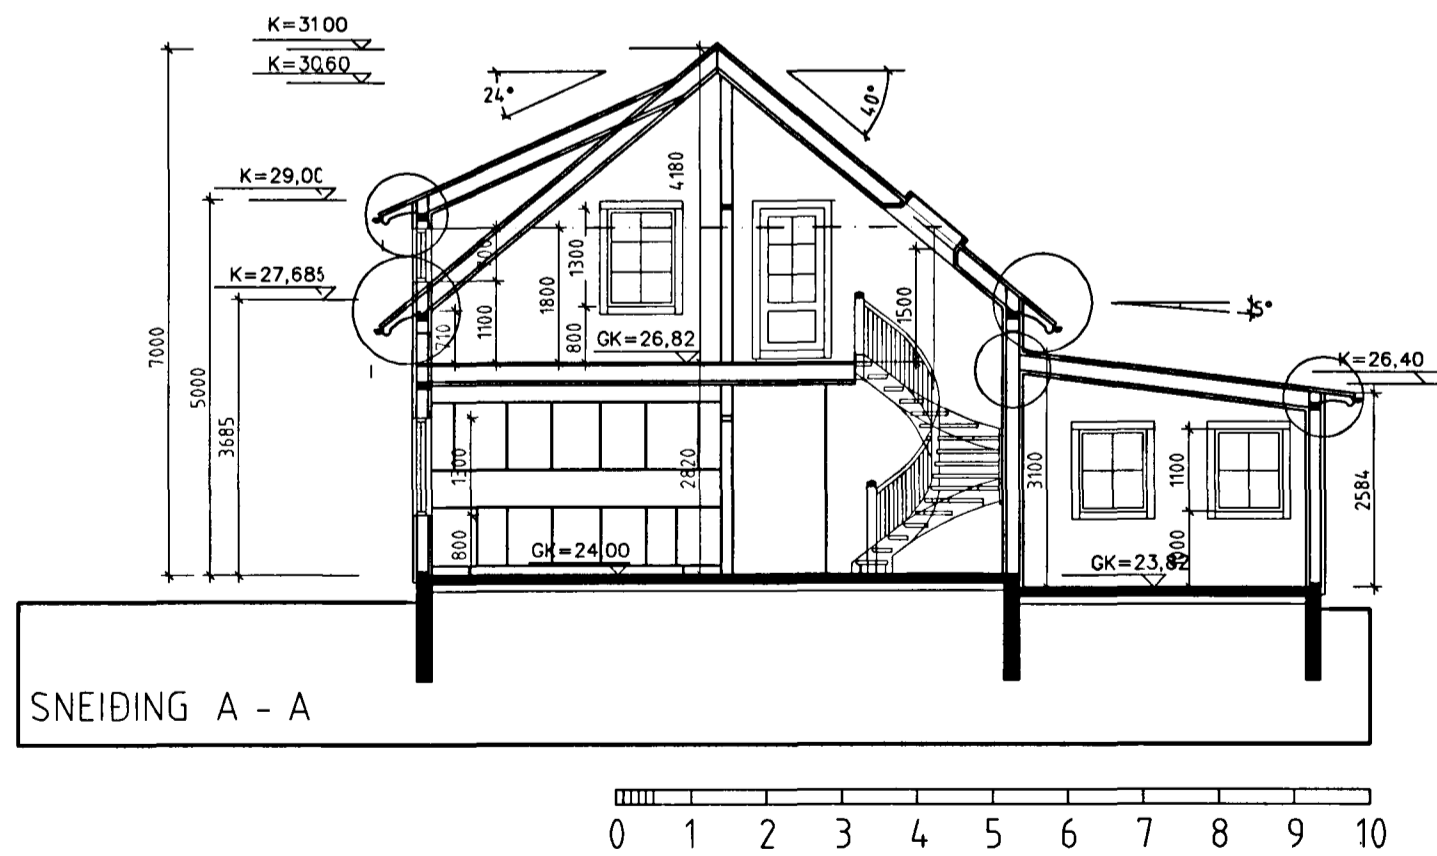
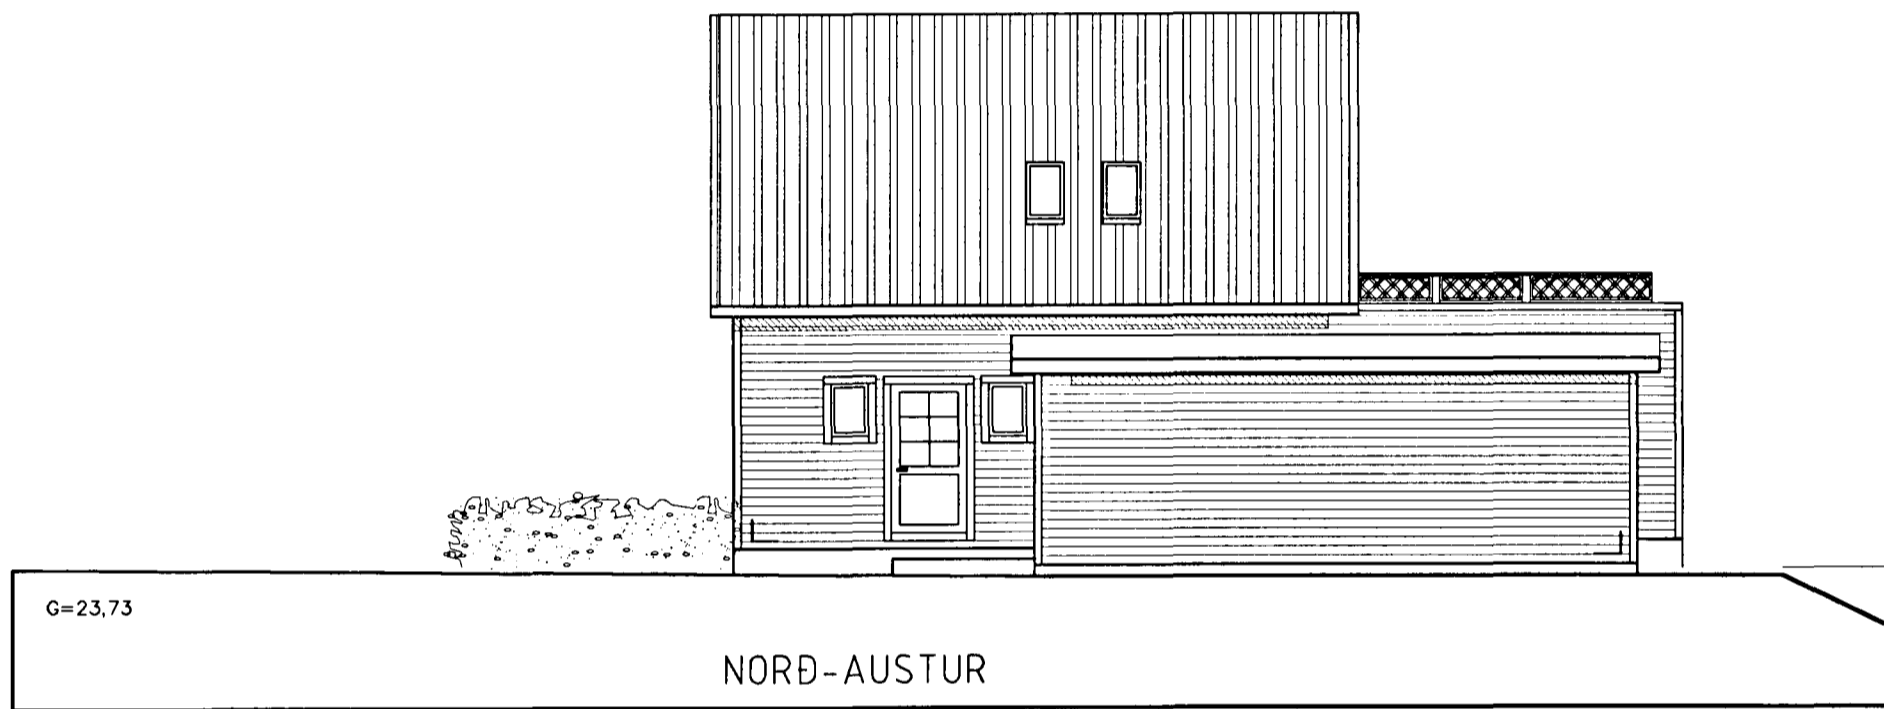
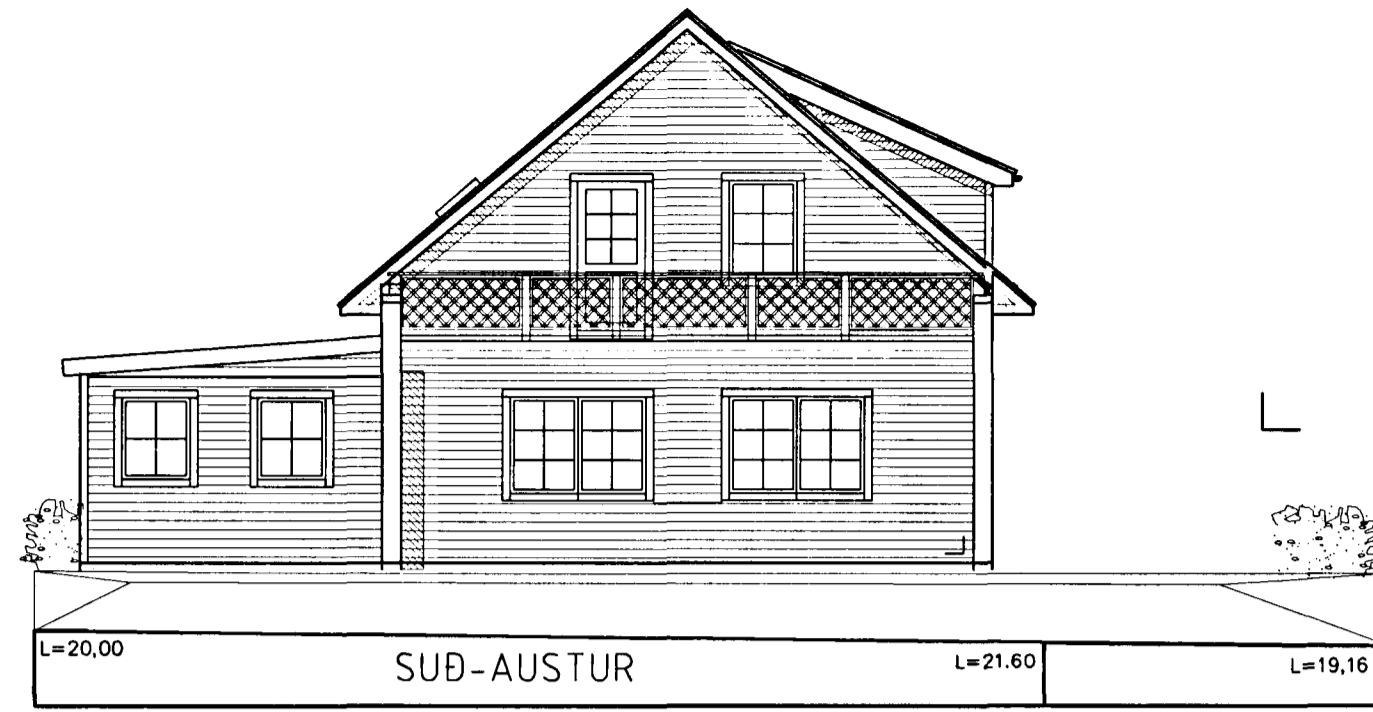


 Erlendur Hjartarsson

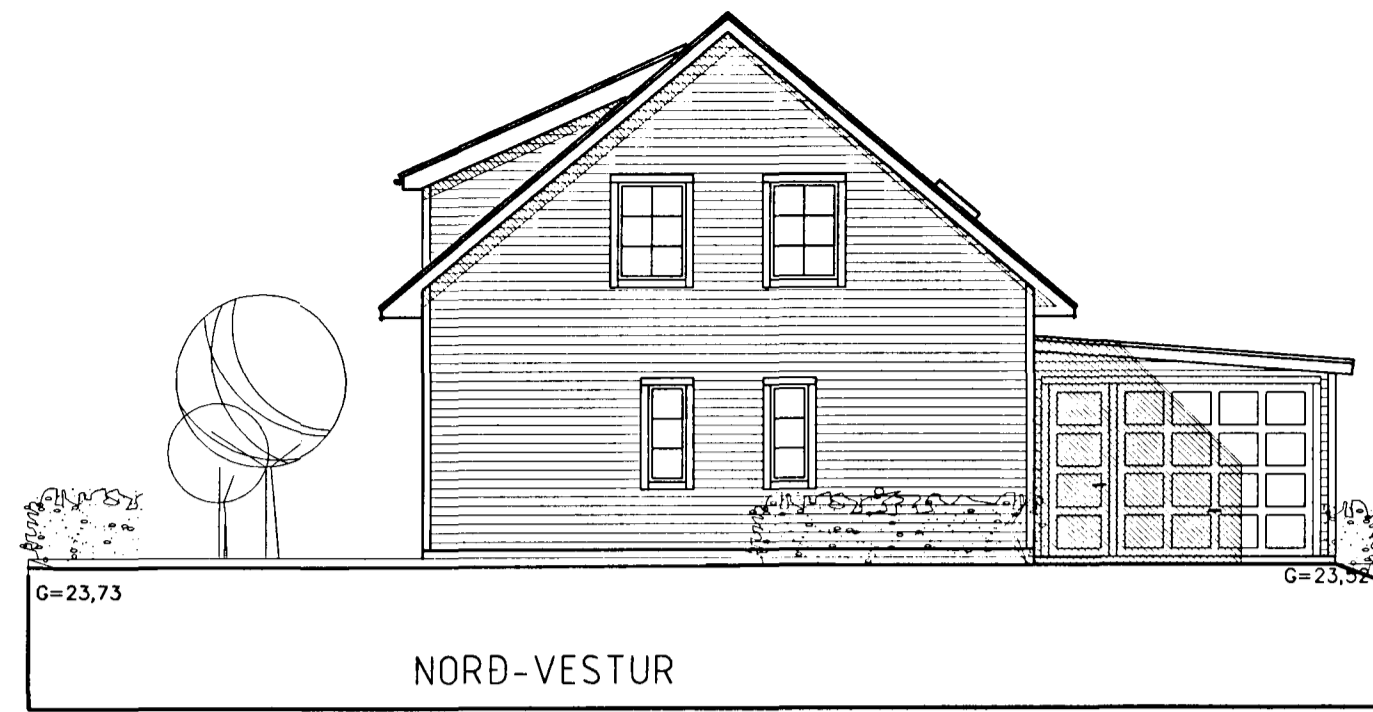

FF 10.02.99 FF SVALIR SETTAR Á VIÐBYGGINGU  
 FF 08.05.99 FF ANDDYRI OG BADI BREYTT, BAD STÆKKAD OG GLUGGA BÆTT VIÐ Á BÍLSKÚR  
 breytt dags. teiknað lýsing

SNEIDINGAR  
 verknr.: hannað/teikn: FF mkv: 1/100 dags: 25.08.1998

TEIKNISTOFAN THAK FRIBRIK FRIBRIKSSON DRÆTTIKT F.Á.Í, 212.56-4519, FFARÍK @ SLANDIAIS  
 KLAPPARSTÍG. 10, 101 REYKJAVÍK, Sími 55110 60, FAX 55110 66

17.09.99 Haukursson

102  
 FÁLKAFRAUN 8  
 ÚTLIT