

VESTUR Mkv. 1:50

Skýringar:


Efnislisti.

Sperrur T24 48x198mm á lágbyggingar

Sperrur T24 48x198mm á risþak

Gólfbitar T24 48x222mm

Útveggjagrind T18 48x148mm

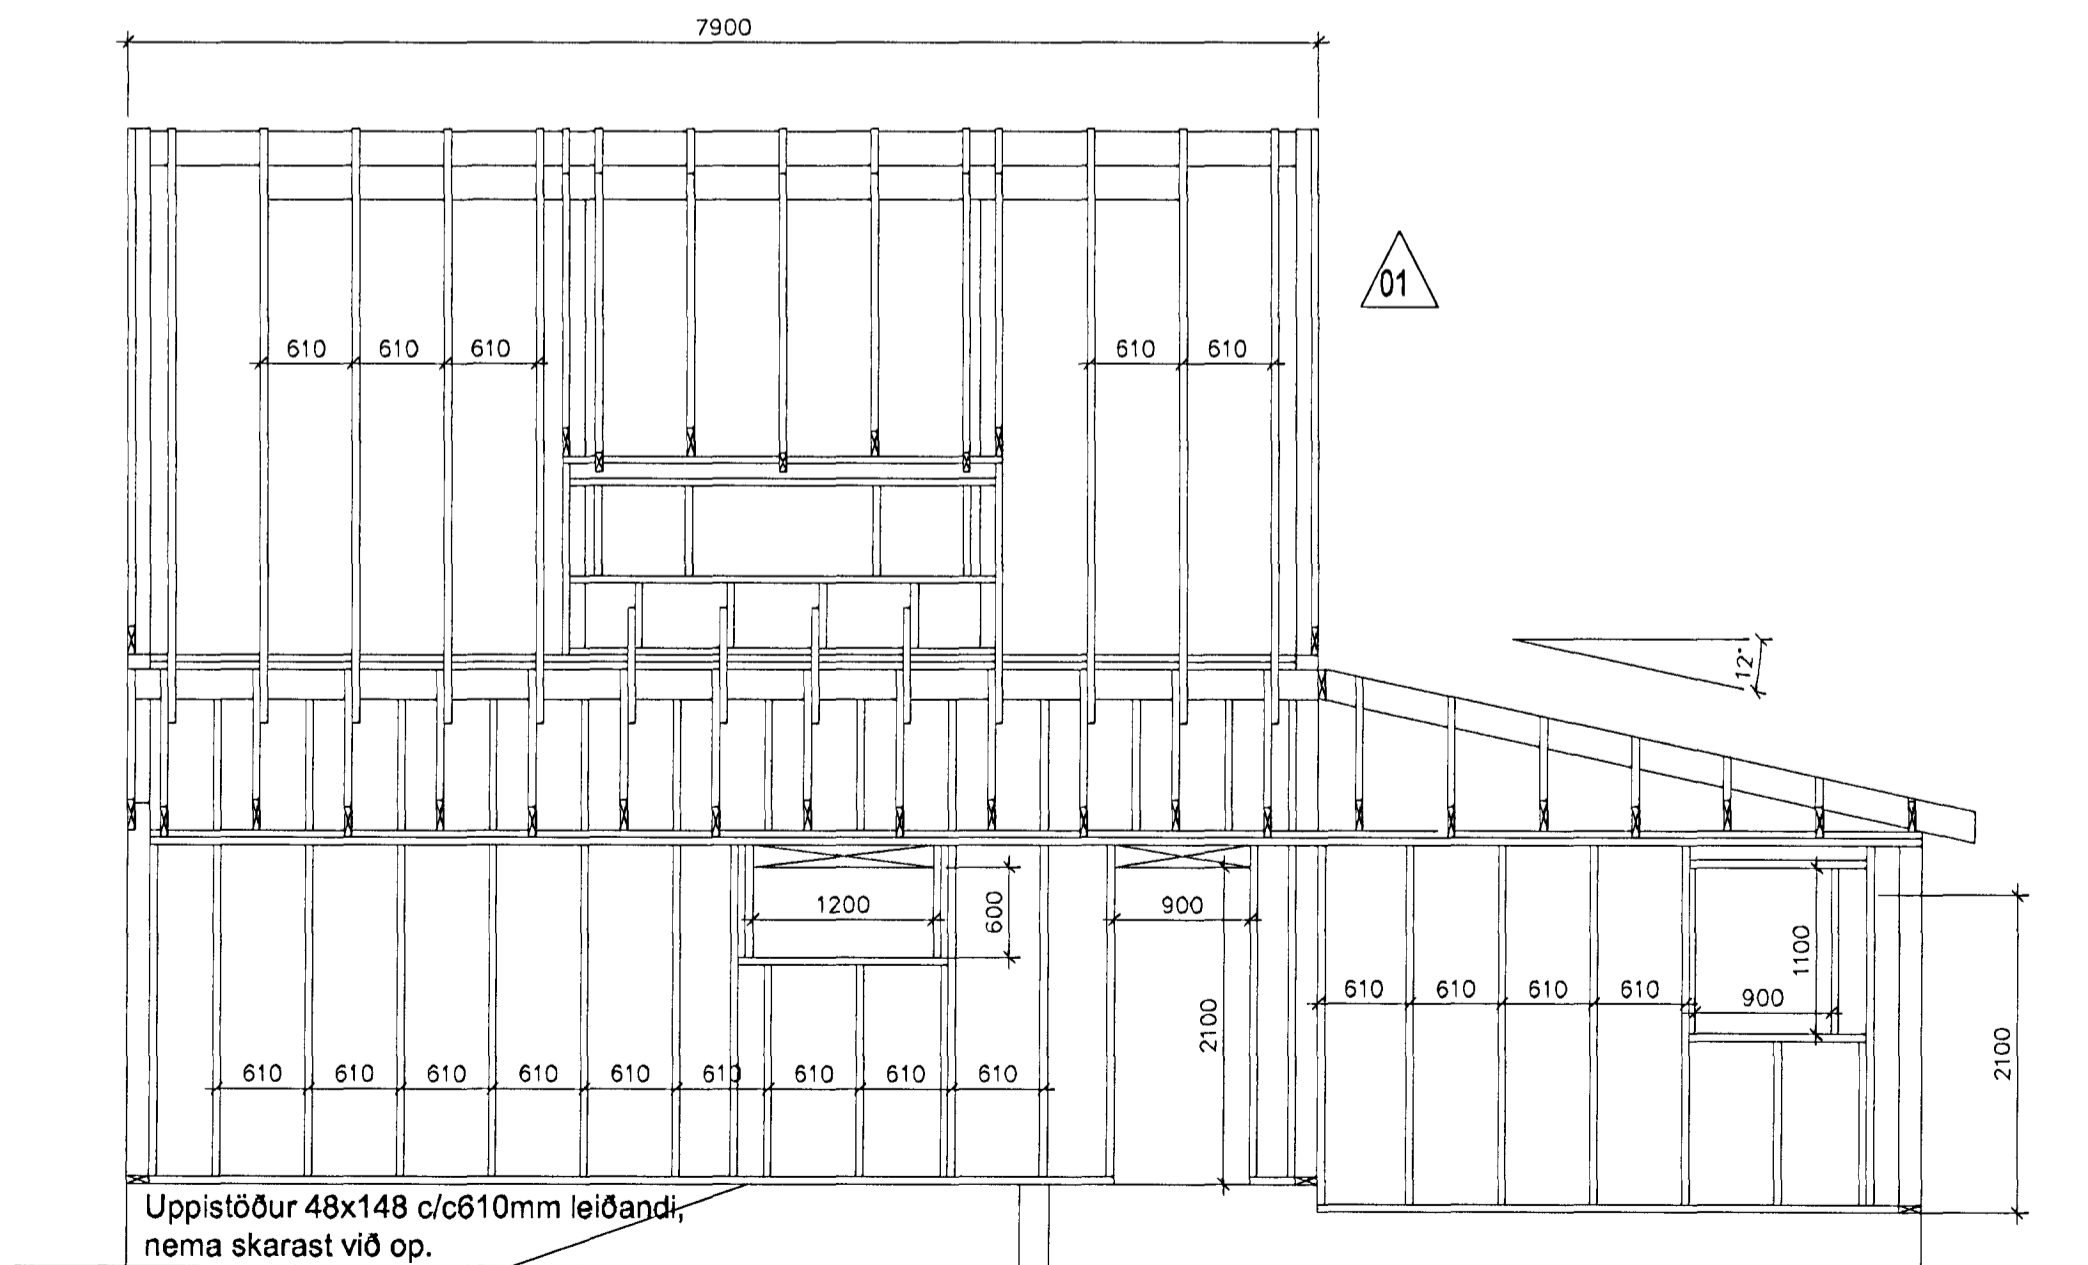

NORÐUR Mkv. 1:50

Breytingar.

Nr.:	Lýsing:	Dagss.:
01	Kvistur á Norðurhlíð	20.04.2000
02		

Dagss: 17-09-99


Kvarði: 1:50

Hannað: STJ

Teiknað: BAR

Teikning nr.B3.1

Burðarvirki

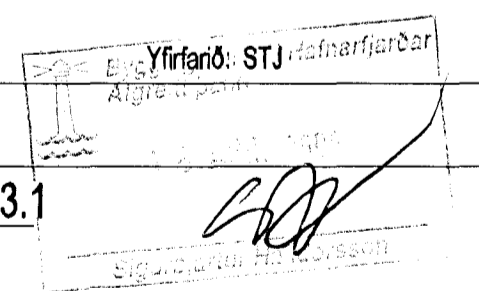

Fálkahraun 9, Hafnarfirði

GRAVIS ehf.

Kt:650398-3519

Kaplahrauni 15 220 Hafnarfirði

s:555-3783 fax:555-2873

Stefán Jörundsson TFI kt. 230145-7099

Stefán Jörundsson

