


SKA SÚTT OG SKILNINGAR Á PLÁTTI NR. 2

ÁSKILIÐ, ELDRI
TEKNING ÓGILD

27 OKT. 1993

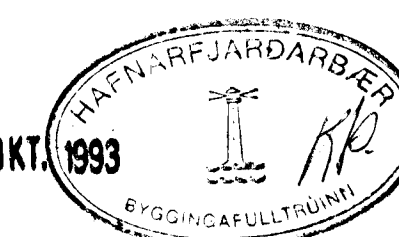

BRÝTT 1 OKT. 1993

HERDÍSSON	ETPÍ	8-677544
FJÁRDARGATA NR. 17		
SKALA	1:50	UNDIRSTÖÐUR GRUNNMYND
DAGS.	27 OKT. 1993	
BLAÐ	1	<i>Herdís Einarsson</i>