



GRUNNMYND - 1. HÆÐ

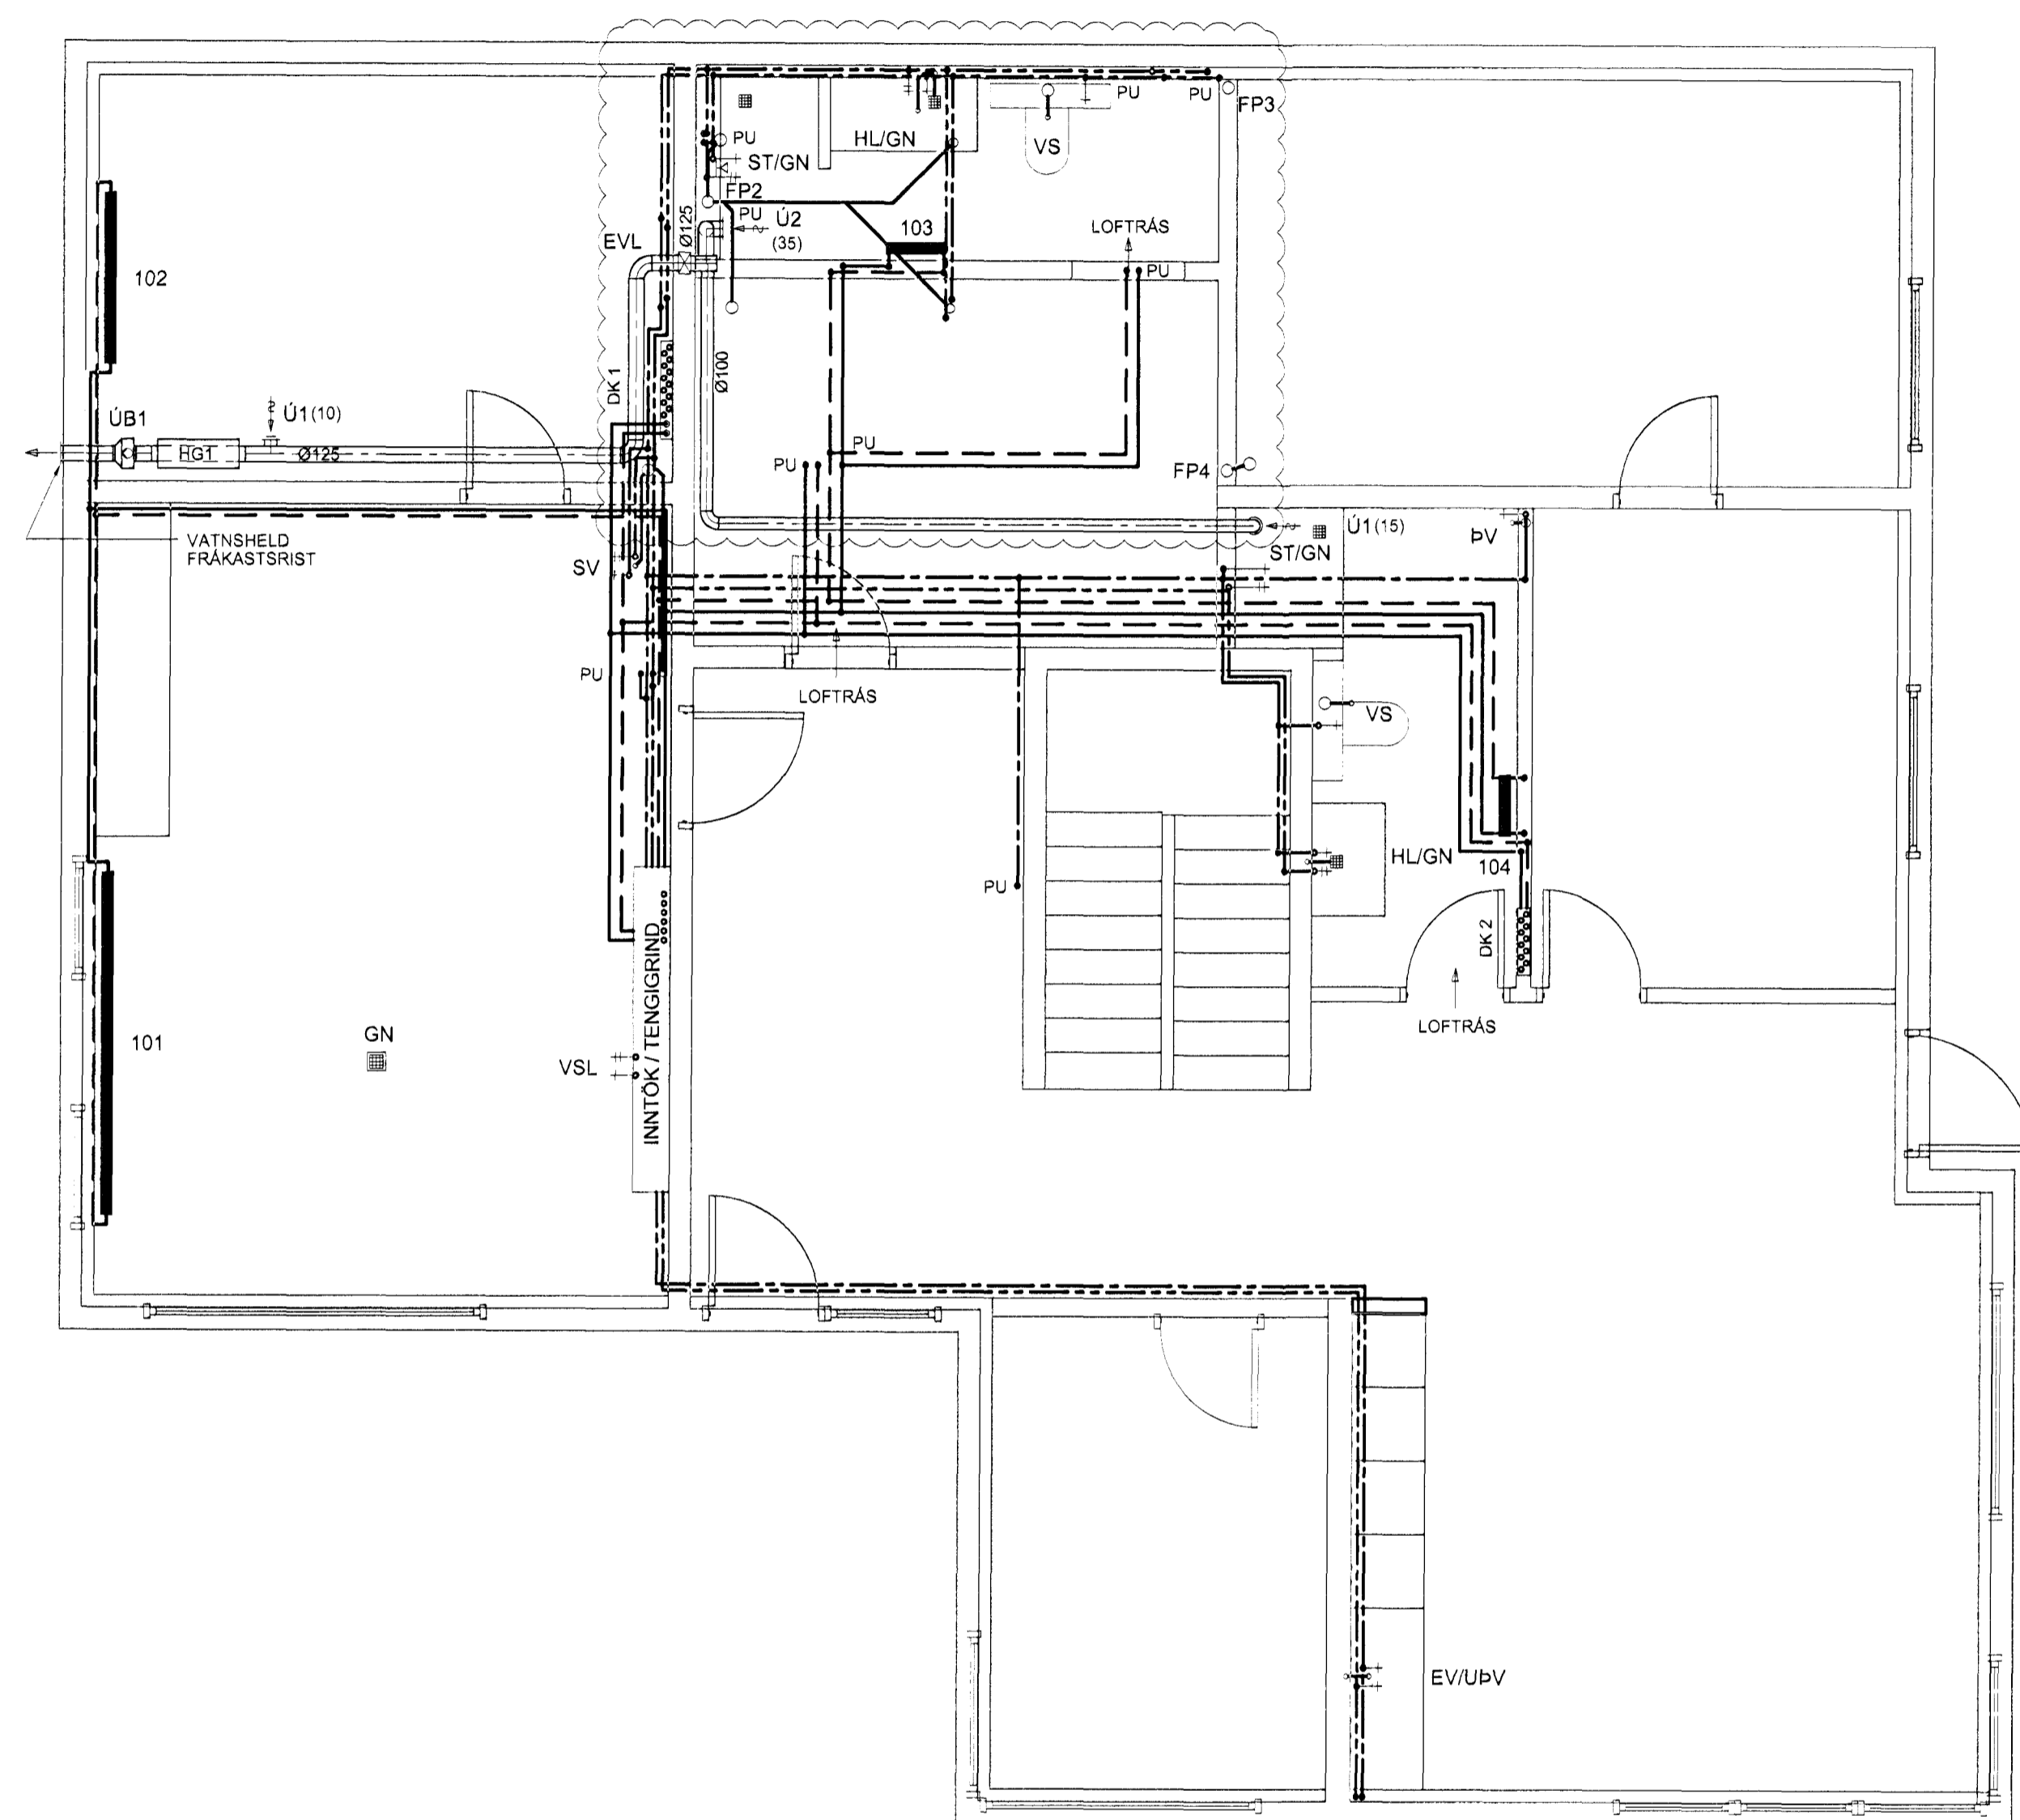

GRUNNMYND - 2. HÆÐ

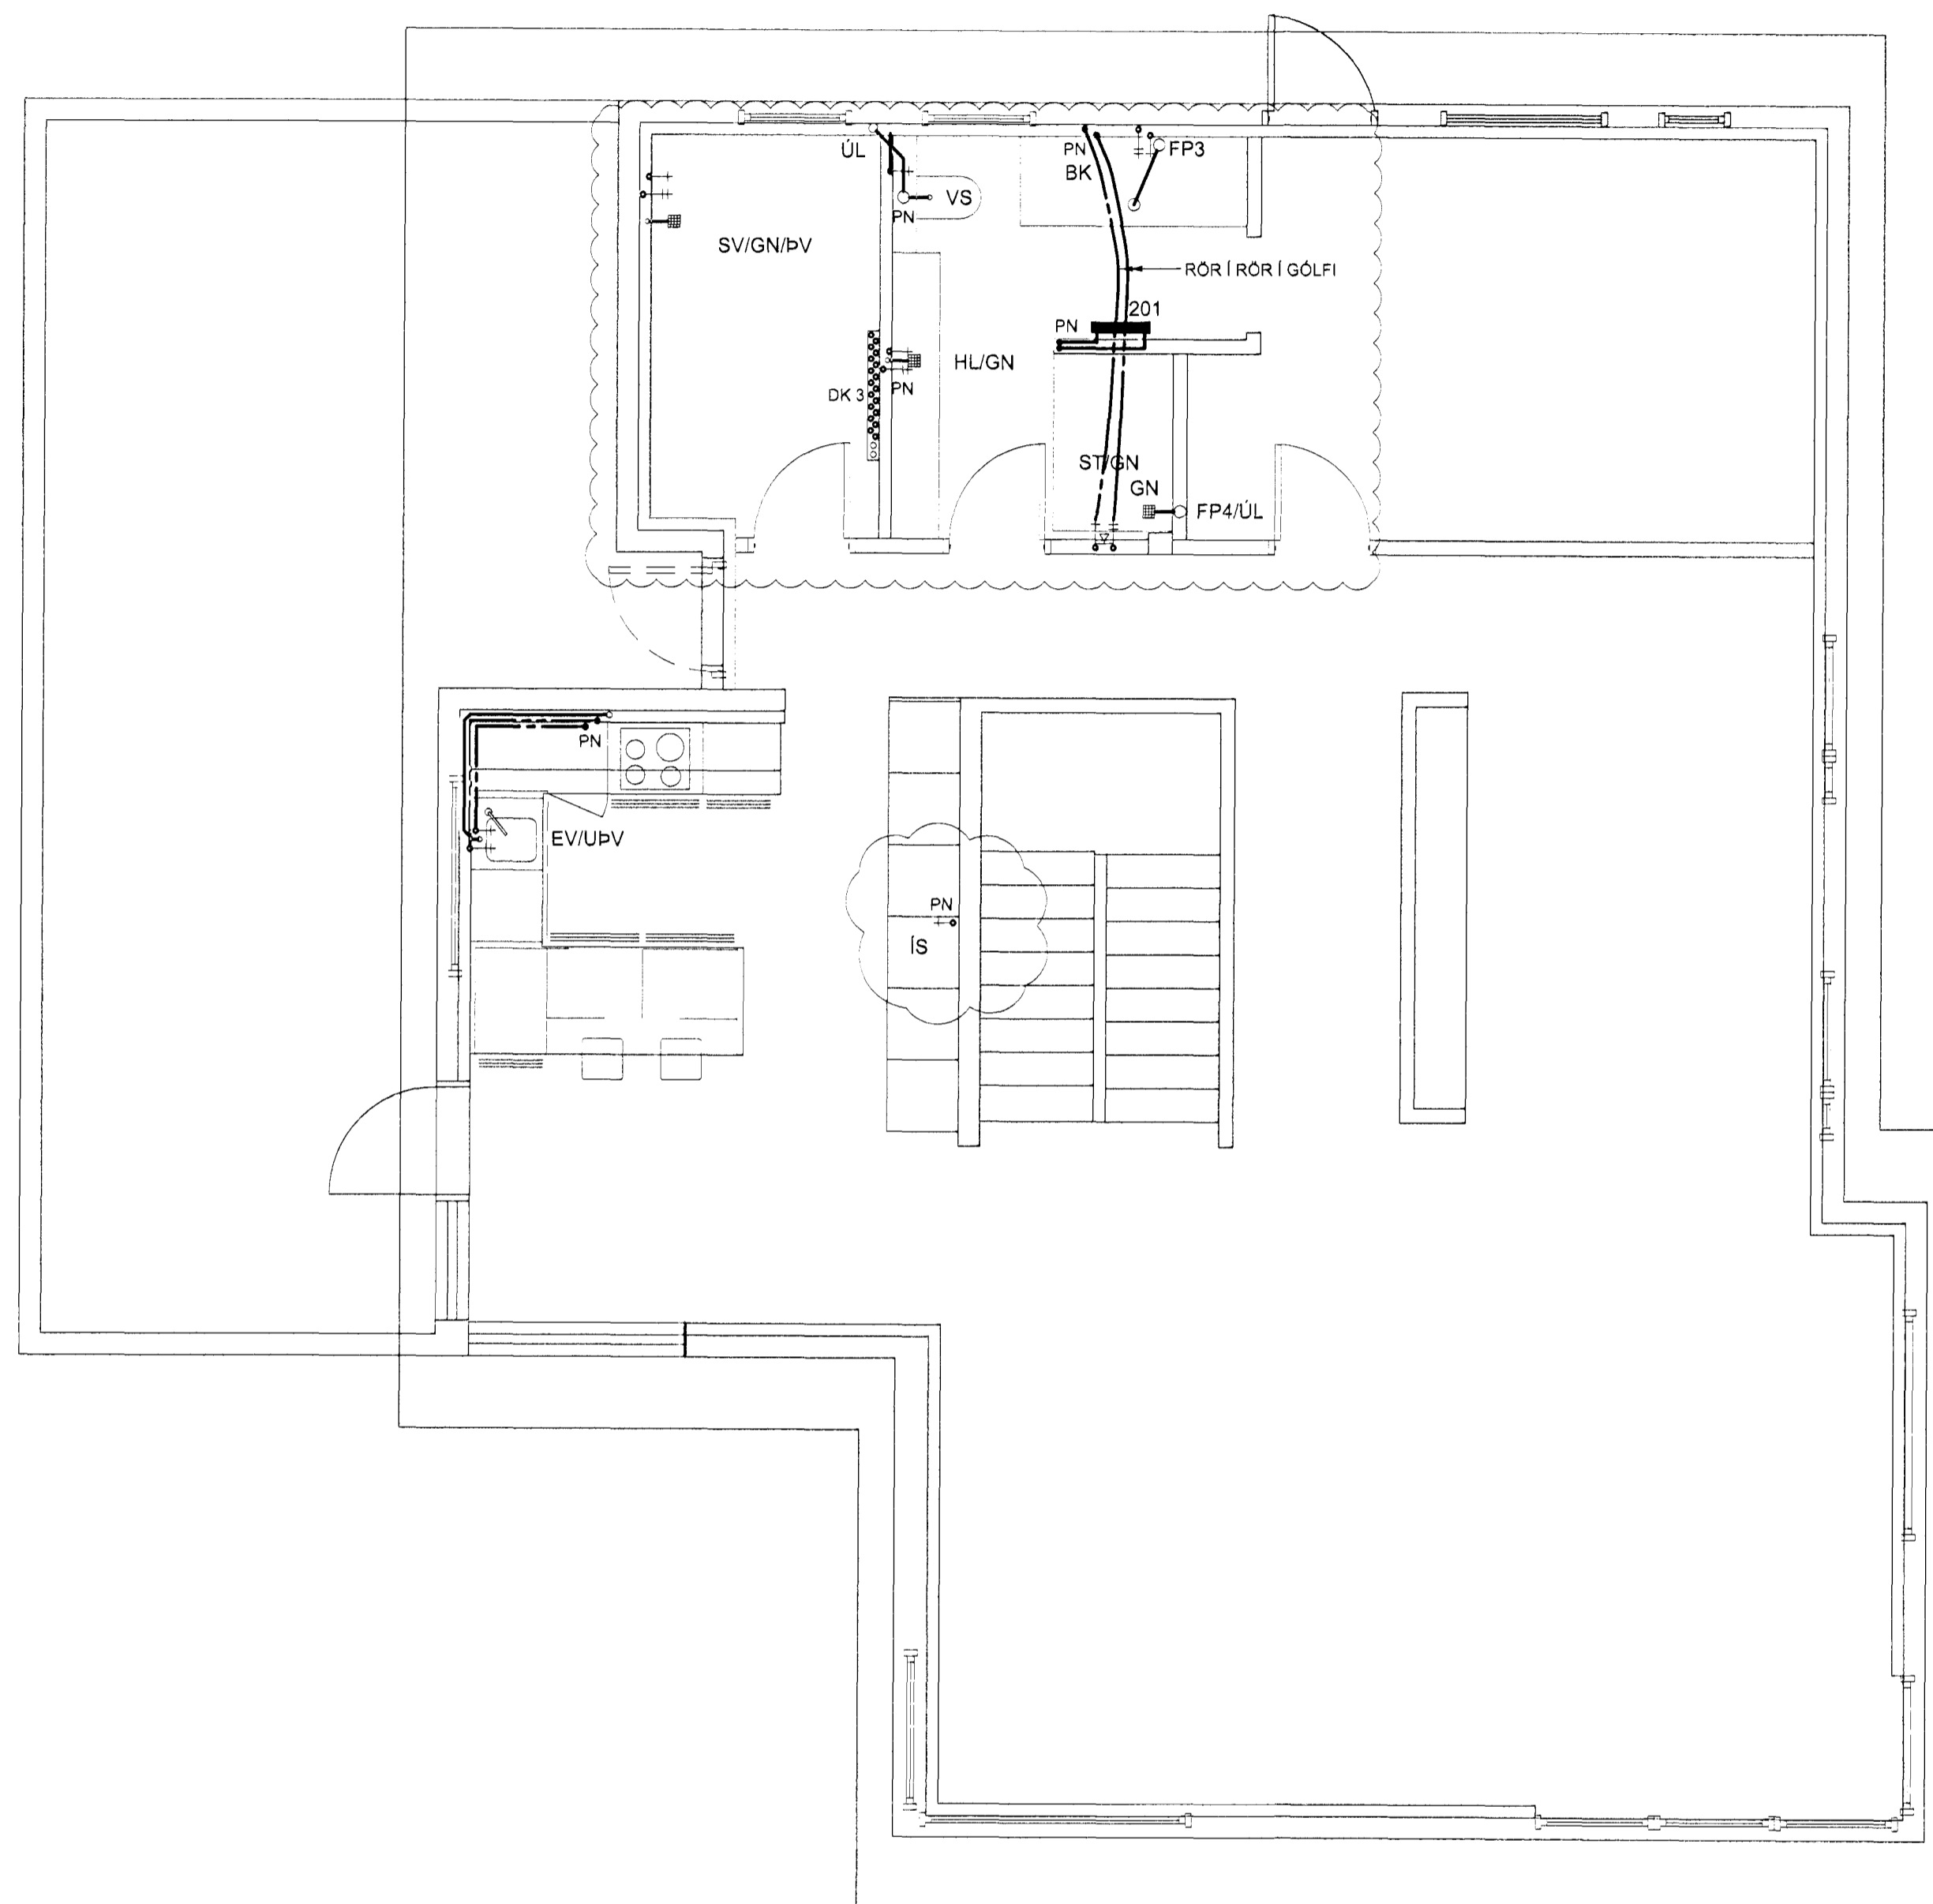


OFNASKRÁ

NR	REKNI VARMATAP Watt	HÁMARKS-		VALDIR OFNAR		STÚTAR 10 mm
		HÆÐ mm	LENGD mm	A B	C D	
101	3400	500	2800			C - B
102	880	500	1400			A - D
103	450	1200	500			F - E
104	450	1200	500			F - E
201	450	1200	500			E - F

5830 W

TILVÍSANIR:
 ALMENNAR SKÝRINGAR SJÁ BL. NR. L1-A-1

B	19.09.11	BREYTINGAR SAMKV. BREYTTUM INNRÉTTINGUM	KH	SH
A	23.07.08	LAGNALEIÐUM BREYTT	ÖAG	ÖAG
BR	DAGS	BREYTING	REIKN	TEIKN

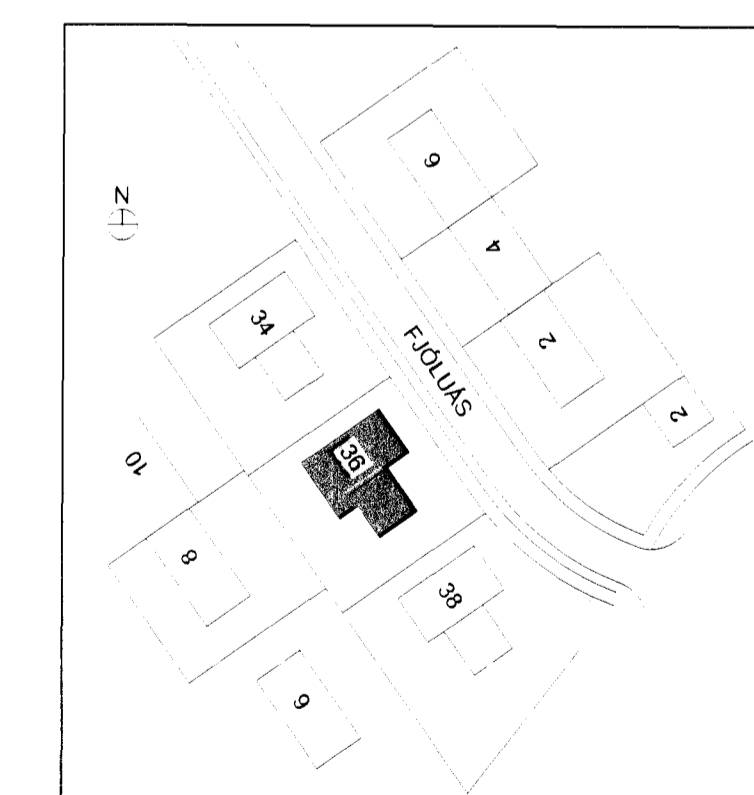

VSÓ RÁÐGJÖF

BORGARTUN 20 103 REYKJAVÍK, Sími 585-8000, Símbreyf 565-9010, Netfang vs@vs.is

FJÓLÚÁS 36 - HAFNARFIRÐI

BRIFA, HITA- OG LOFTRÁSISKERFI	HANNAÐ/TEIKN	ÖAG / ÖAG
1. - 2. HÆÐ	YFIRFARÐ	
GRUNNMYND	SAMÞYKKT	
	KT.	330857-5909

KVAFUR: A1/ 1.50
 VEKJUR: REYKJAVÍK 02.04.2008

TEIKN NR. L1-G1-1

BR