





SNID 1, 1:10

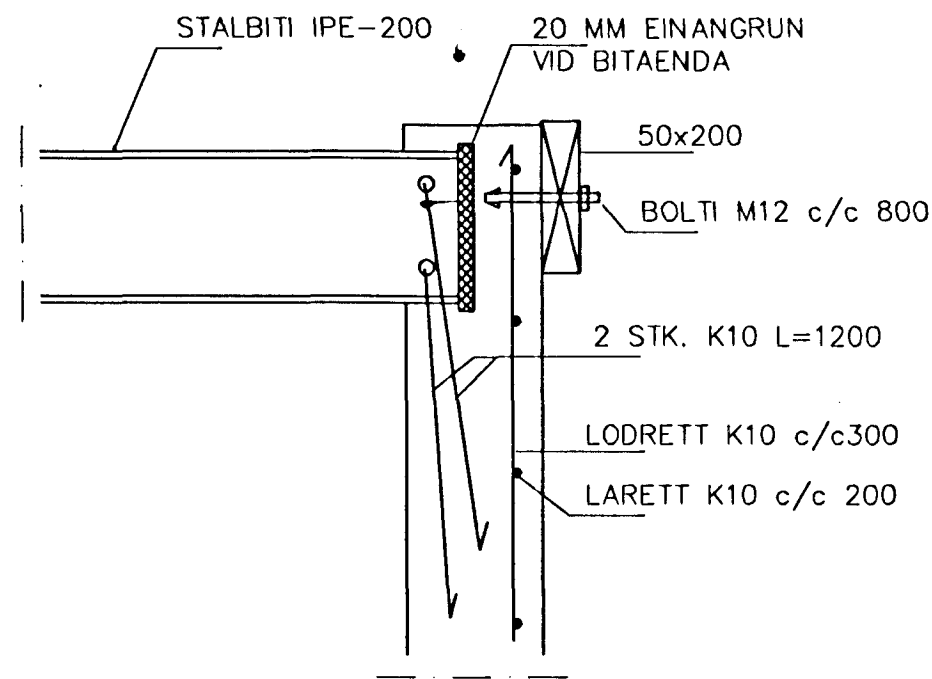


SNID 2, 1:10

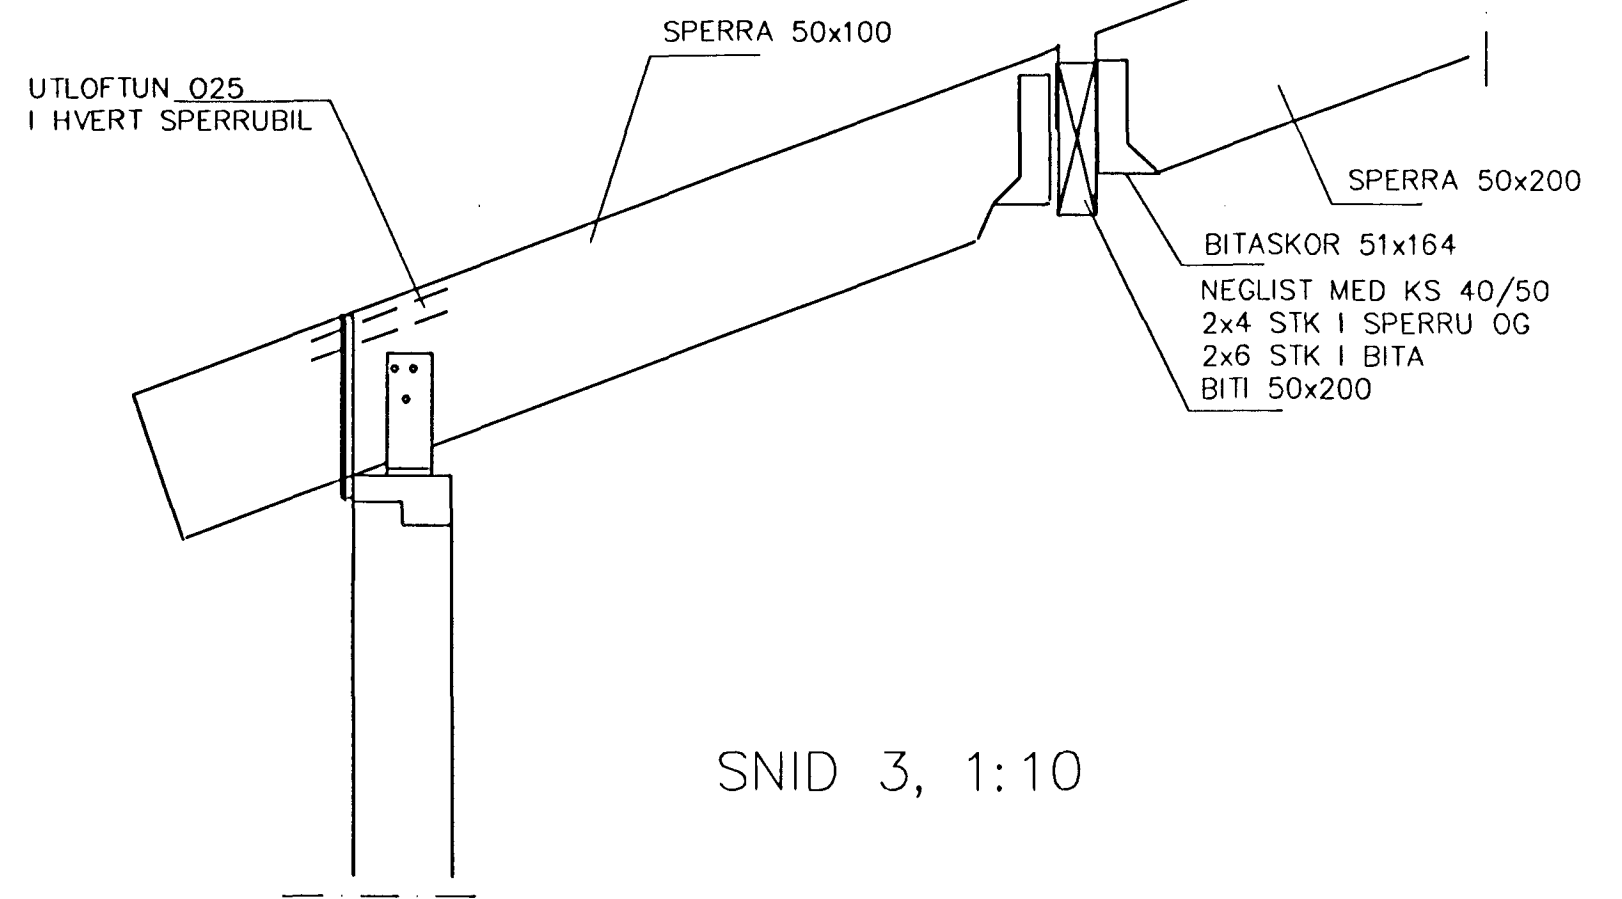

SNID 3, 1:10

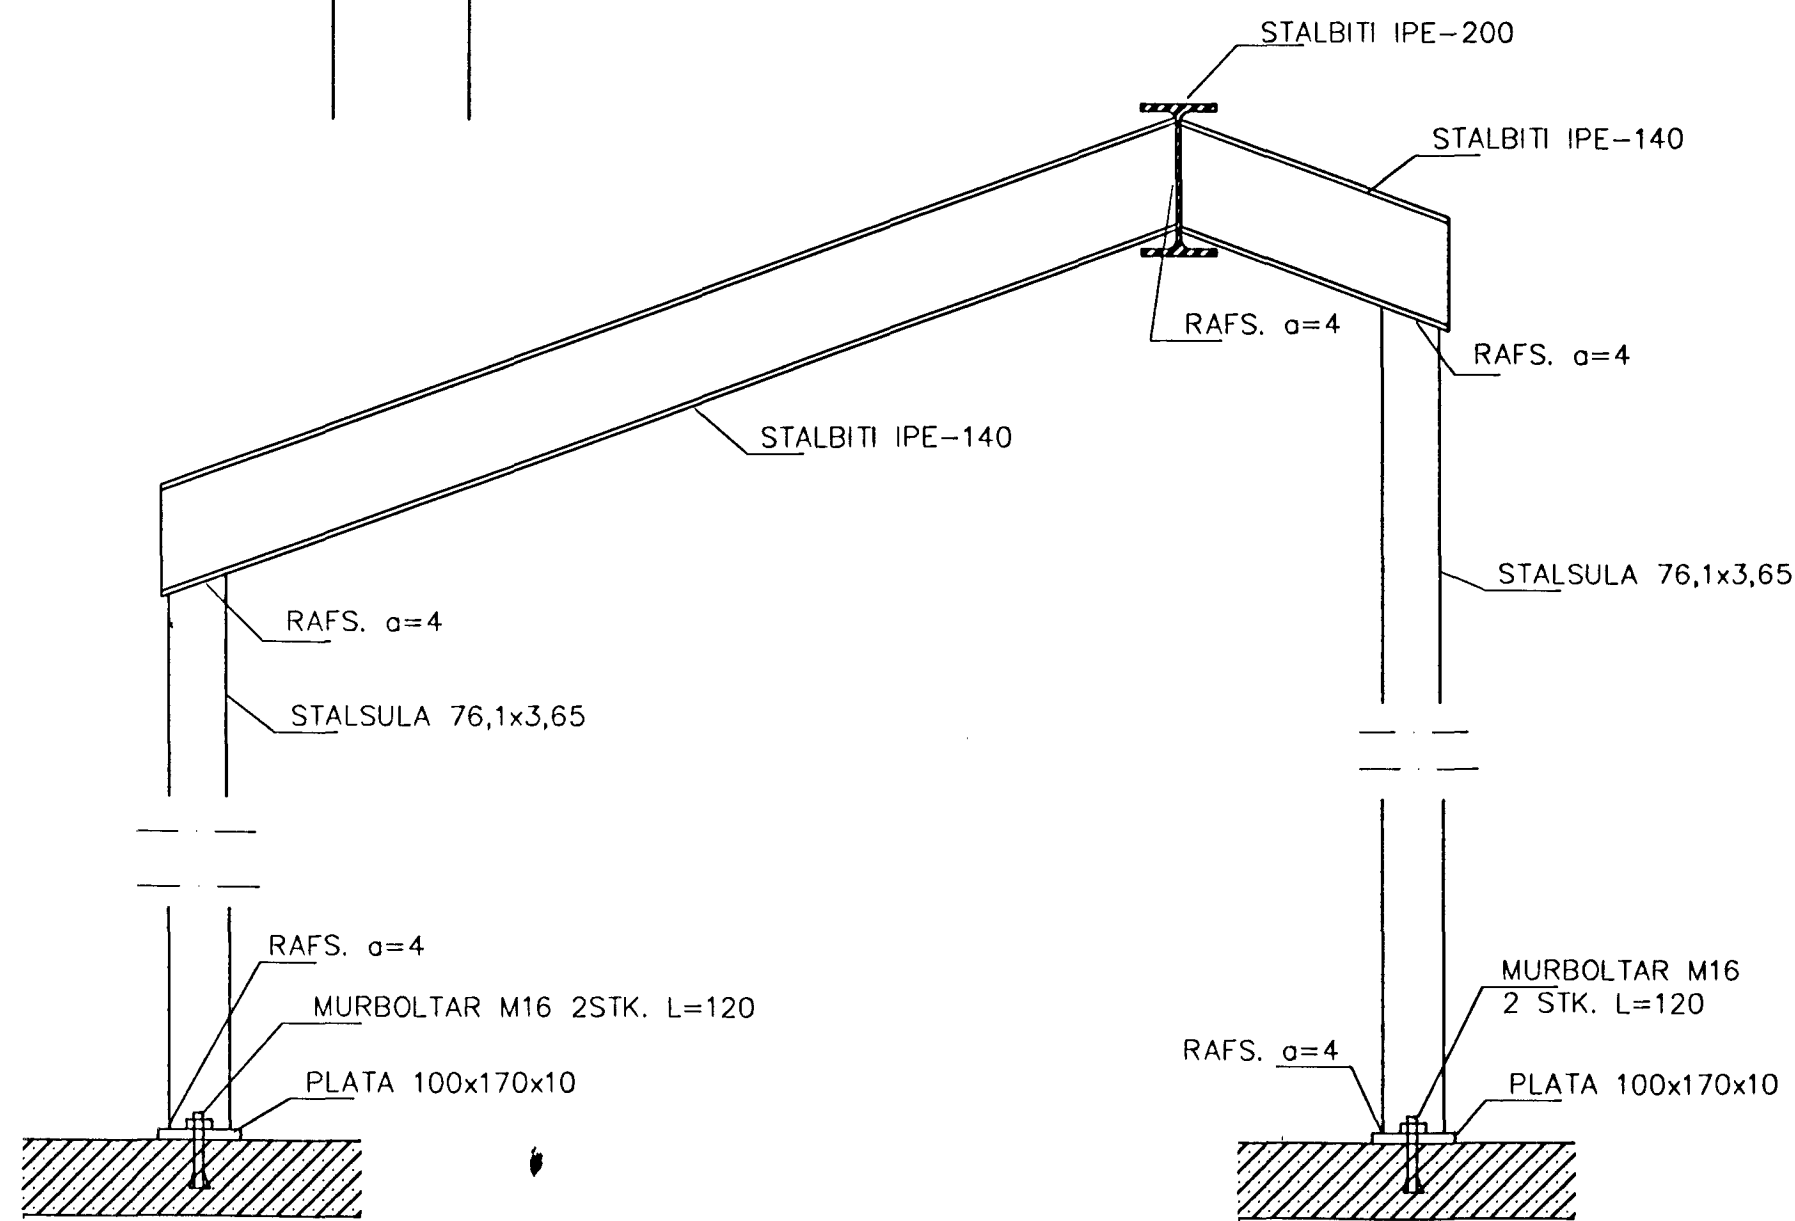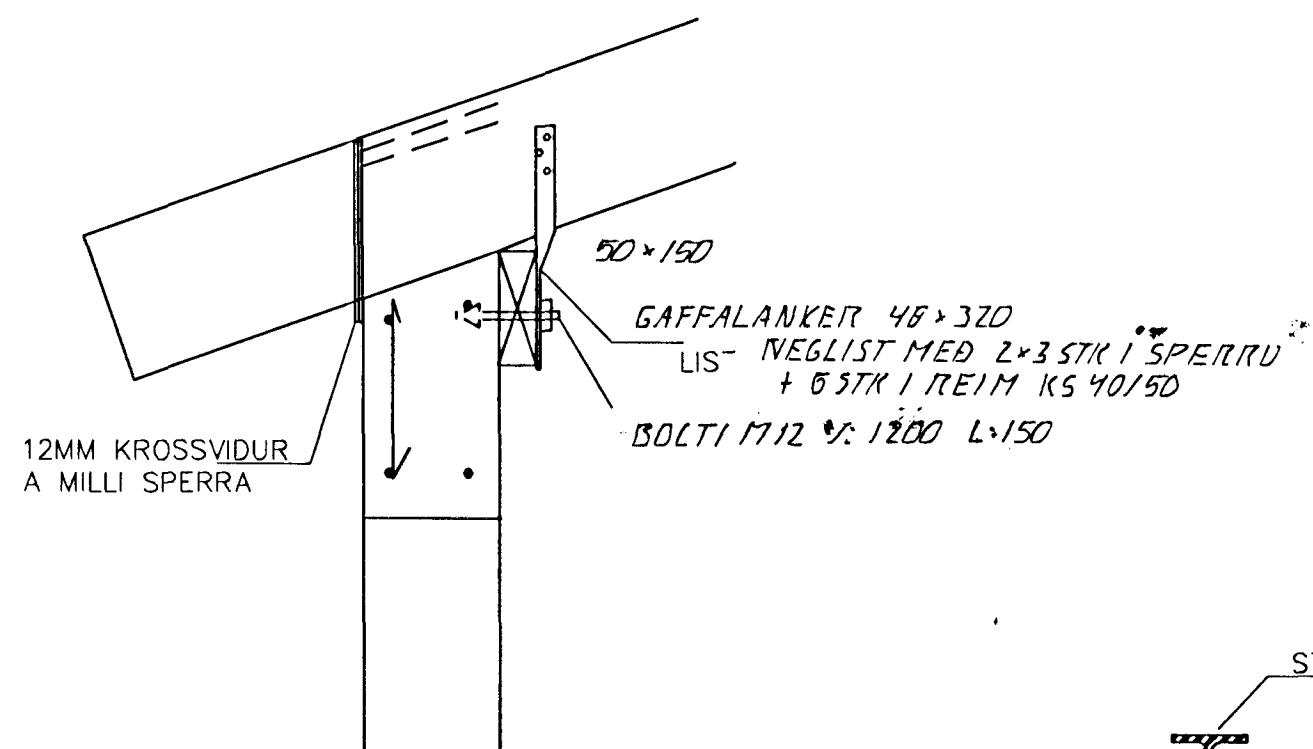

SNID 4, 1:10

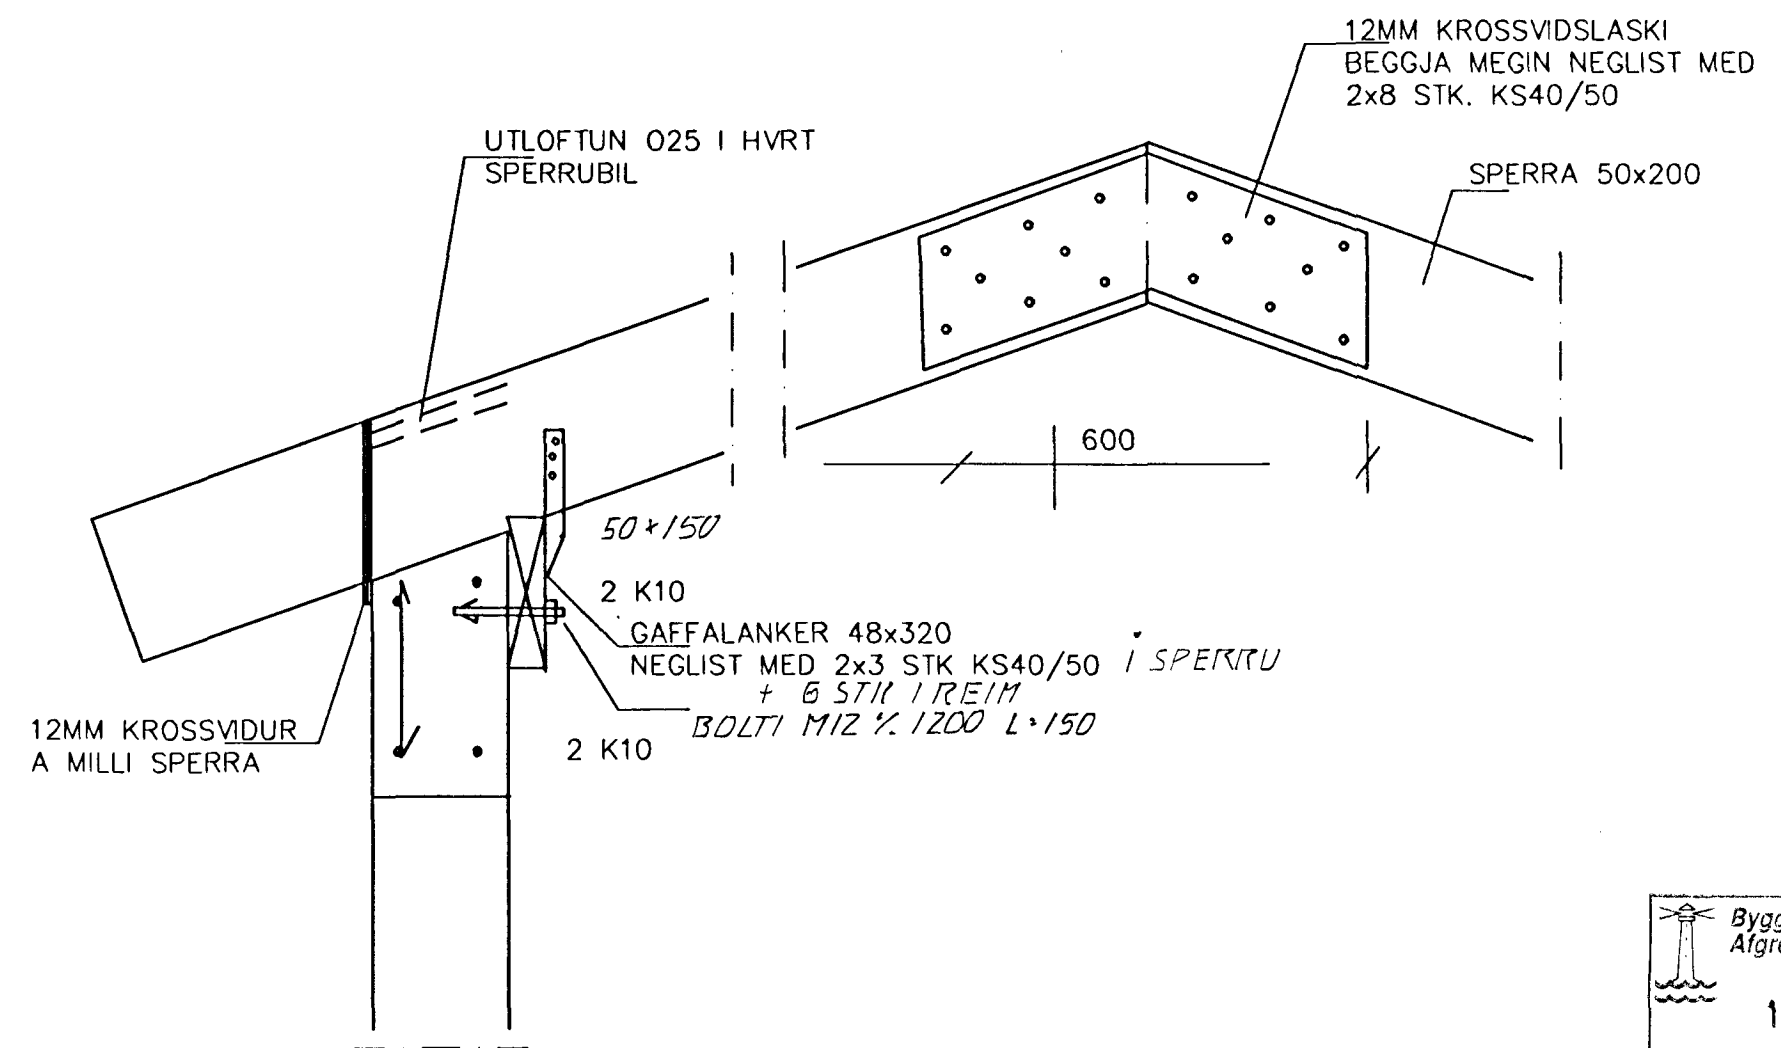

Byggingafulltrúi Hafnarfjarðar
Afgreitt þann
17 NOV. 1997
Sigurbjartur Halldórsson

SKYRINGA
GRUNNMYND SJA BL.1-02
ALMENNAR SKYRINGAR SJA BL. 1-02

FJOLUHLID 6 HAFNARFIRDI

BURDARVIRKI, SERMYNDIR

SVEINBJÖRN HINRIKSSON TÆKNIFRÆÐINGUR *4. 21.*

KVARDI 1:10

DAGS. MARS 97

TEIKN. 1-03