


Kaldaleitlin byggur heitvannum í Veggnum
 Heitaleitlin byggur báðmeiri í Veggnum

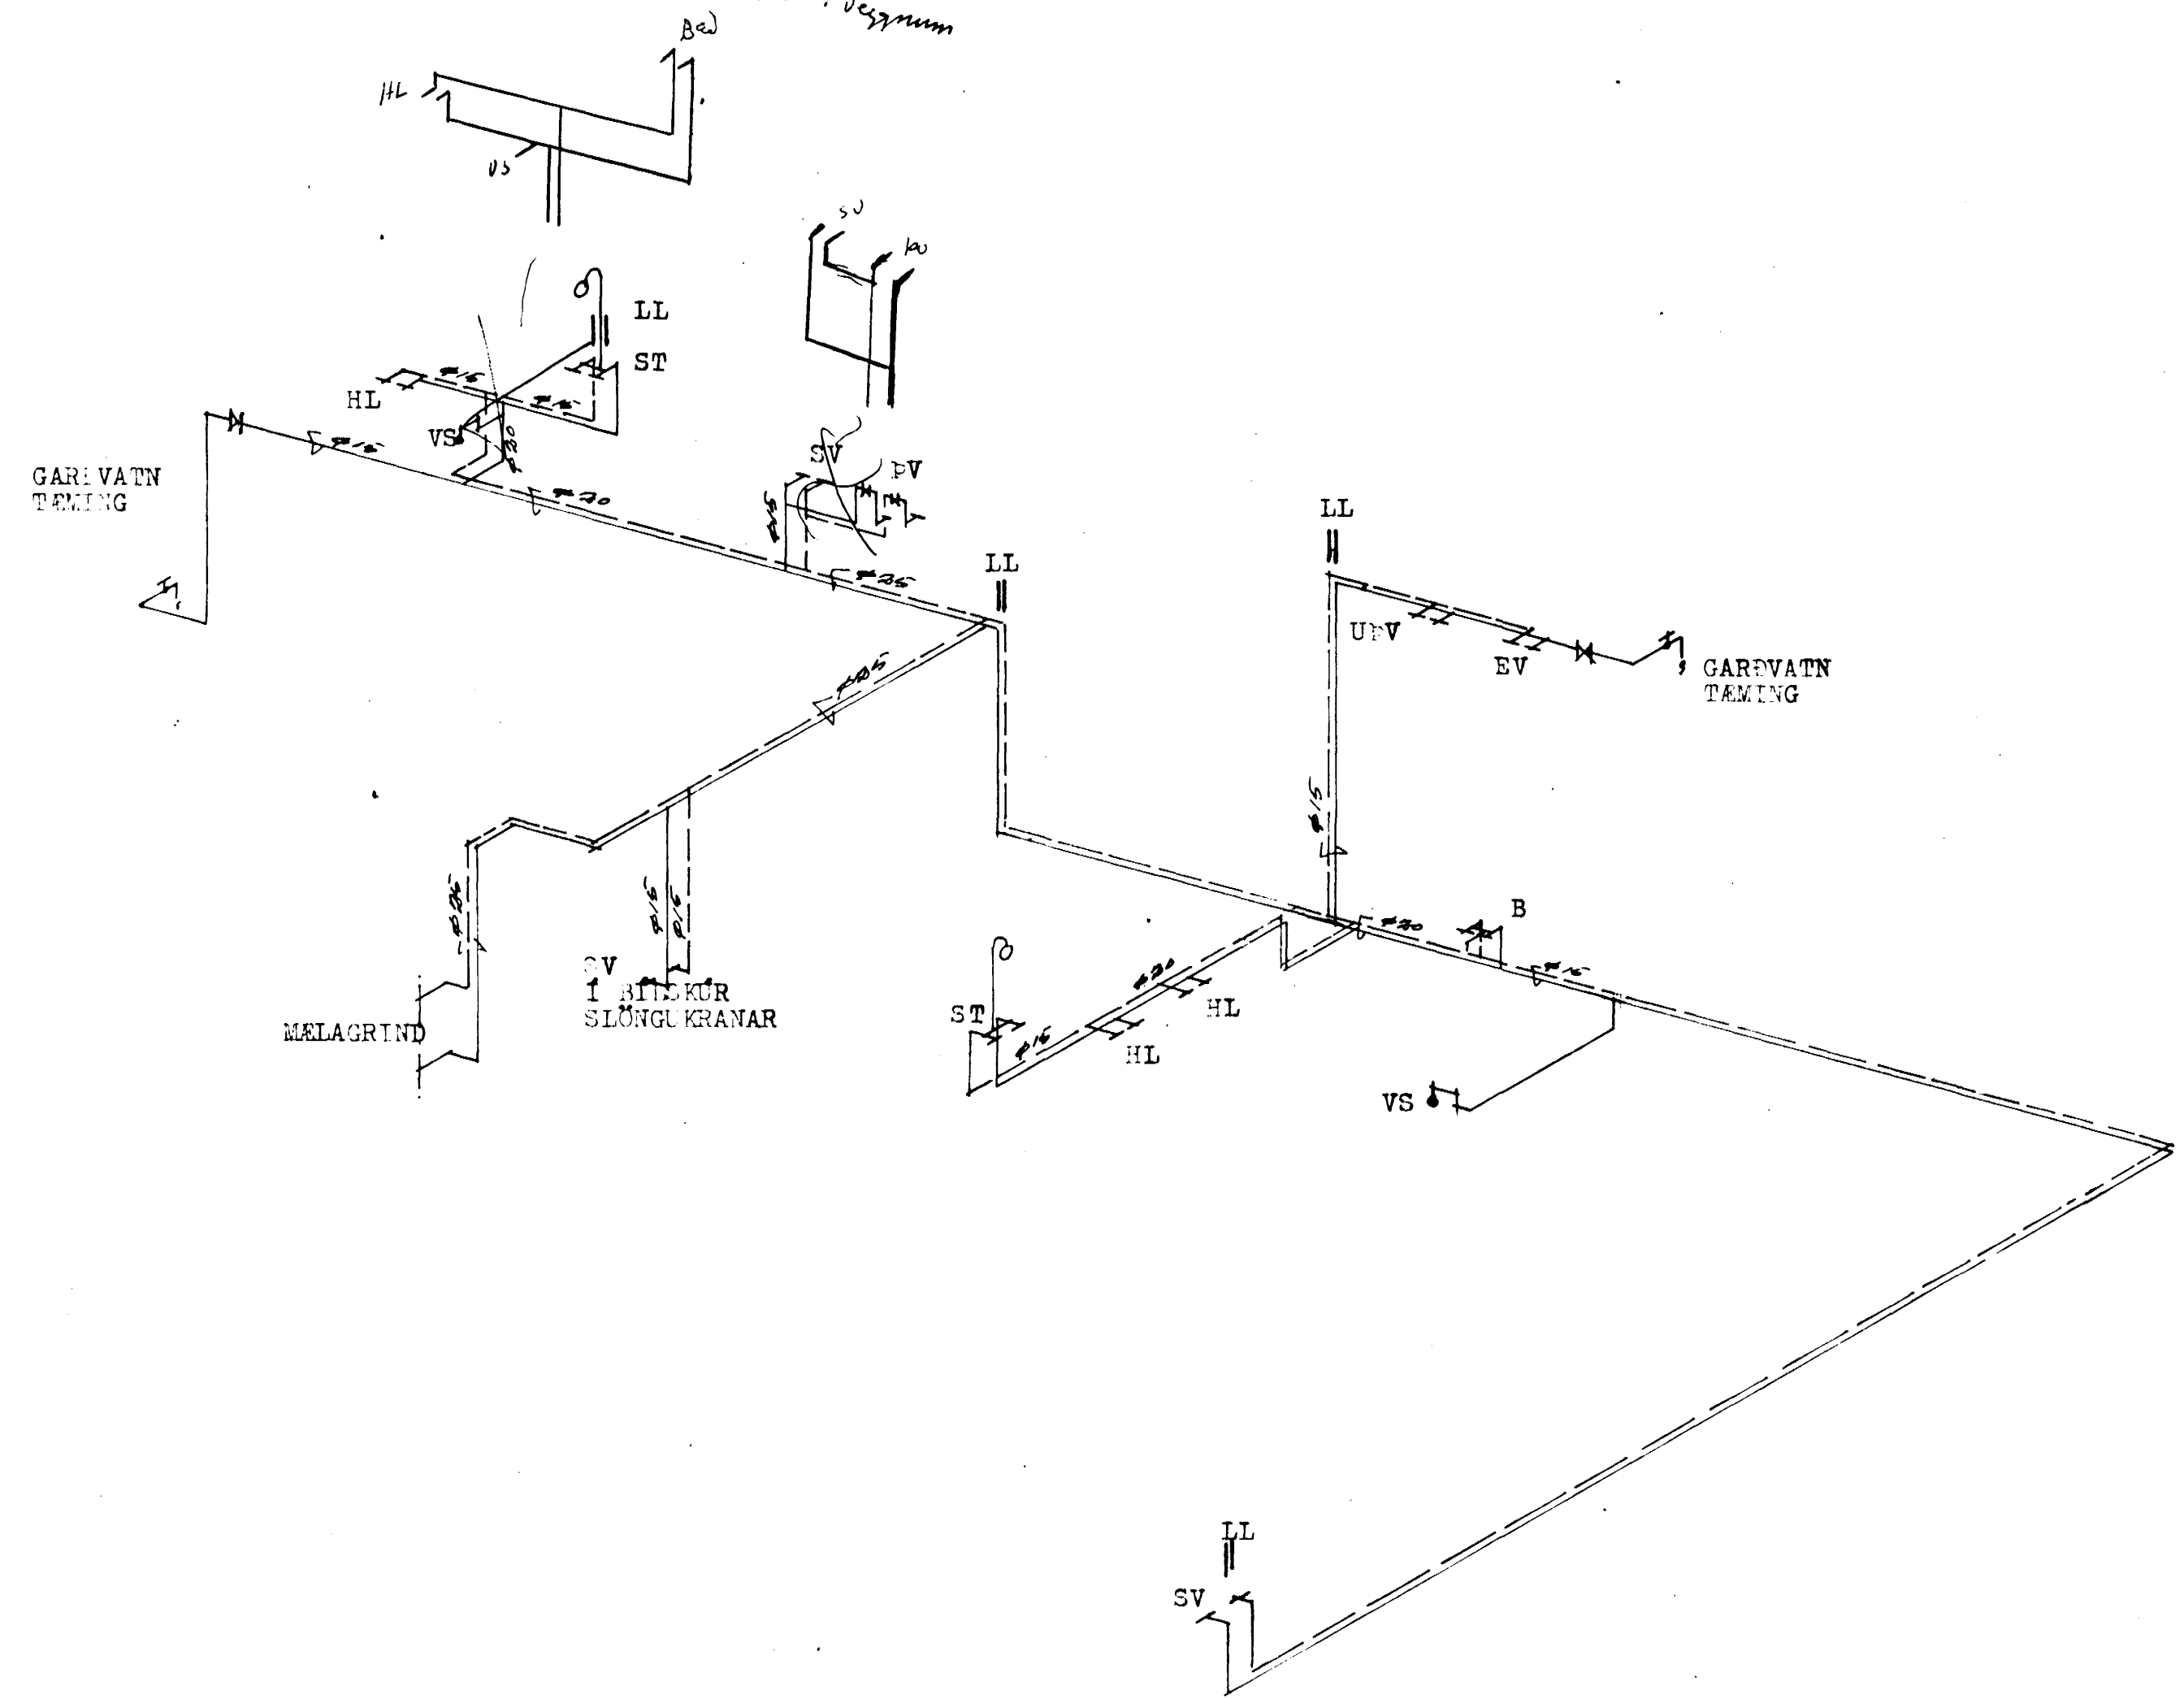

STEINGRÍMUR TH. ÞORLEIFSSON, MTFI TEIKNISTOFA - ARMÚLA 5 - SÍMI 3-22-44		
VERK: FJÓLUHVAMMUR NR.14 HAFNARFIRÐI		
MÁL	1:50	VATNSLAGNIR -TENGIMYND
DAGS	SEPT.-1980	
BLAD	6	
BREYTT	<i>mar. 1981 s.k.þ. Steingrímur Th. Þorleifsson</i>	