

Fjóluhvammur 1. Hafnarfirði.



Breyting á þæðri hæð.

Skrá yfir ofna. delta T=40°C.


Nr	Varmab. w/t	Mesta lengd	Mesta hæð.	Tengi Ø10	LoKi	Stilli Loftt.	MP-ofnar.
01	500	100	70	CD	RAVL	+	P-590-1040
02	300	70	70	CD	RAVL	+	P-590-640
03	1000	120	70	AB	RAVL	+	P2-590-1200
04	400	100	70	CD	FJVR	+	P-590-800
05	1350	120	70	AD	RAVL	+	P3-590-1200
06	1000	120	70	AD	RAVL	+	P2-590-1200

Heimæð kalt neyzluvatn.

07	300	140	70	CD	FJVR	+	P-590-1400.
08	300	200	70	AD	FJVR	+	STJ 42/200.

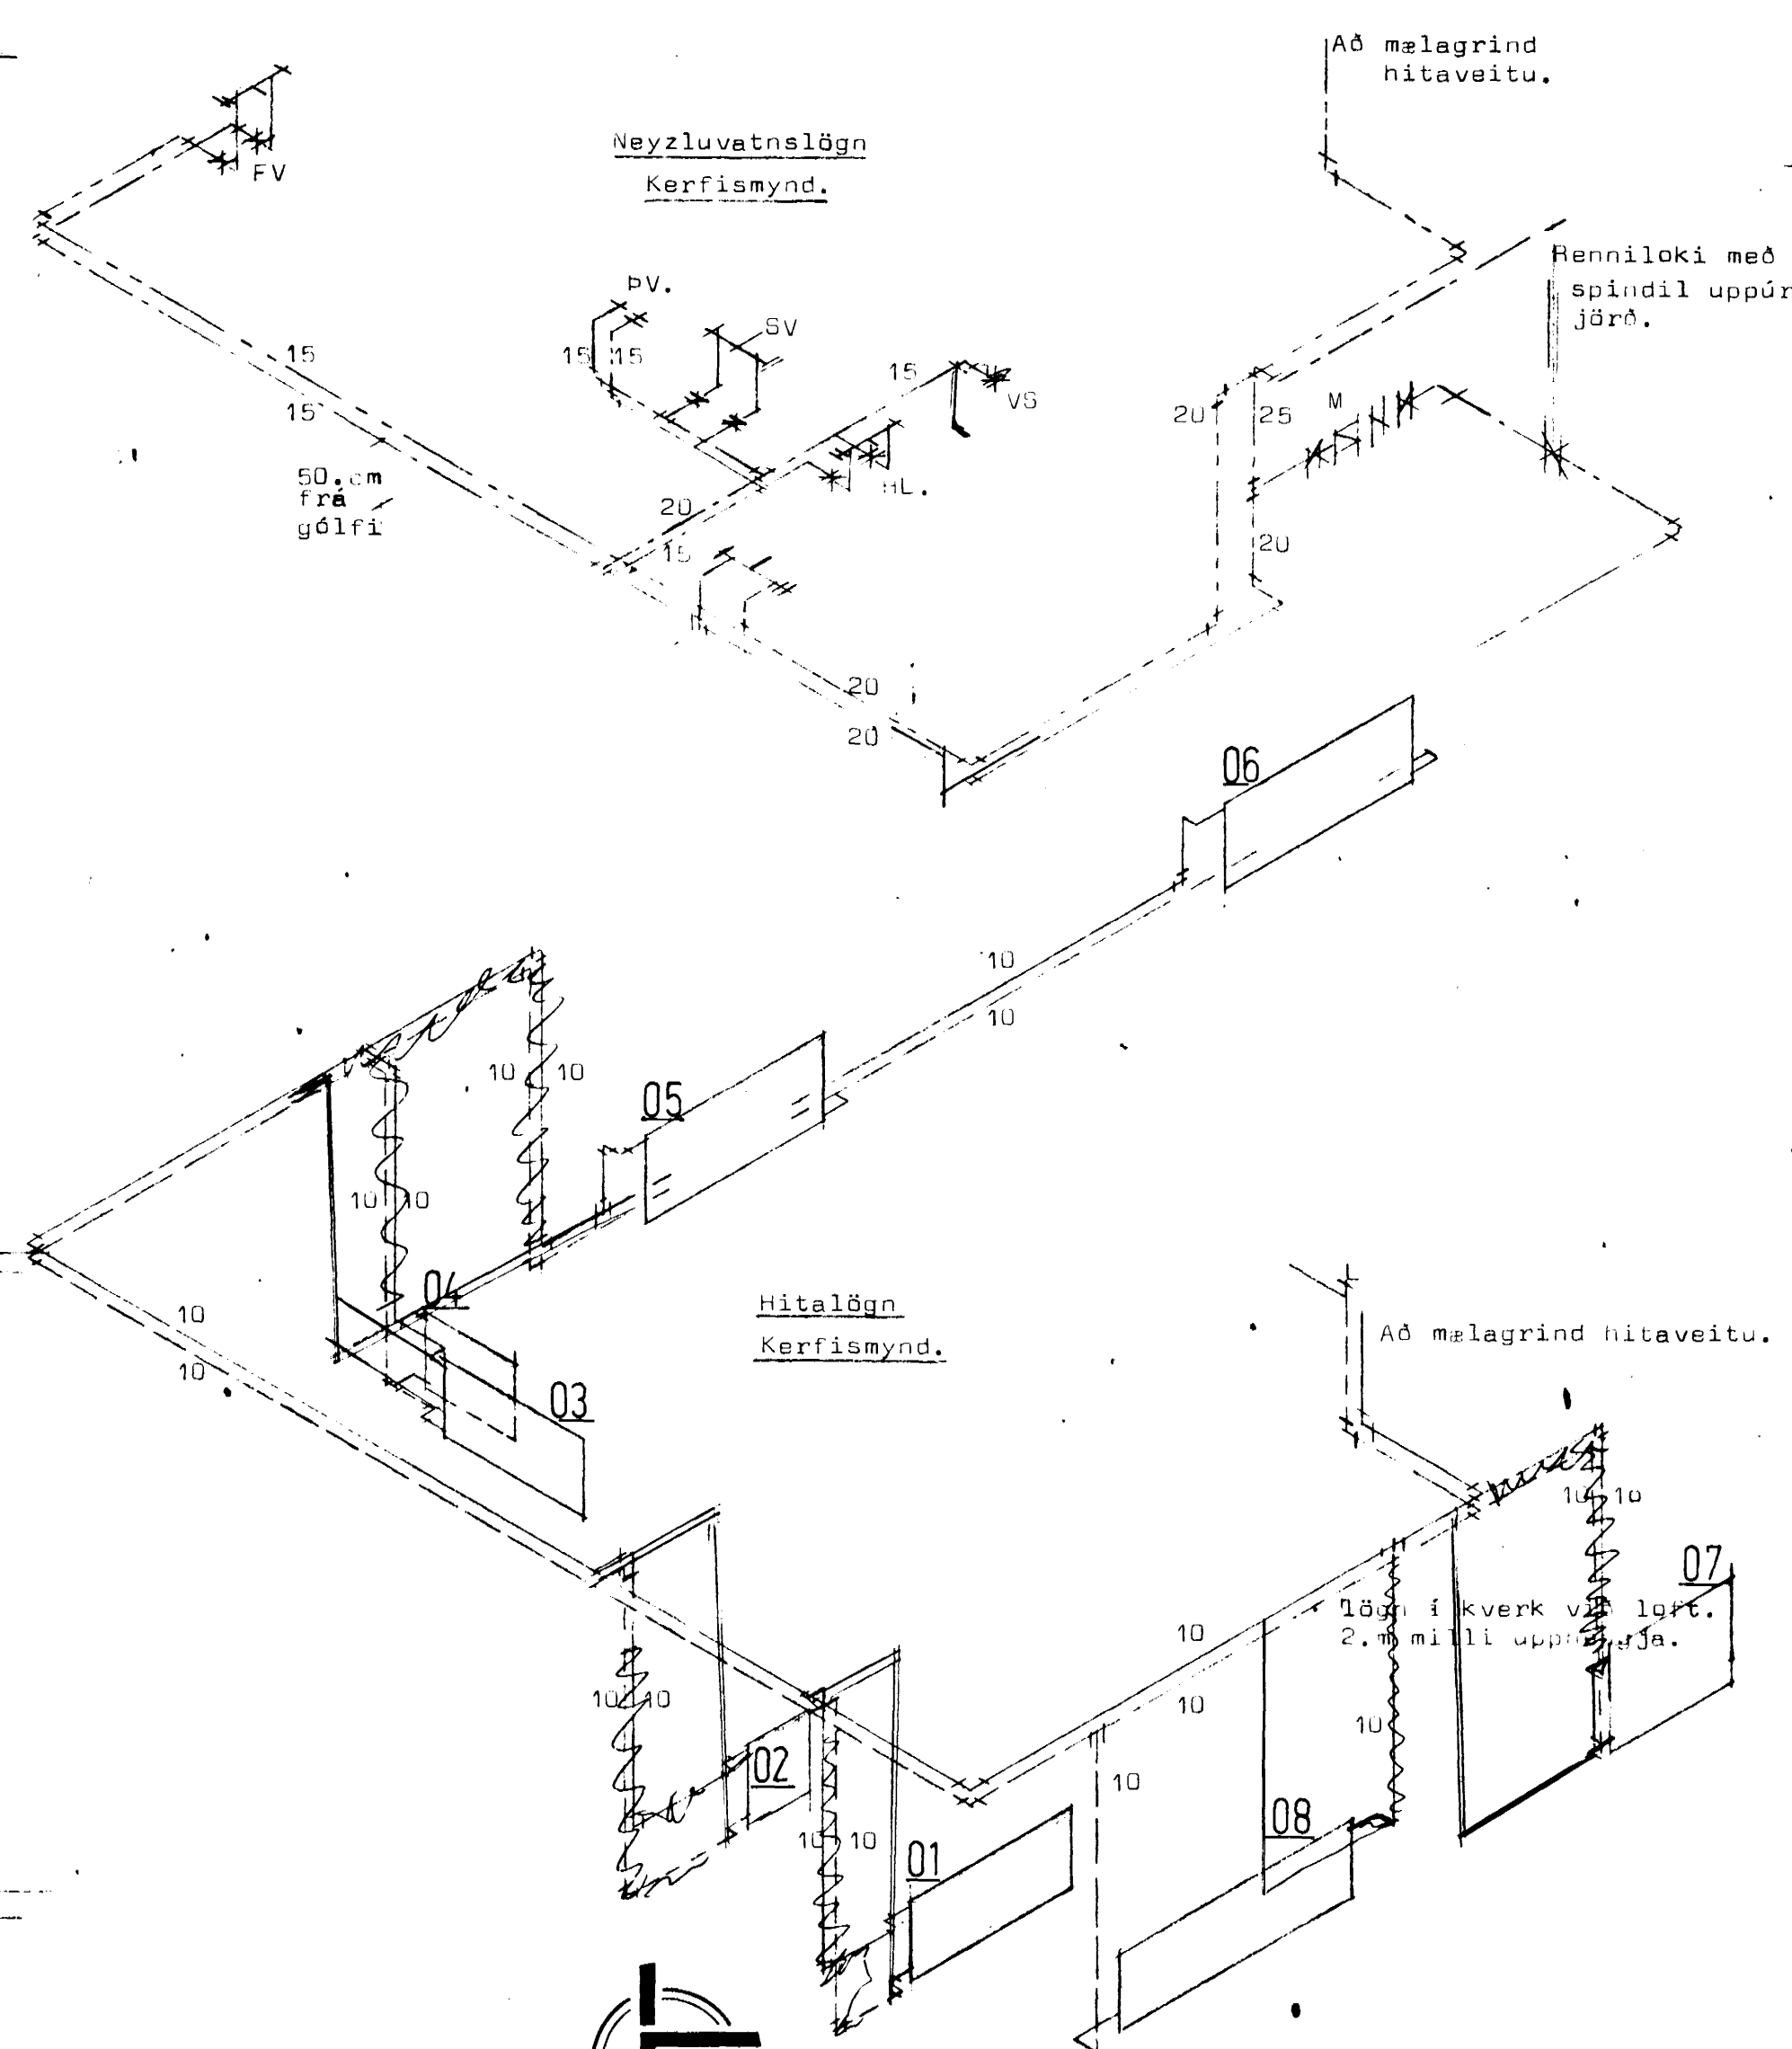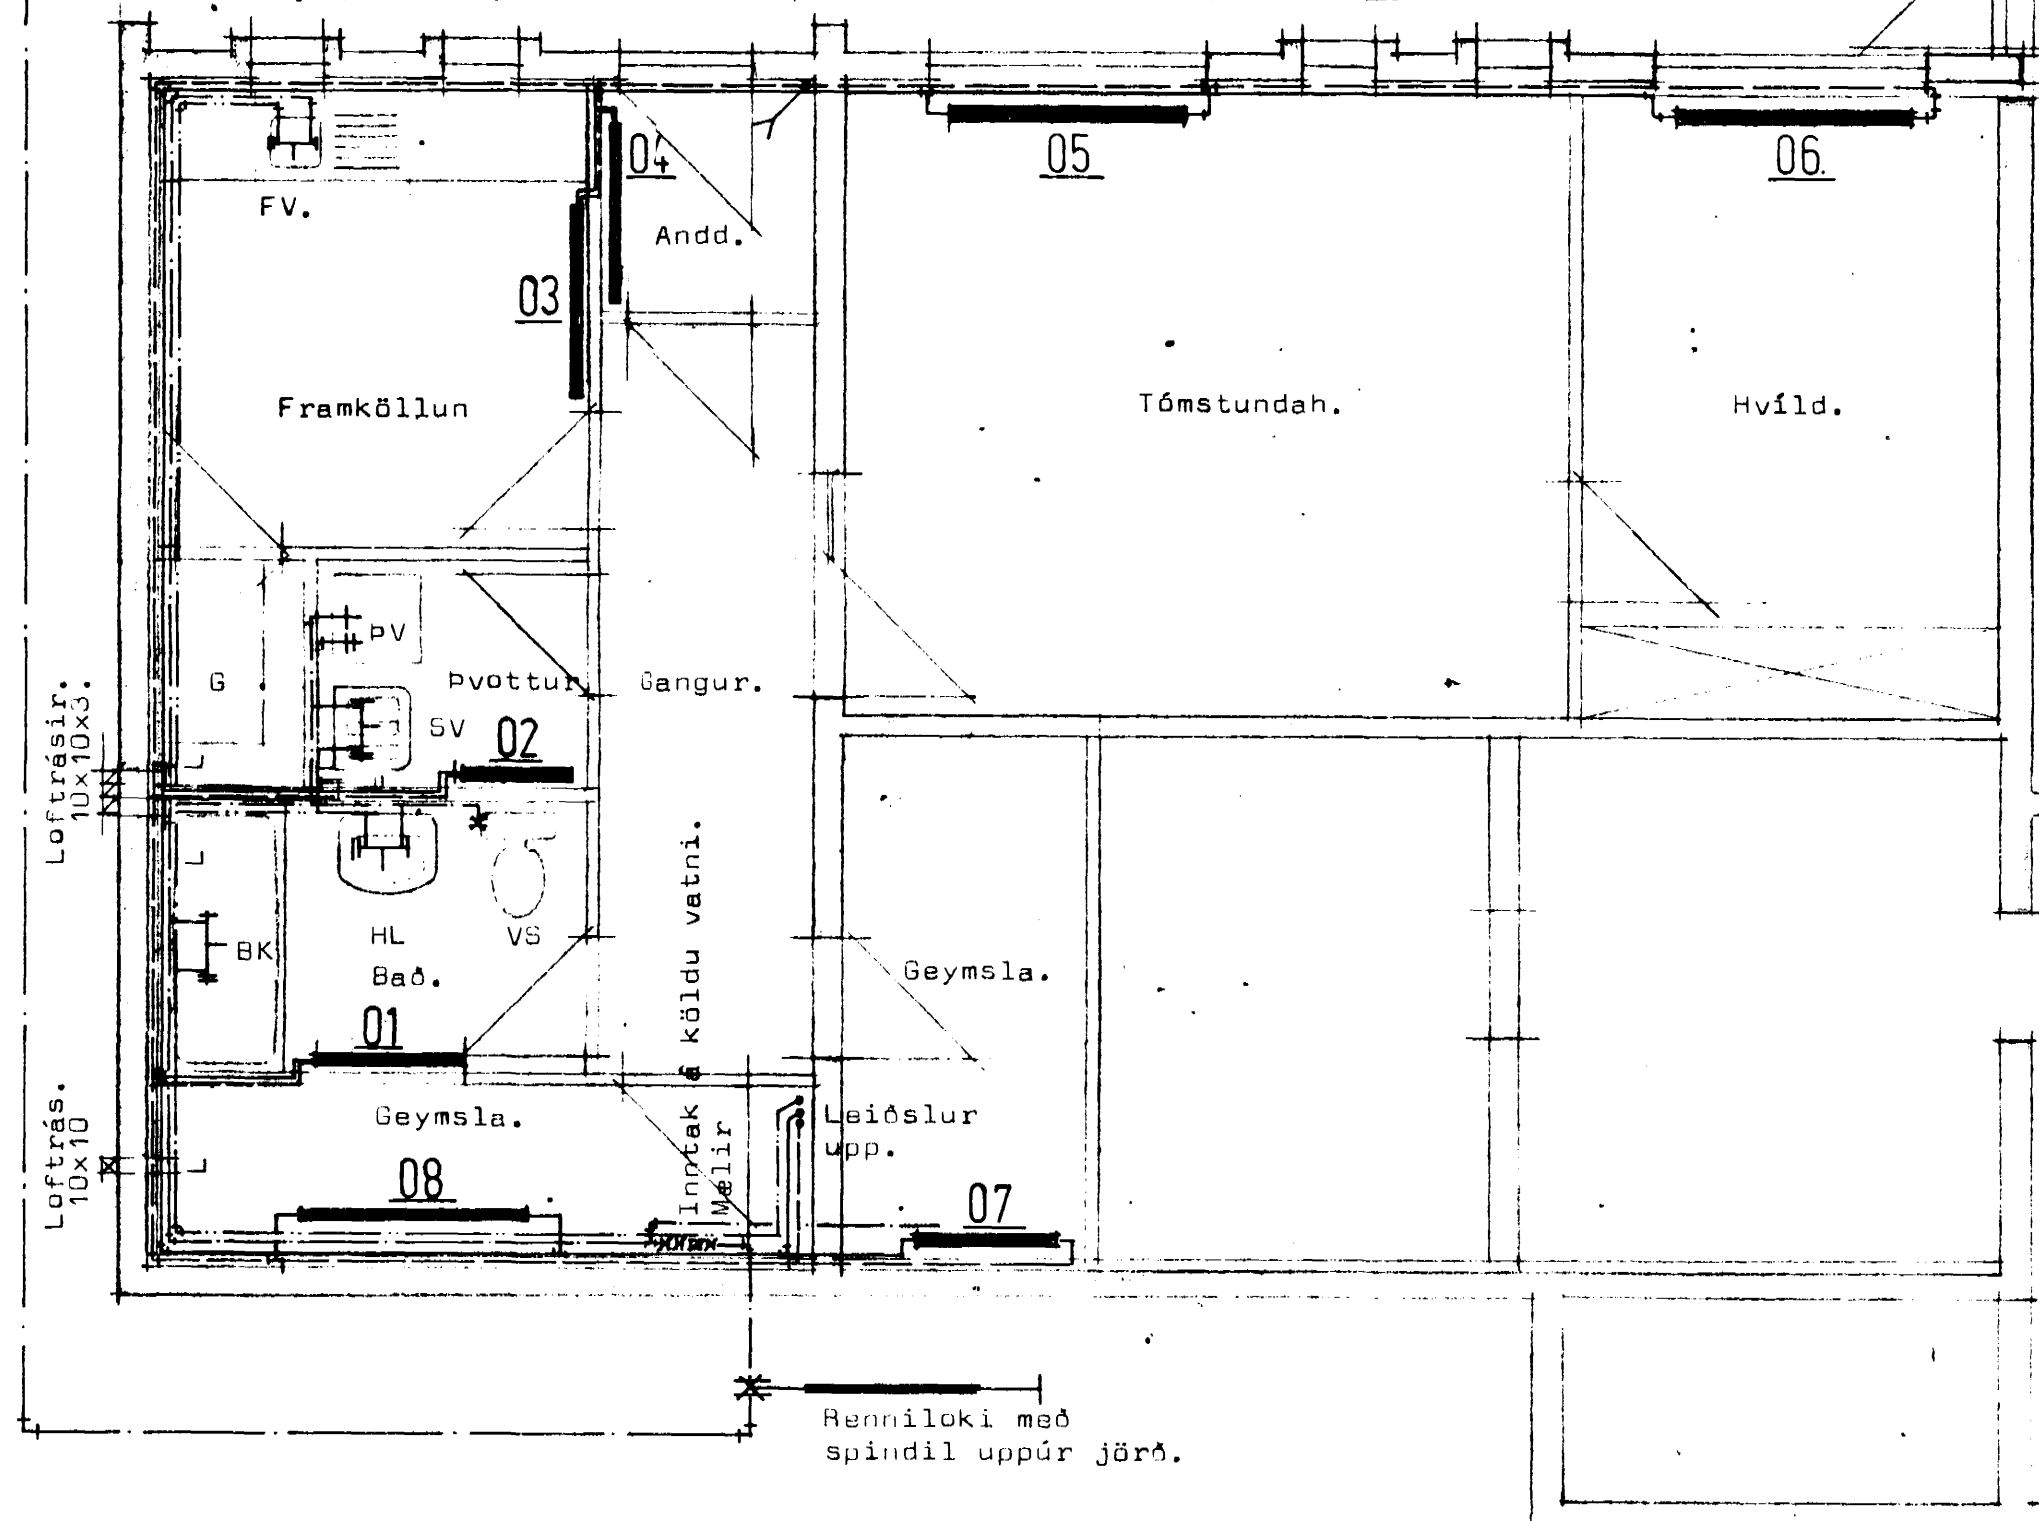

STADALHÚS S T
TEIKNISTOFA SÍÐUMÚLA 31 SÍMI 83141

VERKEFNI	DAGS.	1981.	VERK NR
Hitalögn og neyzluvatnslögn.	MKV.	1:50	
Fjóluhvammur 1. Hafnarfirði.	BR. MÆRZ 1981. SÞK:		SU 36.
	BLAD NR	S. J. 1.1.	
 SIGURDUR GUÐMUNDSSON SIGURDUR P. KRISTJÁNSSON FTFI			