



GLUGGAR EÐA PLASTPLÖTUR

Samþykkt á fundi bygginga-  
nefndar þ. 23/9 1964  
BYGGINGAFULLTRÚINN  
Í HAFNARFIRÐI  
Jón Bergsson

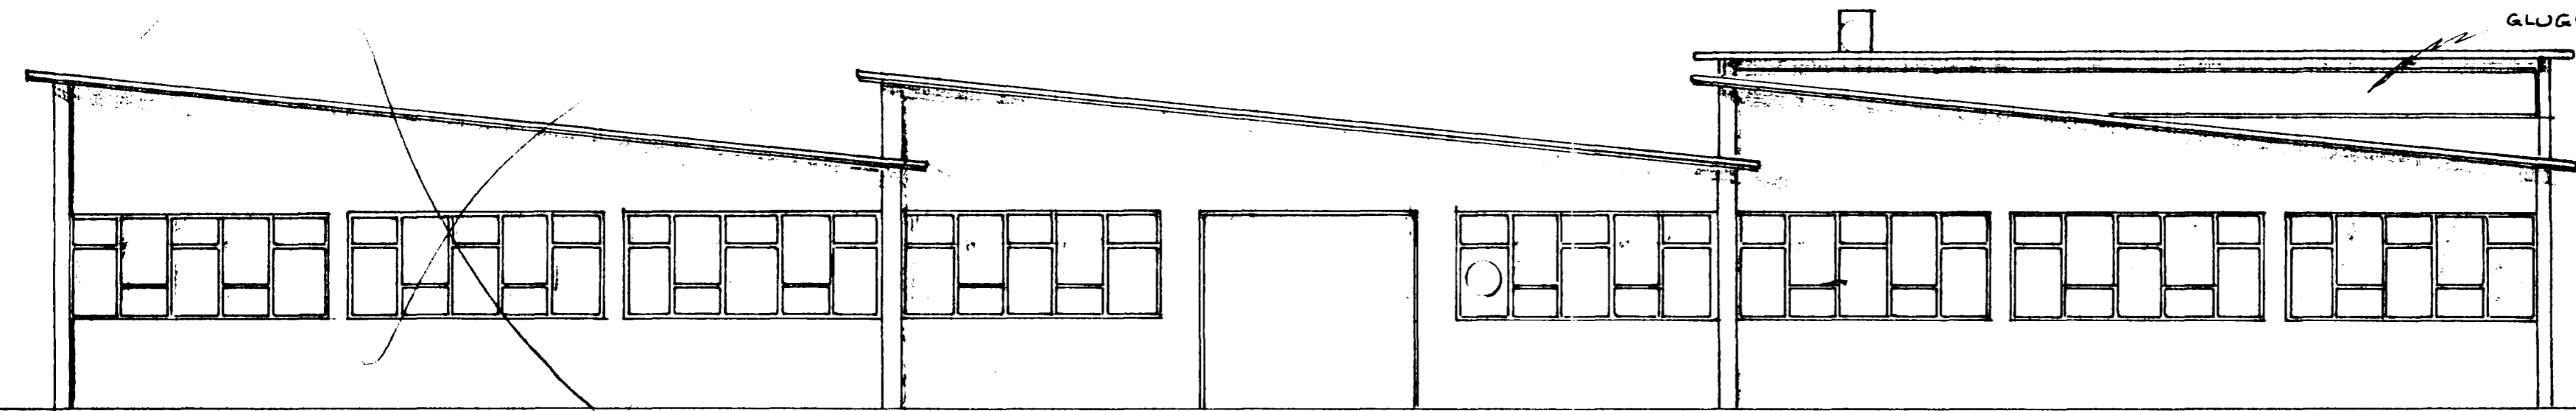

AUSTUR

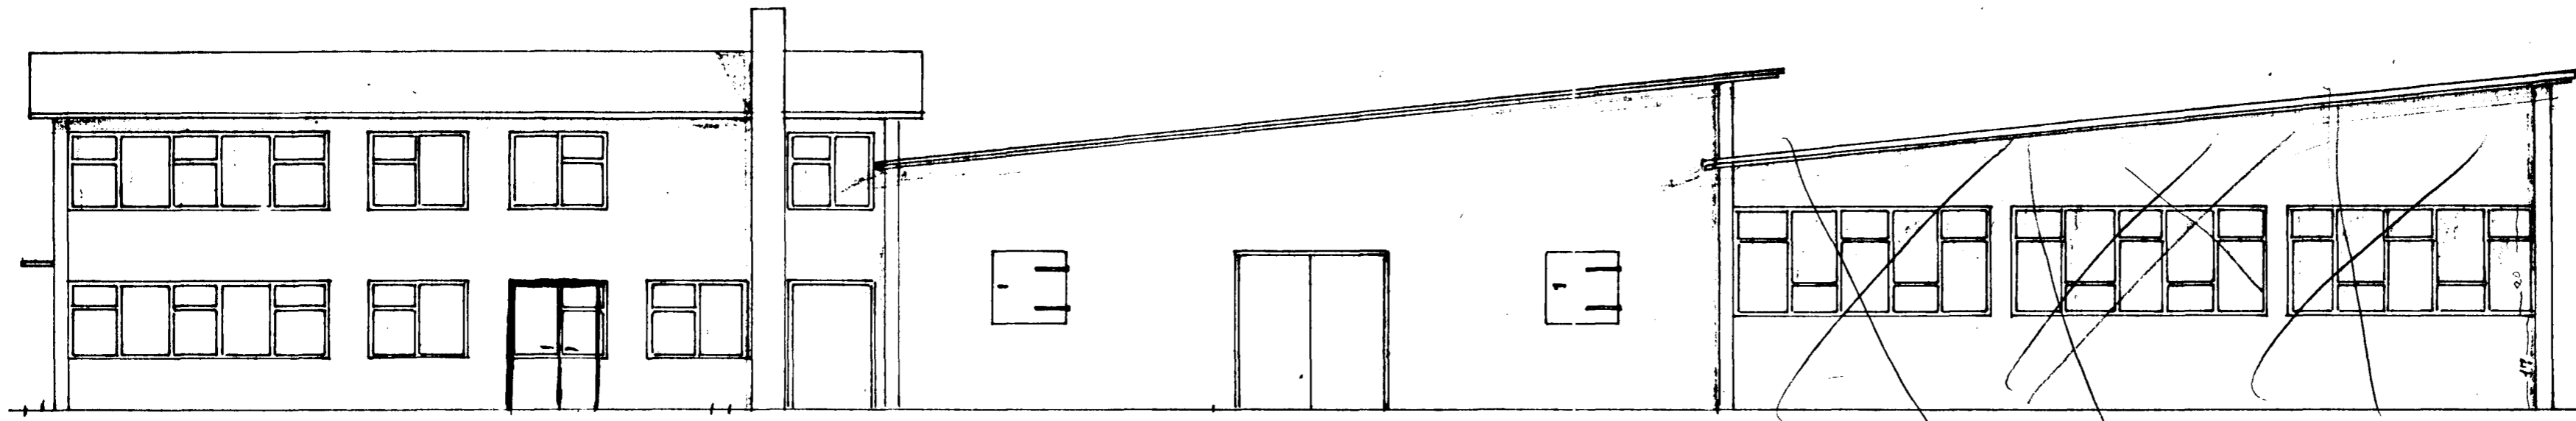


VESTUR




SUÐUR

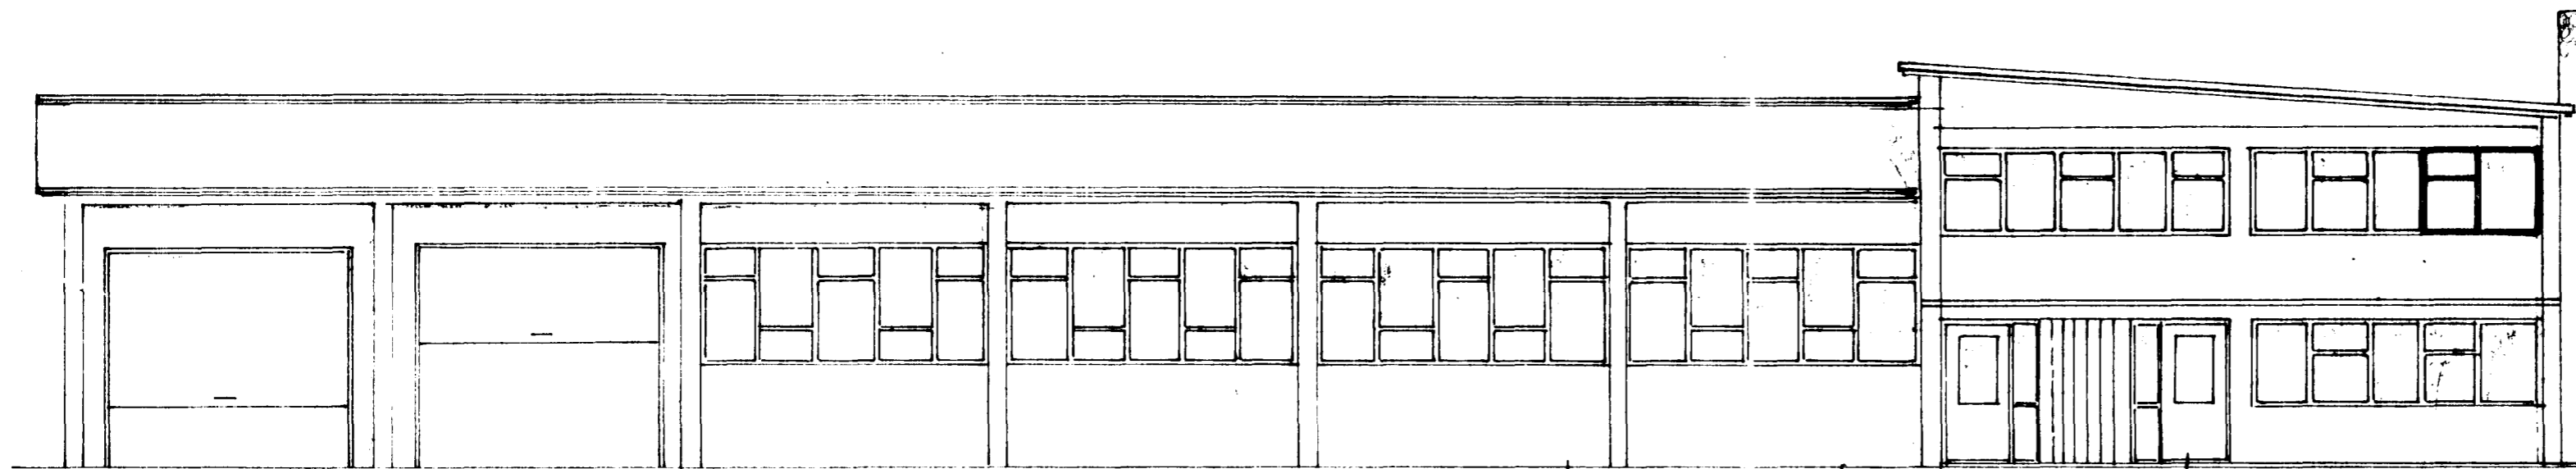

FLATAHRAUNI HLÍÐ AÐ FLATAHRAUNI NORÐUR

Vertical dimension lines on the right side of the drawing, indicating heights of 140 and 270 units.

SEPT '64	ÞAKHALLI GLUGGAR	ÞB
AGÚST '64	BREYTT ÞAKHALLA	ÞB
AGÚST '64	HEKKAD ENDAÐÚS	ÞB
DAGS	BREYTING	GRÖFT
MANNAD ÞB	JÓN BERGSSON	VERKFR MYFL
TEKNIAD ÞB	FISKVERKUNARHÚS	
IRRFARAD	FLATAHRAUNI	
SAMÞYKKT	ÚTLITSMYNDIR	
	M=1 100	DAGS SEPT '64