


H7

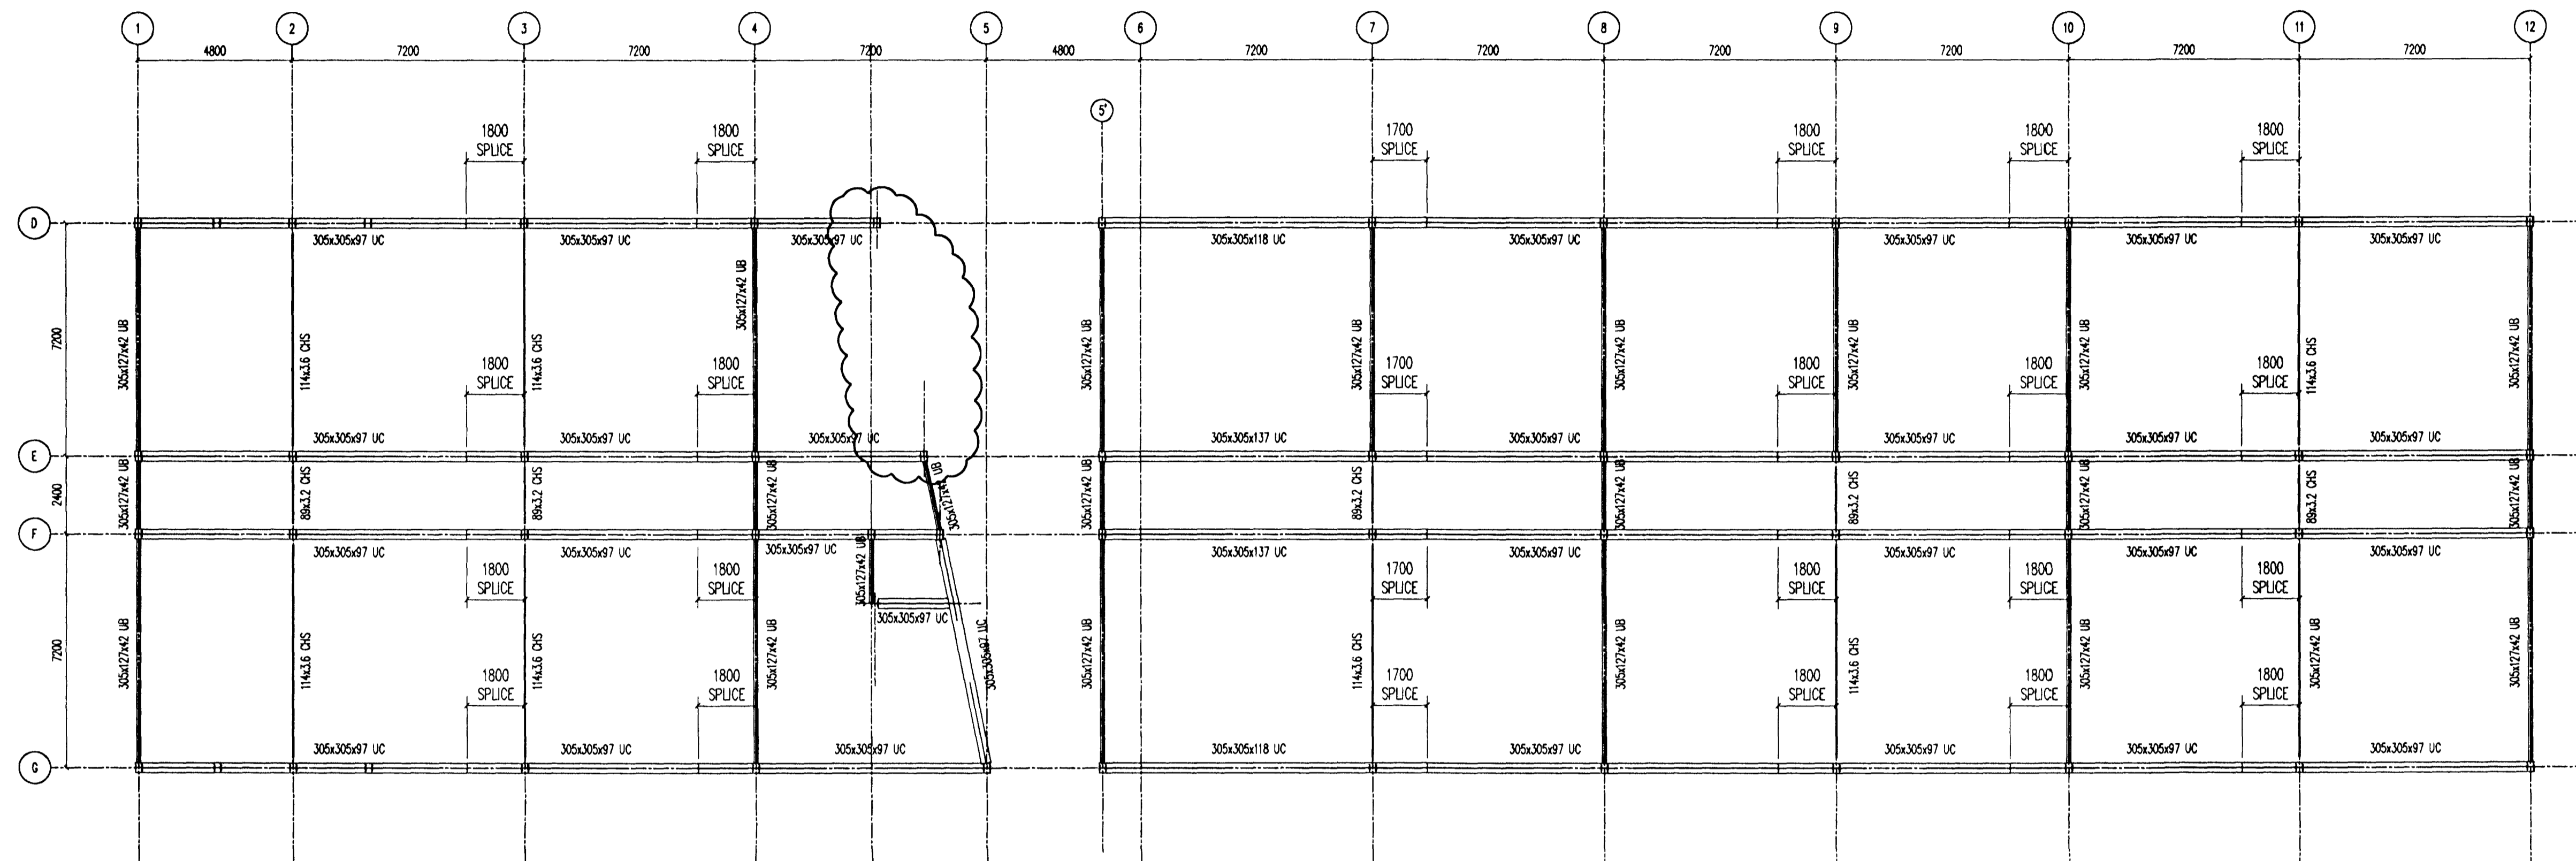

		IÐNSKÓLINN Í HAFNARFIRÐI FLATAHRAUNI 12	
Samþykkt: <i>J.S. V.D.</i> 110261-1177		BURÐARVIRKI STÁLVRKI	
Verknr. ISKH		Dags. 13.04.1999	
E			
D			
C	18.3.99	SRC	RHS Section Adjacent To Stairs Removed
B	12.3.99	SRC	RHS Posts & 305 Beam Removed To Stair Area
A	17.2.99	SRC	Beams Moved To Suit Confirmed Dimensions
REV	DATE	DRAWN	REVISION.
		ATLAS WARD STRUCTURES - Sigurðarvirki Hálfarfarðir SHERBURN, MALTON, Yorkshire ENGLAND, YO17 8PZ Tel: 01944 710422 Telefax: 01944 710590	
PROJECT: FORMACO V.B.V. ISTAK SCHOOL ICELAND		SCALE: 1:125	TEAM.
DRAWING TITLE: SECOND FLOOR PLAN		QUOTE NO./PROJECT NO. N/A	
DRAWN SRC		DATE 08.02.99	CONTRACT NO. 19007
CHECKED	DATE	DRAWING NO. 004	REV. C