


H7

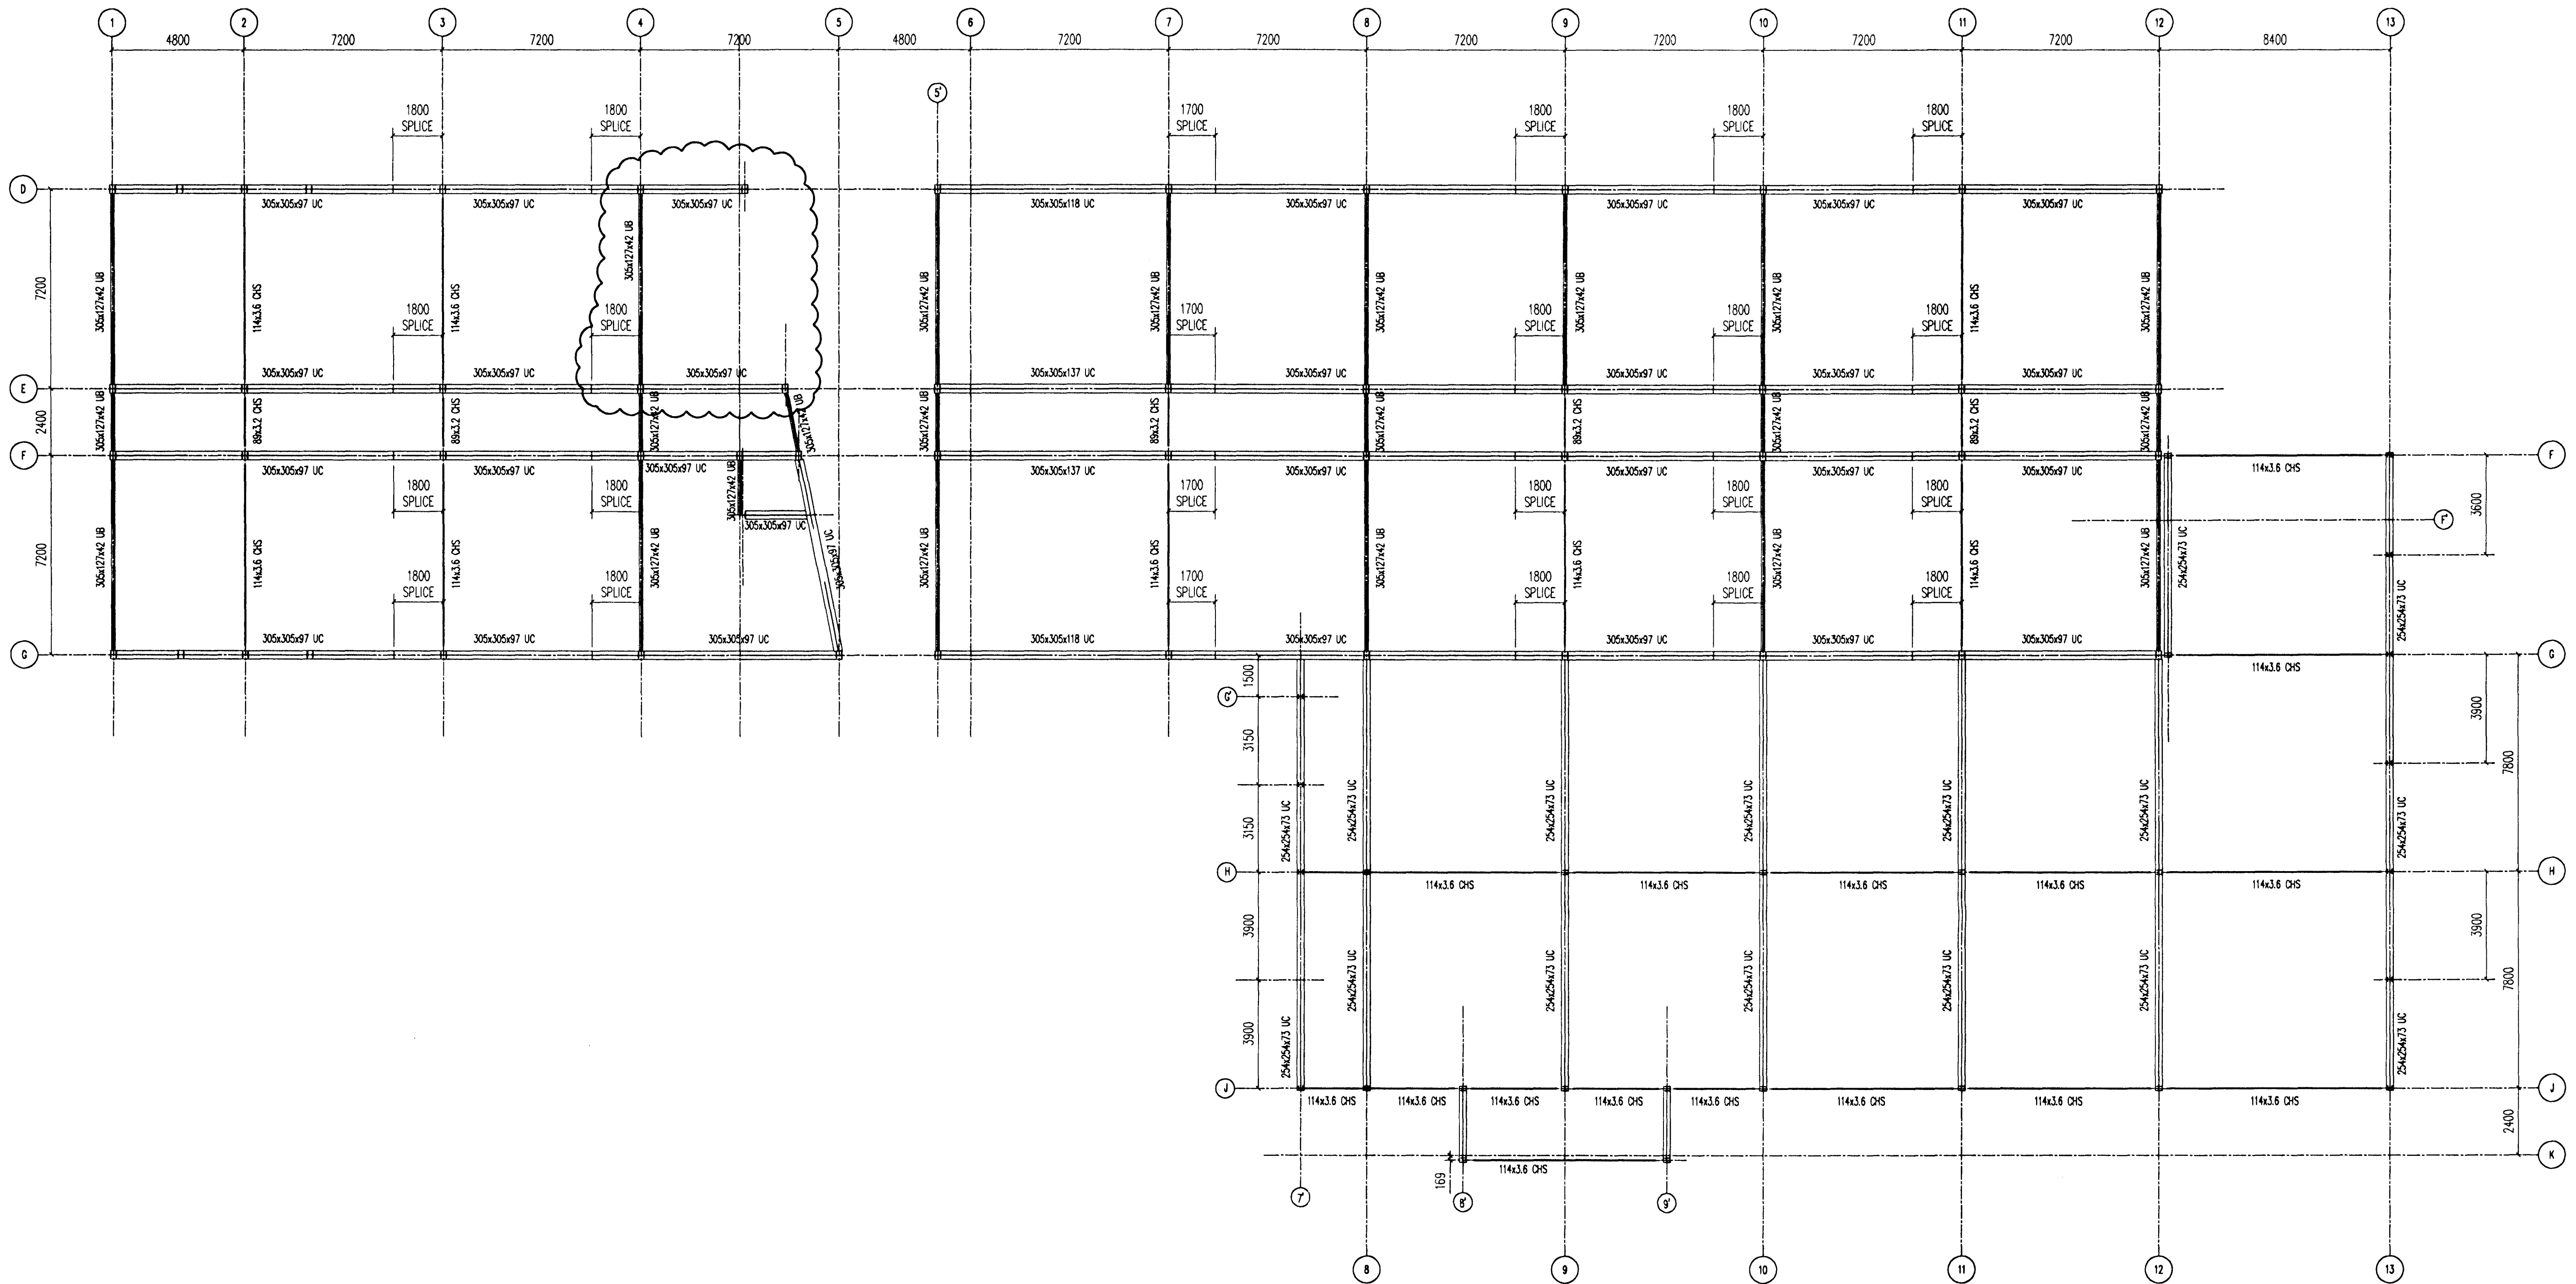

E			
D	18.3.99	SRC	RHS Section Adjacent To Stairs Removed
C	12.3.99	SRC	Canopy Posts Orientation Revd & Posts Added
B	18.2.99	SRC	Revised Offset To Posts On G/Line K
A	17.2.99	SRC	Beams Moved To Suit Confirmed Dimensions
REV	DATE	DRAWN	REVISION.

**ATLAS WARD STRUCTURES**  
 SHERBURN, MALTON,  
 NORTH YORKS. BYGGINGAHLÍÐURIN Hafnarfirðar  
 ENGLAND YO17 8B  
 Tel: 01944 210421  
 Telefax: 01944 210599  
 Signature: Halldórsson

THIS DRAWING IS THE PROPERTY OF ATLAS WARD STRUCTURES AND MUST NOT BE COPIED OR REPRODUCED EITHER IN WHOLE OR PART WITHOUT WRITTEN PERMISSION.

**VBV Verkefni**  
**Bjarna Viðarssonar ehf**  
 Síðumúla 20, 108 Reykjavík, sími 588 82 88, fax 588 08 68

Sambýkt: *[Signature]* 40261-4777  
 Verknr. ISKH

ÍÐNSKÓLINN Í HAFNARFIRÐI  
 FLATAHRAUNI 12

BURÐARVIRKI  
 STÁLVERKI  
 Dags. 13.04.1999

PROJECT: FORMACO V.B.V. ISTAK SCHOOL ICELAND	SCALE: 1:125	TEAM:
DRAWING TITLE: FIRST FLOOR PLAN	QUOTE NO./PROJECT NO. N/A	CONTRACT NO. 19007
DRAWN SRC	DATE 08.02.99	CHECKED DATE
DRAWING NO. 003	REV. D	