


H7

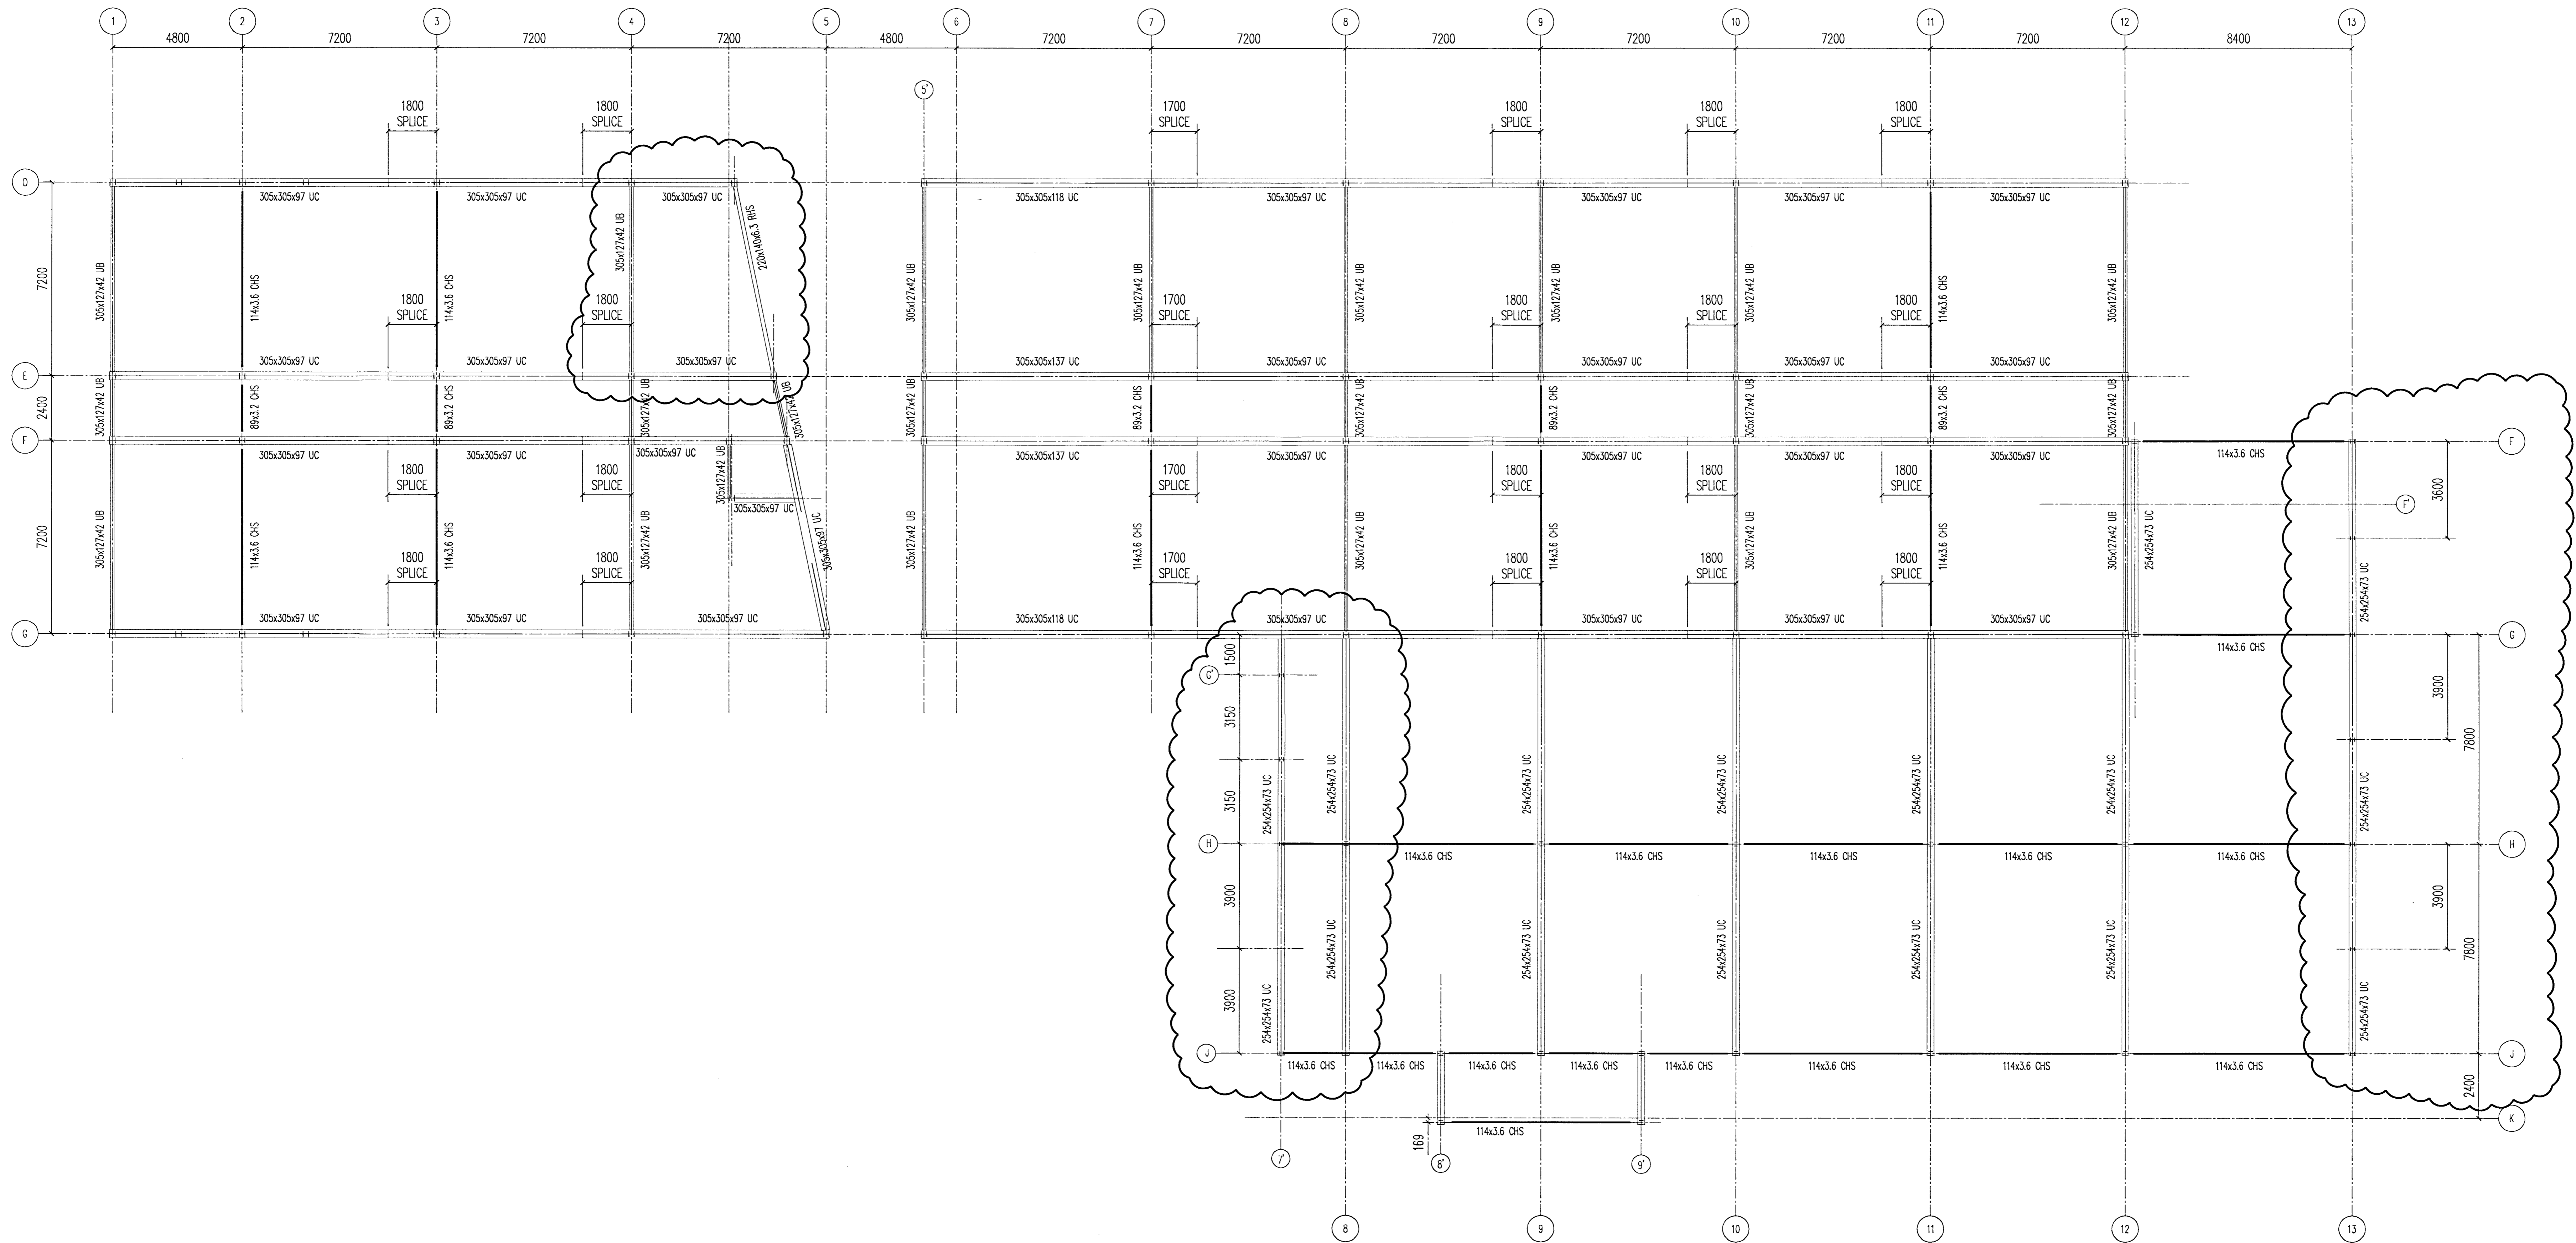

REV	DATE	DRAWN	REVISION
F			
D			
C	12.3.99	SRC	Canopy Posts Orientation Revd & Posts Added
B	18.2.99	SRC	Revised Offset To Posts On G/Line K
A	17.2.99	SRC	Beams Moved To Suit Confirmed Dimensions

ATLAS WARD
STRUCTURES Ltd.

ATLAS WARD STRUCTURES
SHERBURN, MALTON,
NORTH YORKS,
ENGLAND. YO17 8PZ
Tel: 01944 710421
Telefax: 01944 710590

THIS DRAWING IS THE PROPERTY OF ATLAS WARD STRUCTURES
AND MUST NOT BE COPIED OR REPRODUCED EITHER IN
WHOLE OR PART WITHOUT WRITTEN PERMISSION.

PROJECT: FORMACO V.B.V. ISTAK SCHOOL ICELAND		SCALE: 1:125	TEAM:
DRAWING TITLE: FIRST FLOOR PLAN		QUOTE NO./PROJECT NO. N/A	
DRAWN SRC		DATE 08.02.99	CHECKED DATE
DRAWING NO. 003		CONTRACT NO. 19007	REV. C