


H7

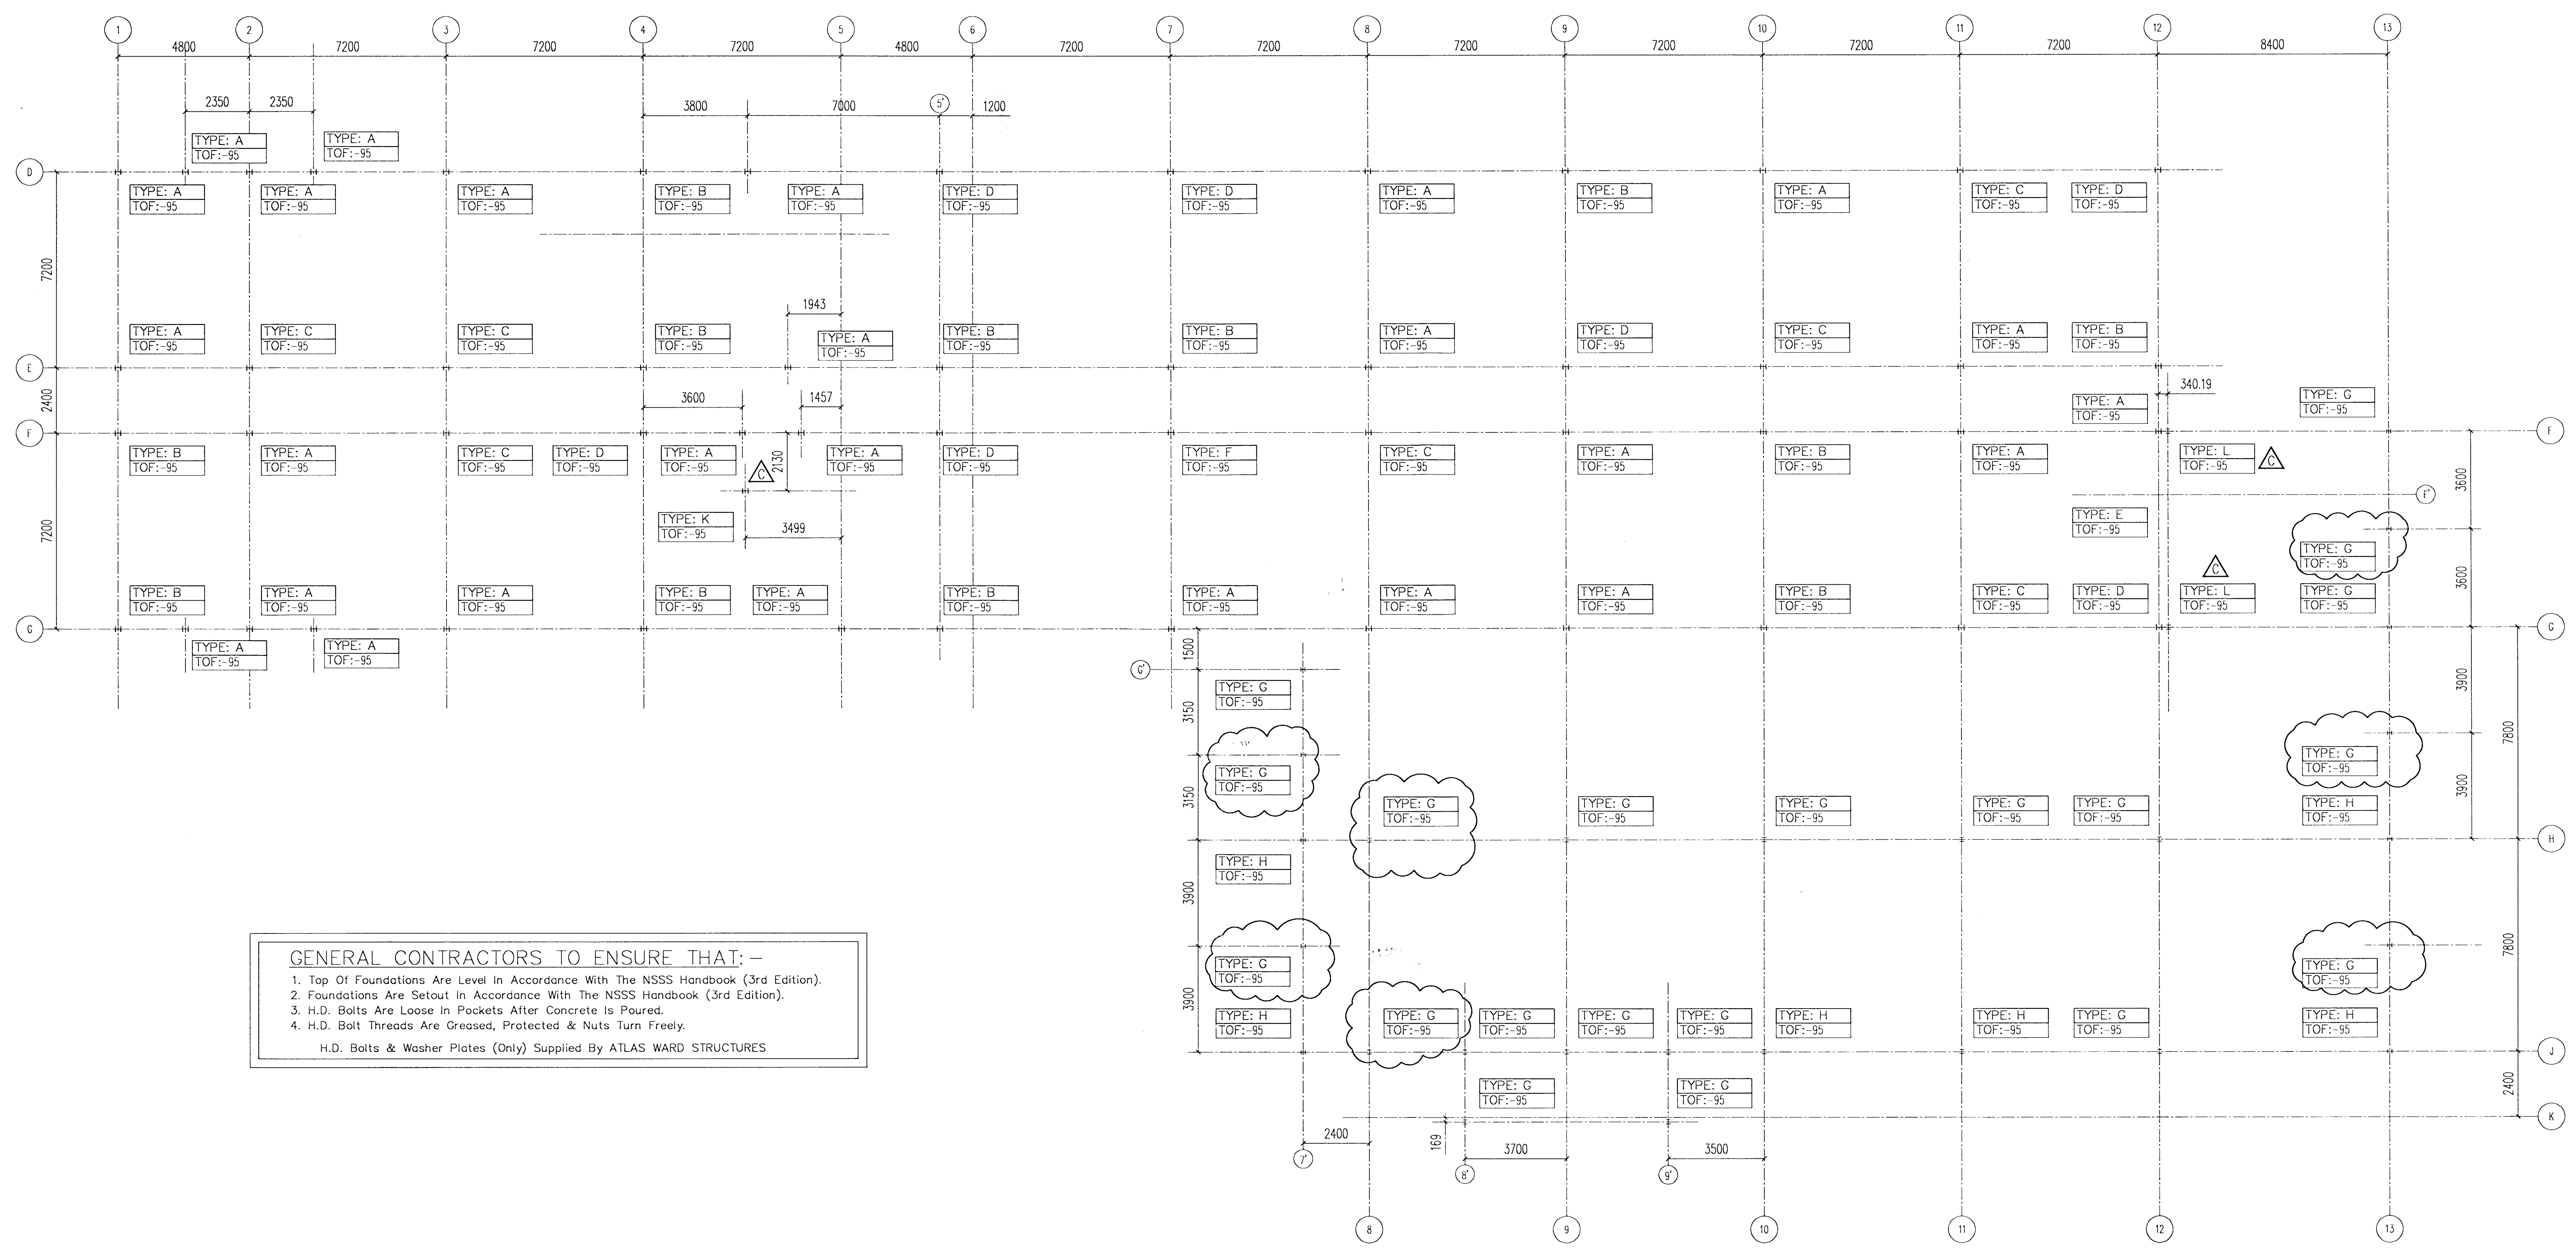

GENERAL CONTRACTORS TO ENSURE THAT:-

1. Top Of Foundations Are Level In Accordance With The NSSS Handbook (3rd Edition).
2. Foundations Are Setout In Accordance With The NSSS Handbook (3rd Edition).
3. H.D. Bolts Are Loose In Pockets After Concrete Is Poured.
4. H.D. Bolt Threads Are Greased, Protected & Nuts Turn Freely.

H.D. Bolts & Washer Plates (Only) Supplied By ATLAS WARD STRUCTURES

REV	DATE	DRAWN	REVISION.
E			
D	12.3.99	SRC	Base Type J Removed & Canopy Bases Added
C	23.2.99	SRC	Base Types On G/Line 12 Revised & Dim Added
B	18.2.99	SRC	Revised Offset To Posts On G/Line K
A	17.2.99	SRC	Dimensions Added

ATLAS WARD STRUCTURES Ltd.

SHERBURN, MALTON,
NORTH YORKS,
ENGLAND. YO17 8PZ
Tel: 01944 710421
Telefax: 01944 710590

THIS DRAWING IS THE PROPERTY OF ATLAS WARD STRUCTURES AND MUST NOT BE COPIED OR REPRODUCED EITHER IN WHOLE OR PART WITHOUT WRITTEN PERMISSION.

PROJECT: FORMACO V.B.V. ISTAK SCHOOL ICELAND	SCALE: 1:125	TEAM.
DRAWING TITLE: FOUNDATION PLAN	QUOTE NO./PROJECT NO. N/A	CONTRACT NO. 19007
DRAWN SRC	DATE 08.02.99	CHECKED DATE
DRAWING NO. 001	REV. D	