




H7

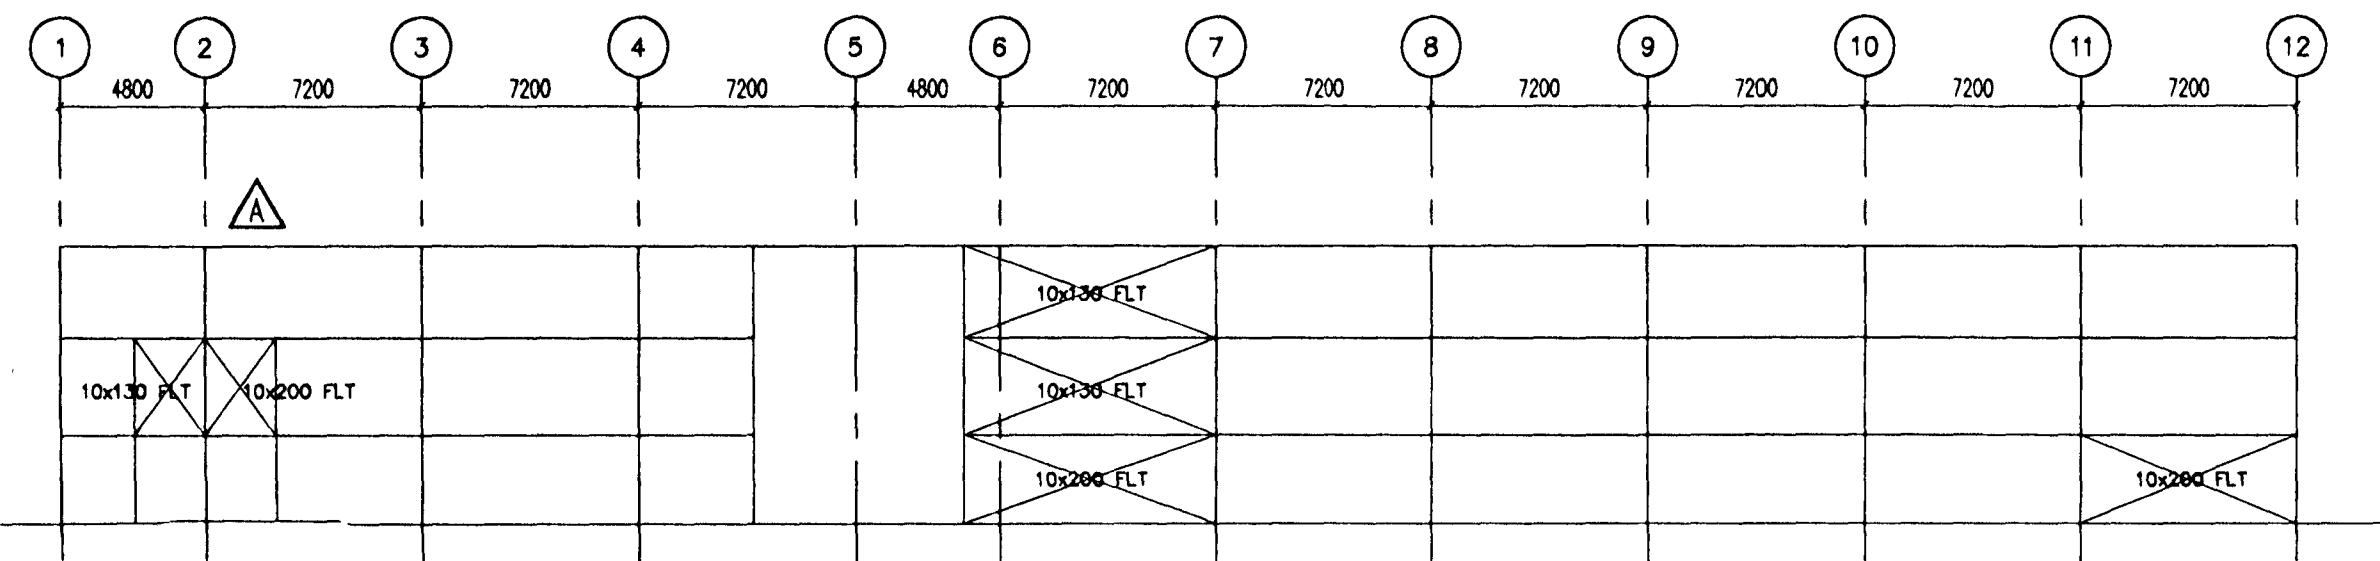


ELEVATION ON G/LINE D

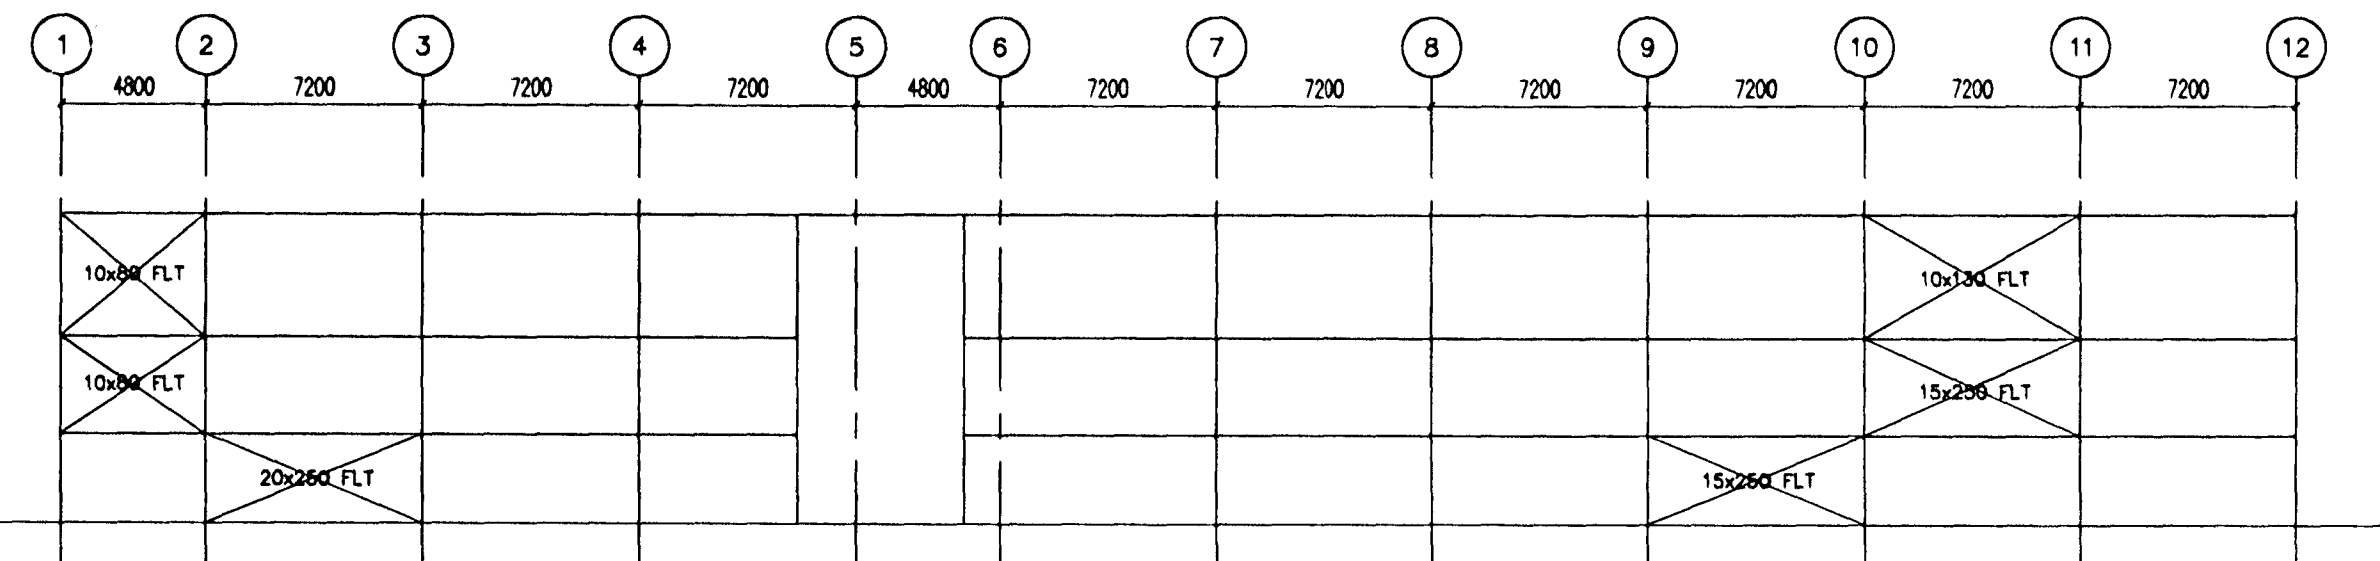


ELEVATION ON G/LINE E

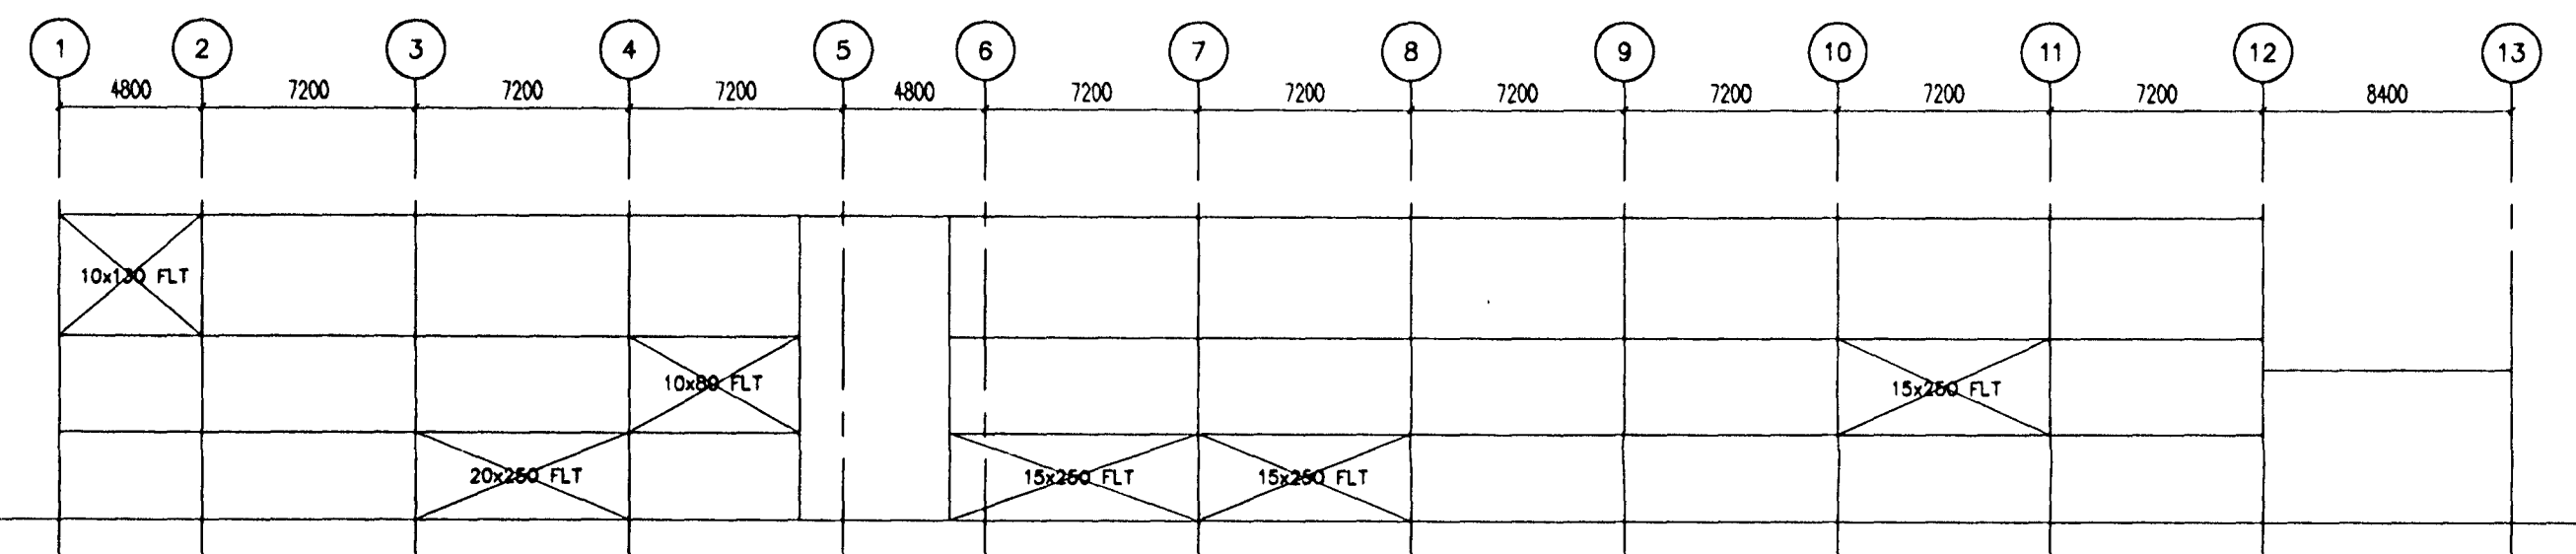


ELEVATION ON G/LINE F

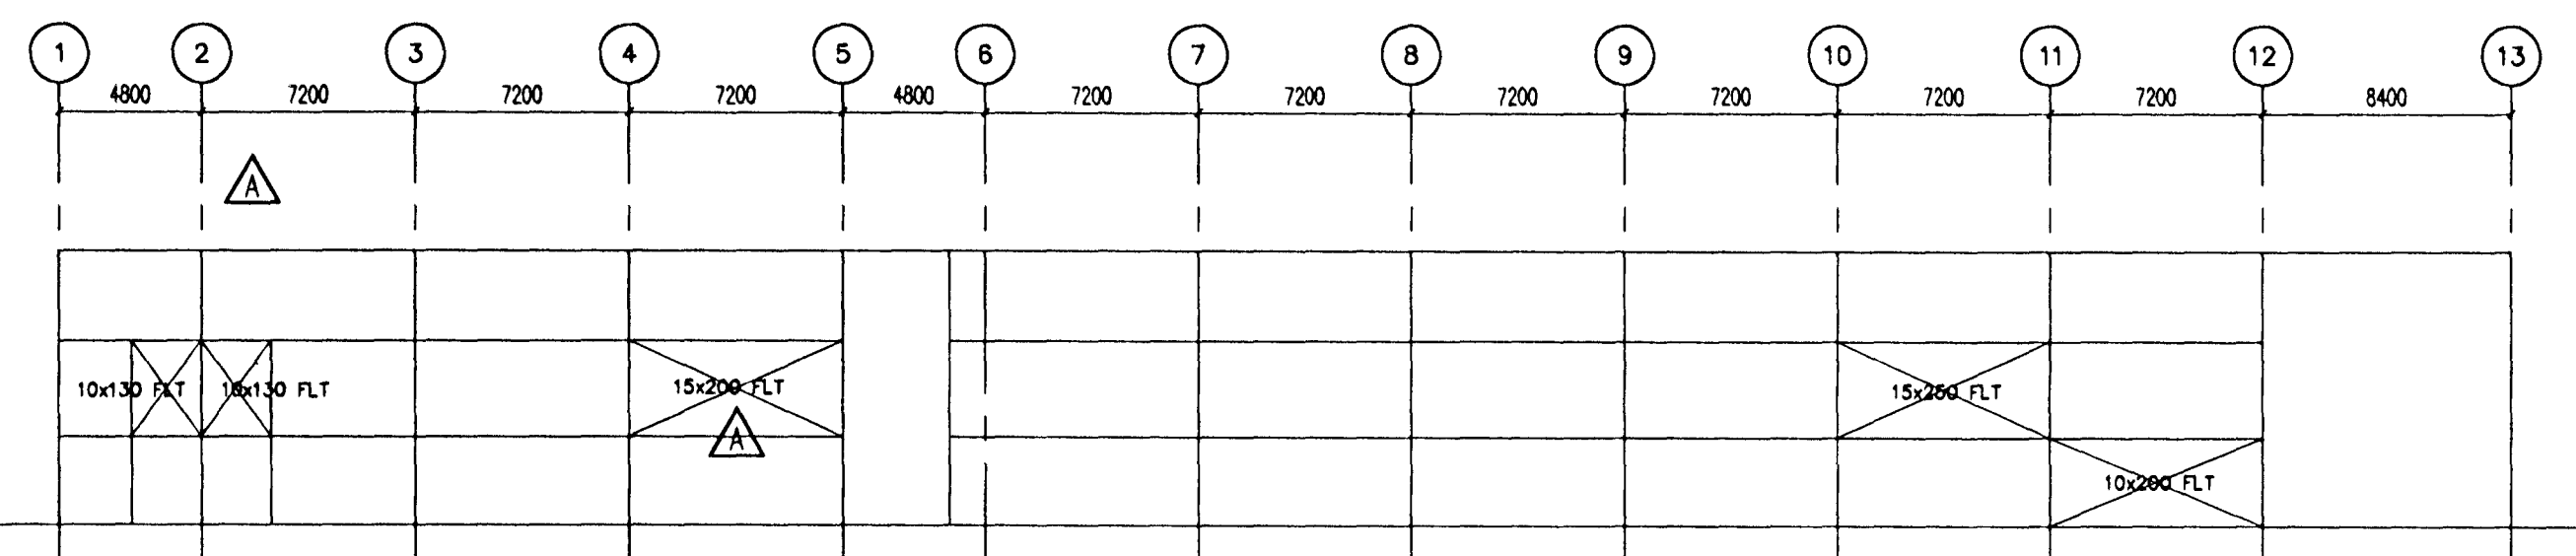


ELEVATION ON G/LINE G

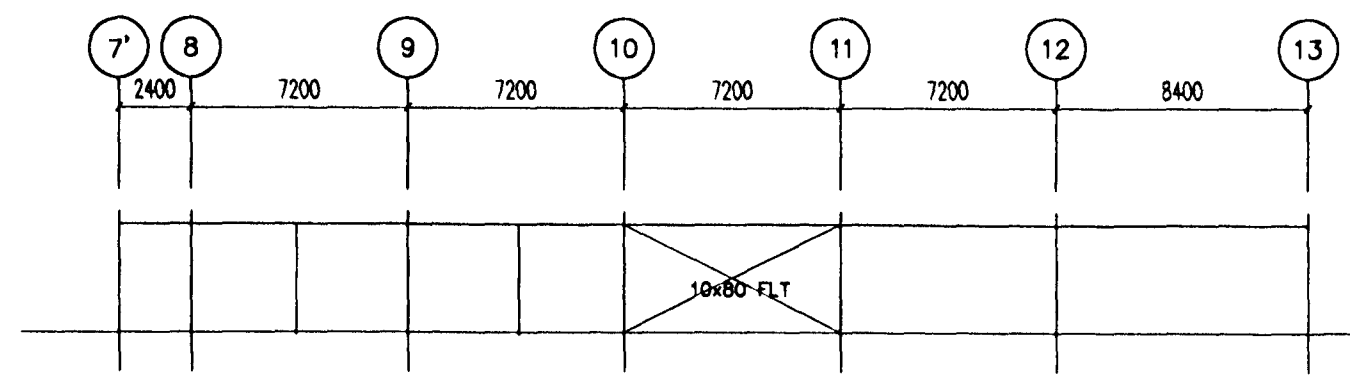


ELEVATION ON G/LINE J

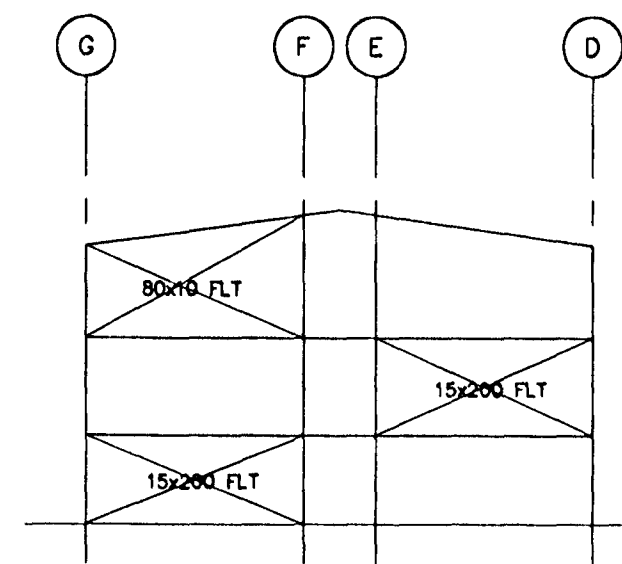


ELEVATION ON G/LINE 1

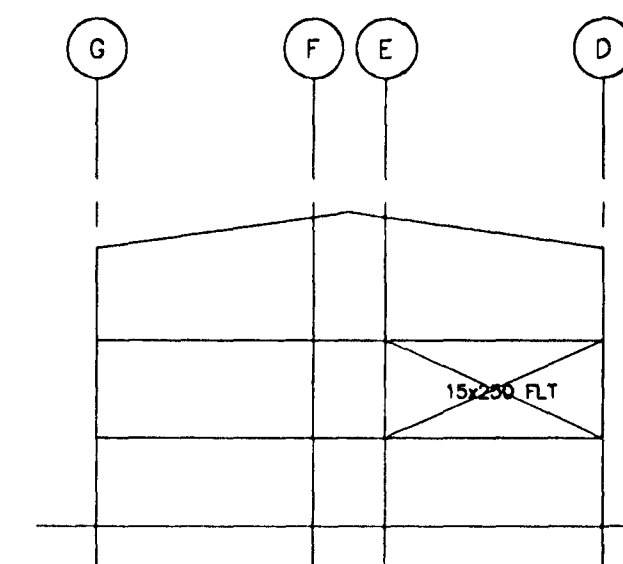


ELEVATION ON G/LINE 8

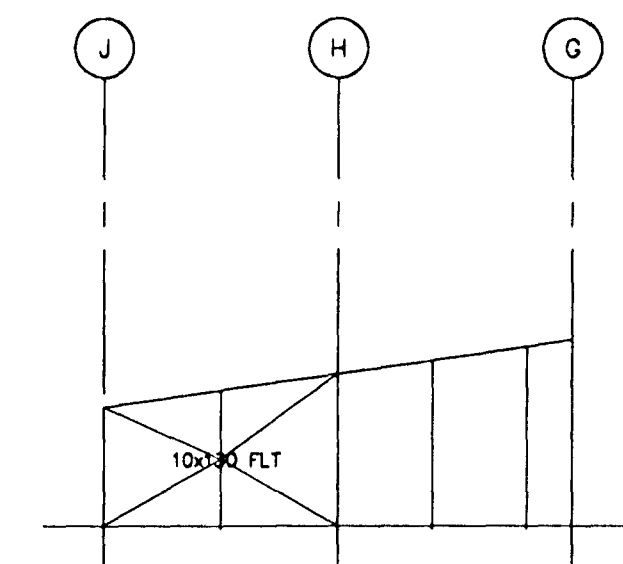


ELEVATION ON G/LINE 7'

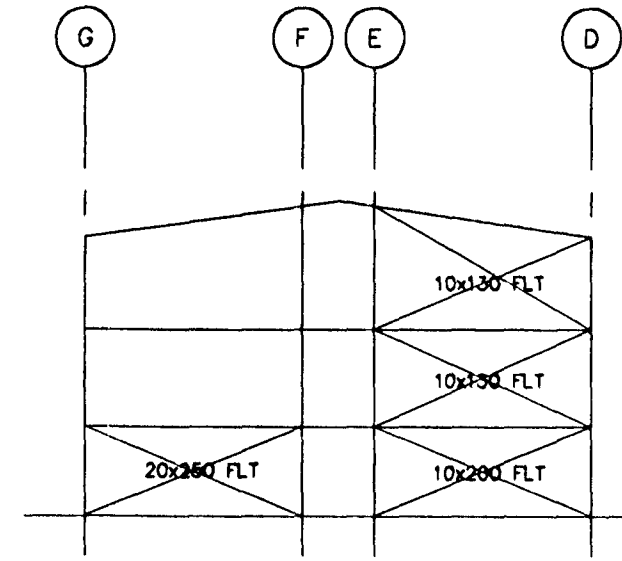


ELEVATION ON G/LINE 4

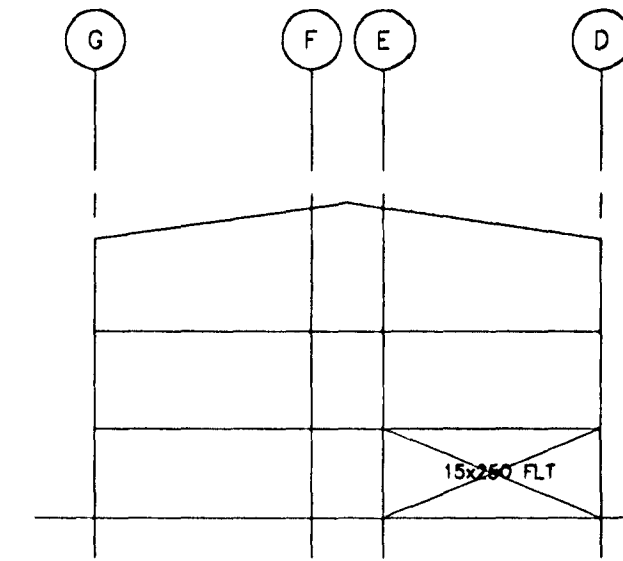


ELEVATION ON G/LINE 9

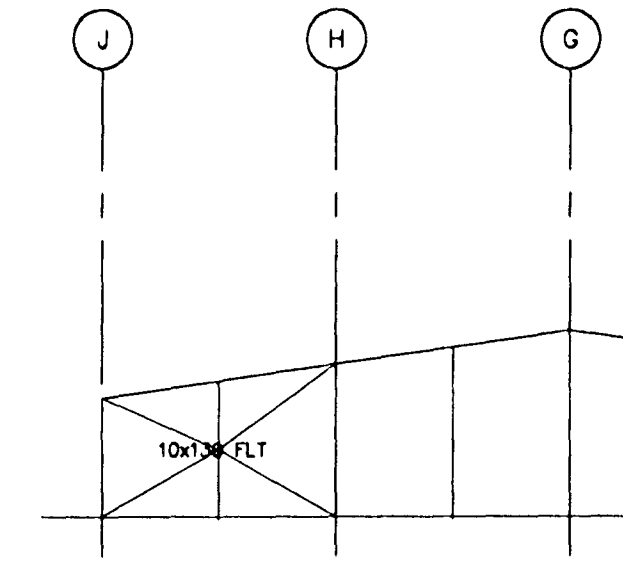


ELEVATION ON G/LINE 13

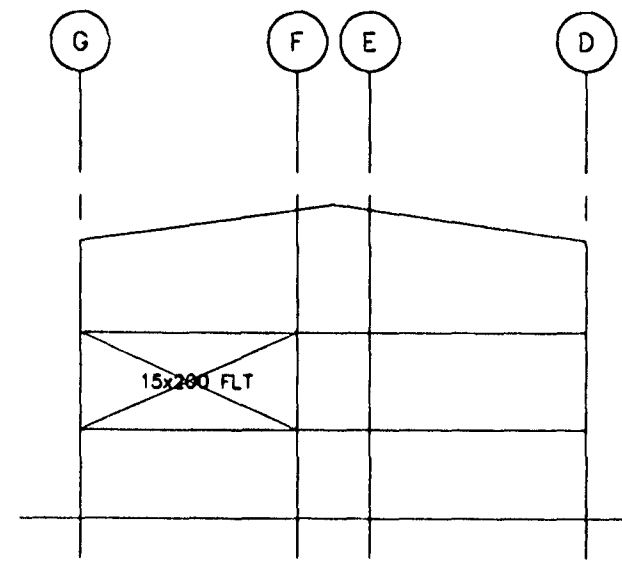


ELEVATION ON STAIR EDGE LINE

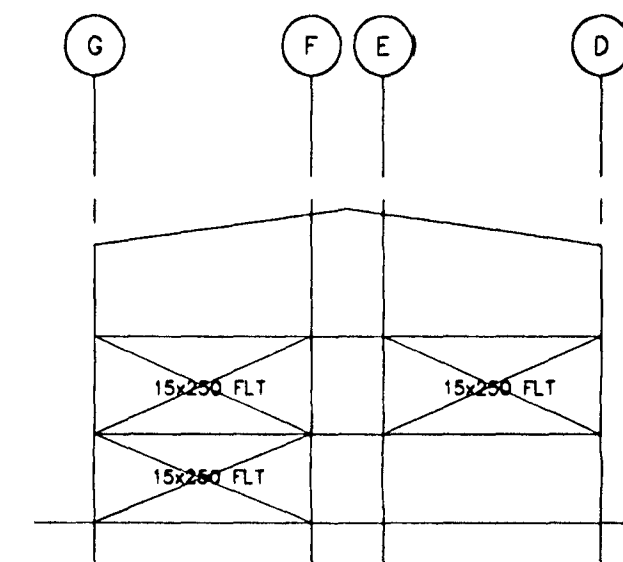


ELEVATION ON G/LINE 10

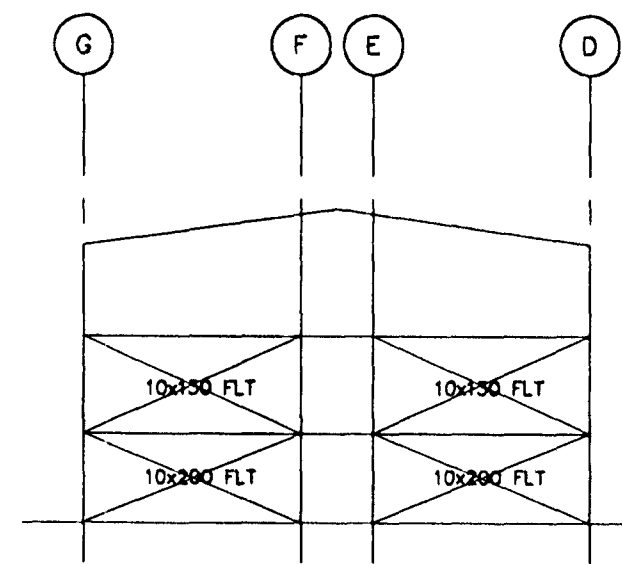


ELEVATION ON G/LINE 5'

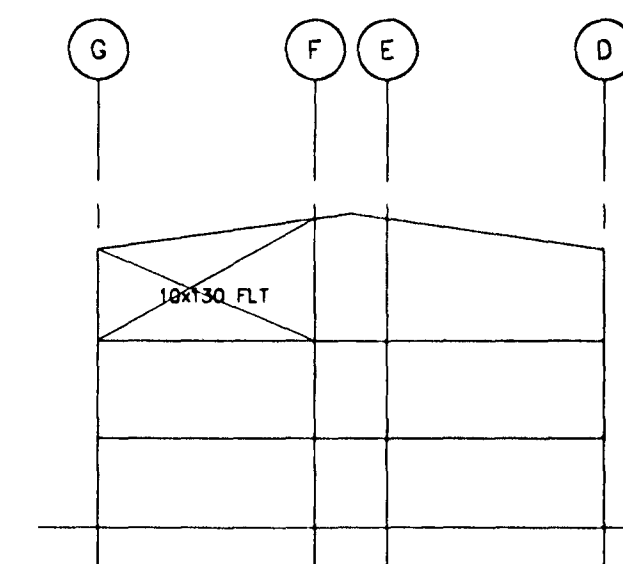

ELEVATION ON G/LINE 11

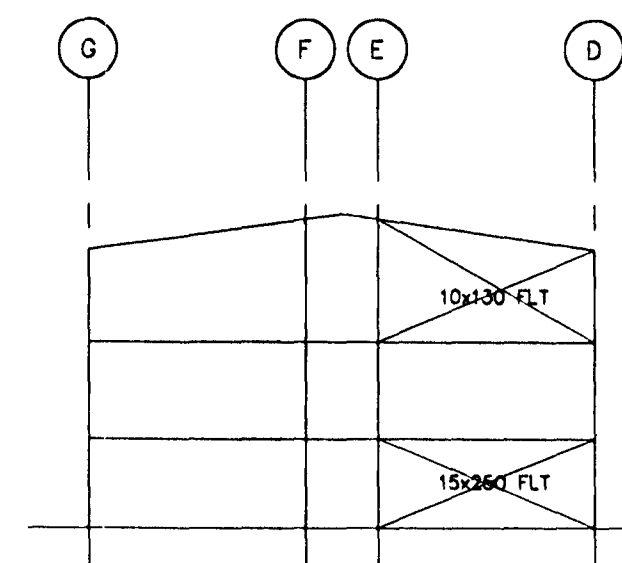

ELEVATION ON G/LINE 7

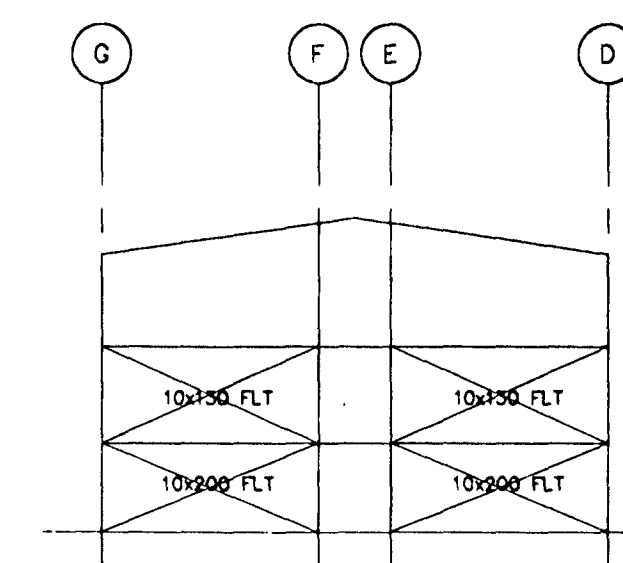

ELEVATION ON G/LINE 12

| | | | |
|-----|---------|-------|--|
| D | | | |
| C | | | |
| B | 12.3.99 | SRC | Posts Added To Grid Lines 7' & 13 |
| A | 23.2.99 | SRC | Intermediate Posts Between G/Lines 1-3 From 2nd Floor To Roof Lvl Removed & Bracing Revd |
| REV | DATE | DRAWN | REVISION. |

ATLAS WARD
STRUCTURES Ltd.
 ATLAS WARD STRUCTURES
 SHERBURN, MALTON,
 NORTH YORKS,
 ENGLAND, YO17 8PZ
 Tel: 01944 710421
 Telex: 52354 WARDBR G
 Telefax: 01944 710590

THIS DRAWING IS THE PROPERTY OF ATLAS WARD STRUCTURES AND MUST NOT BE COPIED OR REPRODUCED EITHER IN WHOLE OR PART WITHOUT WRITTEN PERMISSION.

| | | |
|--|---------------------------|--------------------|
| PROJECT: FORMACO ISTAK SCHOOL ICELAND | SCALE: 1:250 | TEAM: |
| DRAWING TITLE: ELEVATIONS SHOWING VERTICAL BRACING | QUOTE NO./PROJECT NO. N/A | CONTRACT NO. 19007 |
| DRAWN SRC | DATE 18.02.99 | CHECKED DATE |
| DRAWING NO. 006 | REV. B | |

VBV Verkeðlistofa
Bjarna Viðarssonar ehf
 Síðumúla 20, 108 Rvk, sími 588 62 68, fax 588 08 68

Samþykkt: *[Signature]* 110261-9/99
 Verknr. ISKH

ÍÐNSKÓLINN Í HAFNARFIRÐI
 FLATAHRAUNI 12

BURÐARVRKI
 STÁLVRKI

Dags. 13.04.1999