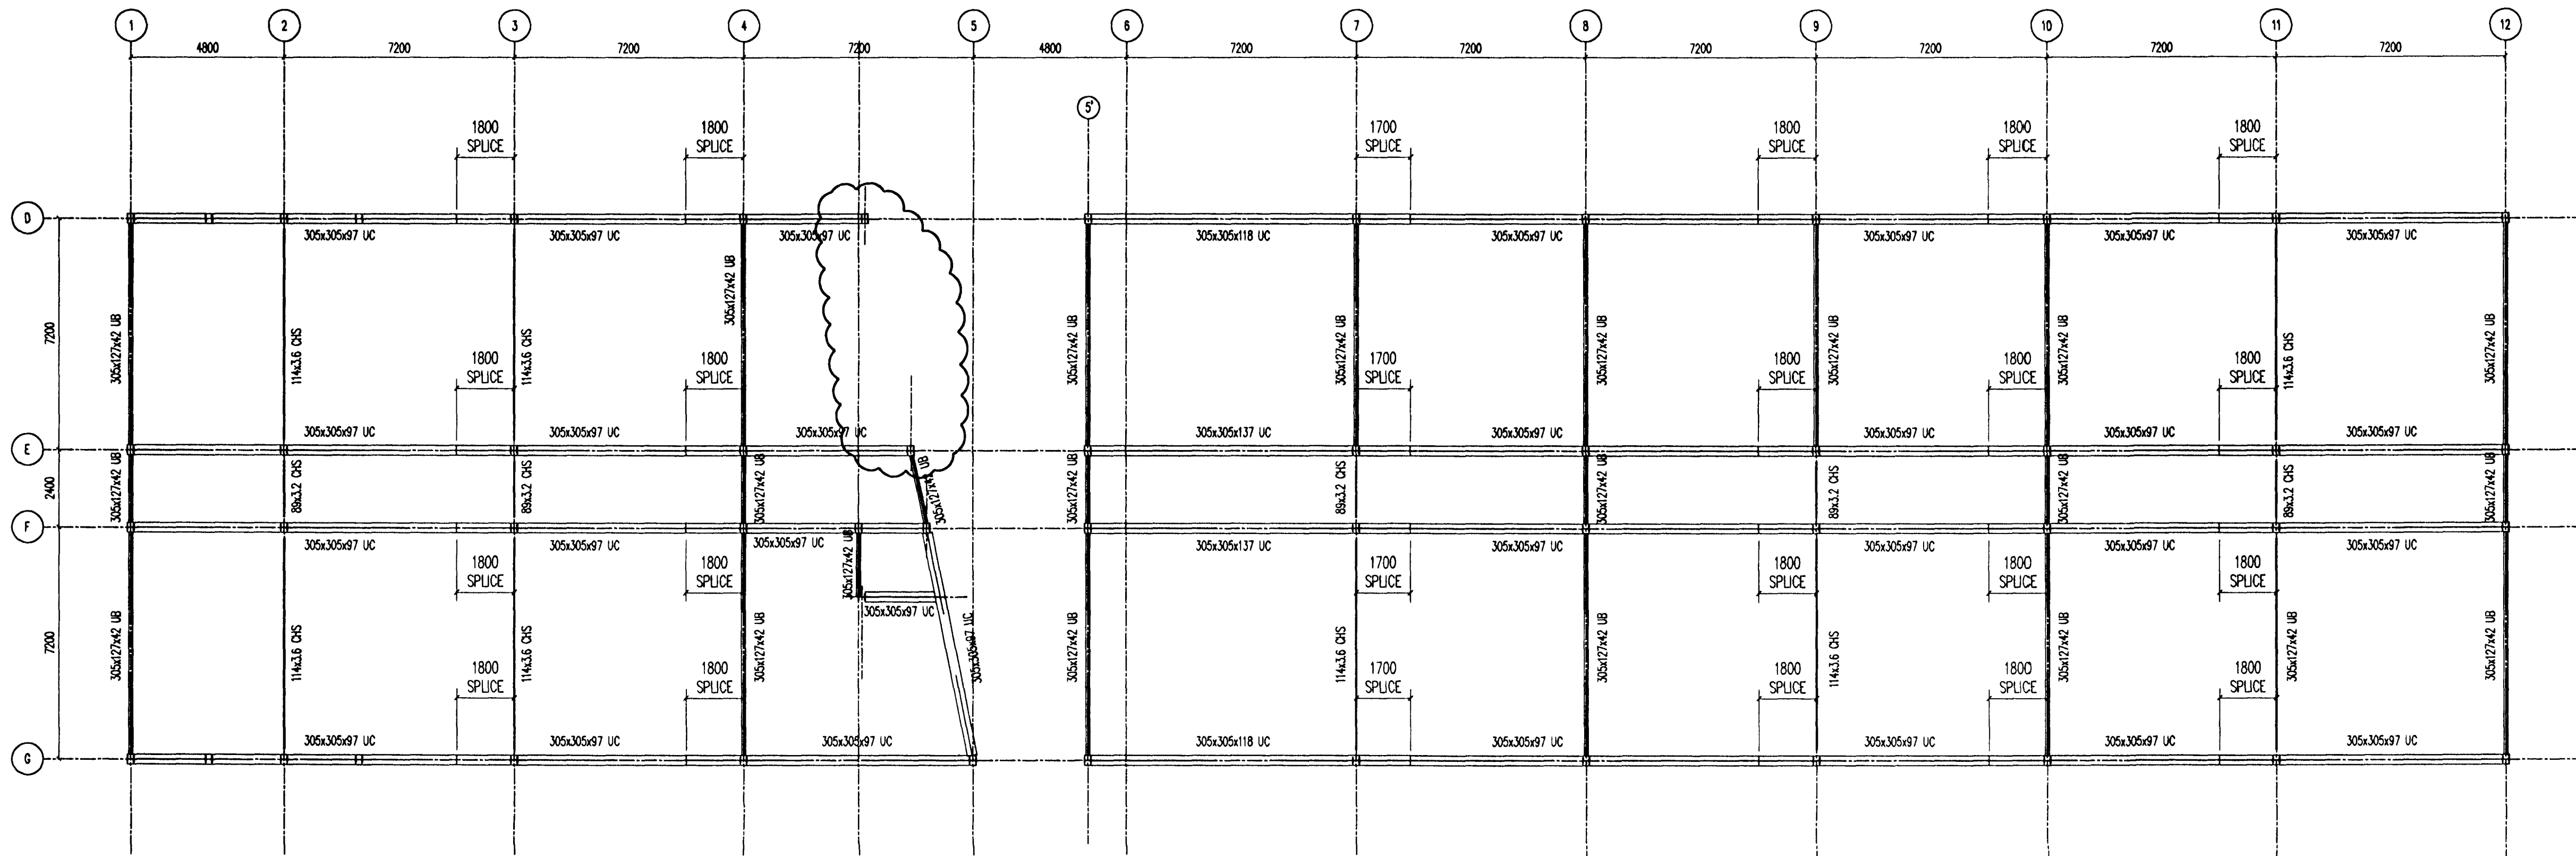

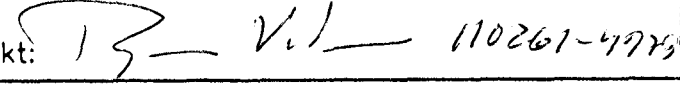
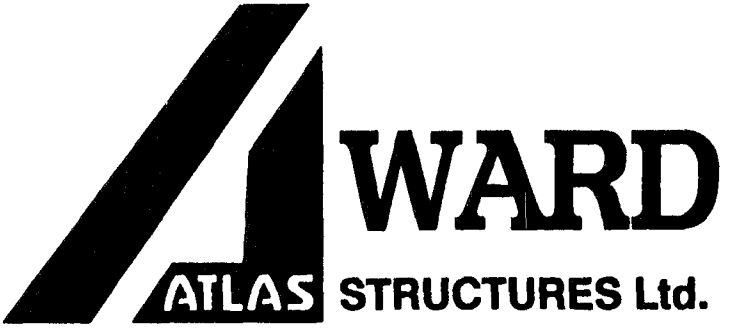


H7



		IDNSKÓLINN I HAFNARFIRÐI FLATAHRAUNI 12	
Samþykkt:  110261-9773		BURÐARVIRKI STÁLVIKRI	
Verknr. ISKH		Dags. 13.04.1999	
E			
D			
C	18.3.99	SRC	RHS Section Adjacent To Stairs Removed
B	12.3.99	SRC	RHS Posts & 305 Beam Removed To Stair Area
A	17.2.99	SRC	Beams Moved To Suit Confirmed Dimensions
REV	DATE	DRAWN	REVISION.
		ATLAS WARD STRUCTURES SHERBURN, MALTON, NORTH YORKS. ENGLAND. YO17 8PZ Tel: 01944 710421 Telex: 52354 WARDBR G Telefax: 01944 710590	
PROJECT: FORMACO V.B.V. ISTAK SCHOOL ICELAND		SCALE: 1:125	
DRAWING TITLE: SECOND FLOOR PLAN		TEAM: QUOTE NO/PROJECT NO. N/A	
DRAWN SRC		CONTRACT NO. 19007	
DATE	CHECKED	DATE	REV.
08.02.99			C
DRAWING NO. 004		REV. C	