


H7

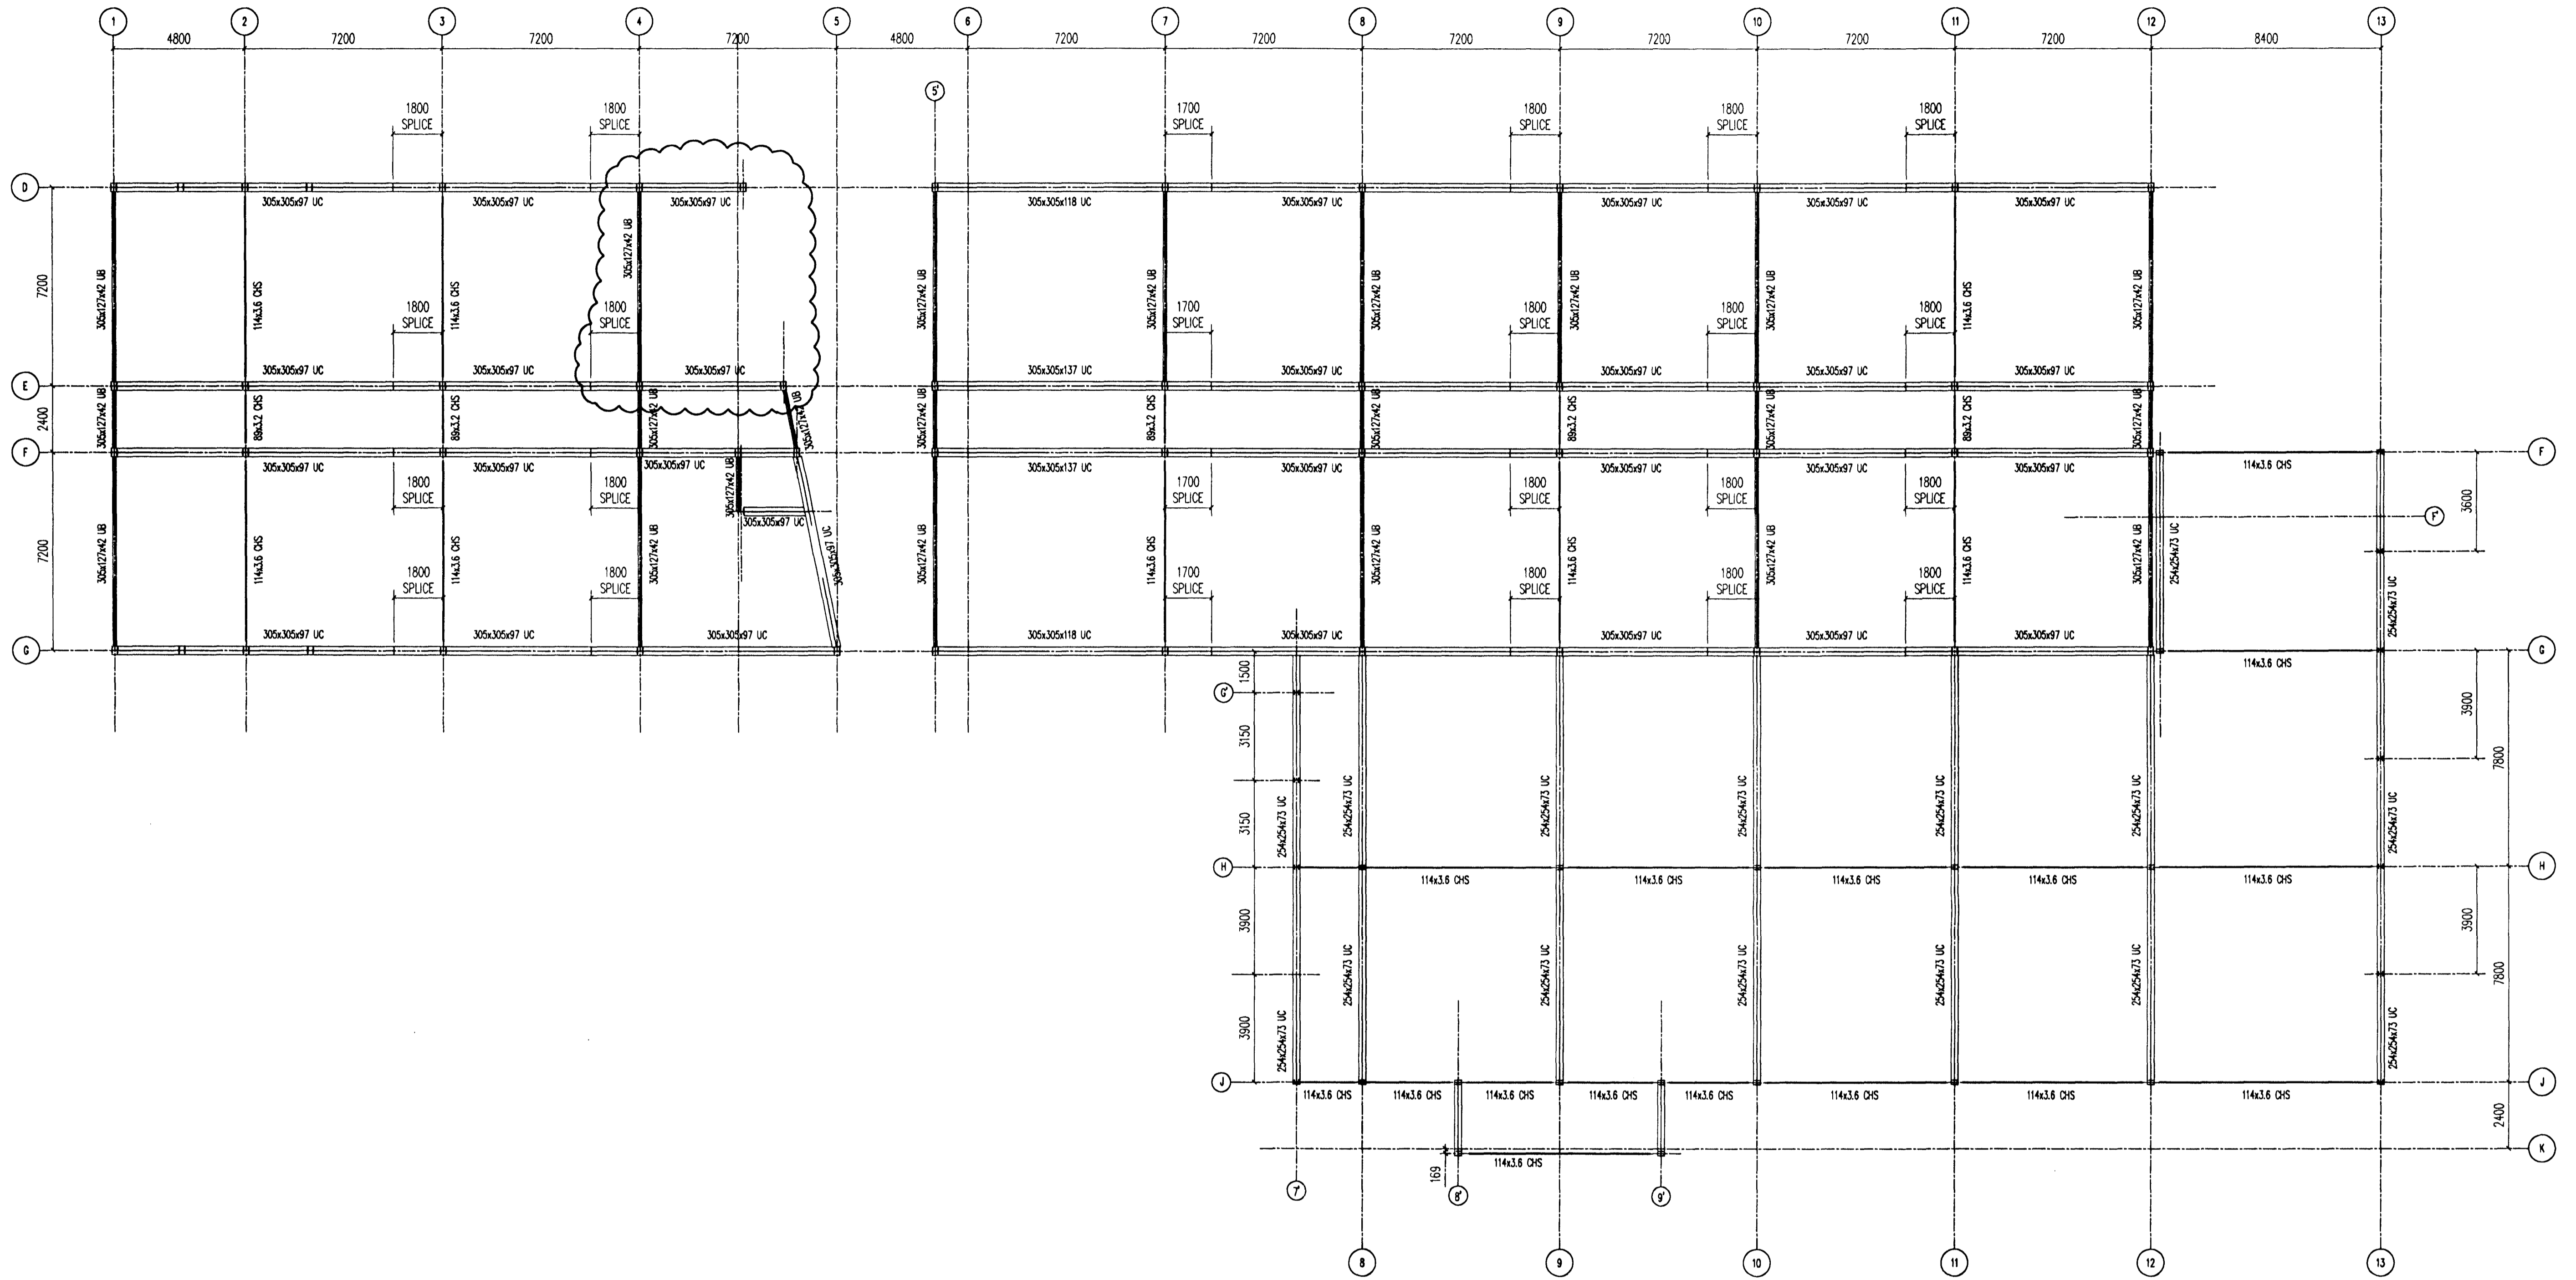

E			
D	18.3.99	SRC	RHS Section Adjacent To Stairs Removed
C	12.3.99	SRC	Canopy Posts Orientation Revd & Posts Added
B	18.2.99	SRC	Revised Offset To Posts On G/Line K
A	17.2.99	SRC	Beams Moved To Suit Confirmed Dimensions
REV	DATE	DRAWN	REVISION.

**WARD**  
ATLAS STRUCTURES Ltd.

ATLAS WARD STRUCTURES  
SHERBURN, MALTON,  
NORTH YORKS,  
ENGLAND, YO17 8PZ  
Tel: 01944 710421  
Telex: 52354 WARDGB G  
Telefax: 01944 710590

THIS DRAWING IS THE PROPERTY OF ATLAS WARD STRUCTURES AND MUST NOT BE COPIED OR REPRODUCED EITHER IN WHOLE OR PART WITHOUT WRITTEN PERMISSION.

**VBV Verkfærðistofa**  
**Bjarna Viðarssonar ehf**  
Sórnúlla 20, 108 Pvk, sími 588 82 88, fax 588 08 88

Samþykkt: *[Signature]* 110261-4977  
Verknr. ISKH

ÞENSKÓLINN Í HAFNARFIRÐI  
FLATAHRAUNI 12

BURÐARVIRKI  
STÁLVIKRI

Dags. 13.04.1999

PROJECT.	FORMACO	SCALE.	1:125	TEAM.	
DRAWN	SRC	DATE	08.02.99	QUOTE NO./PROJECT NO.	N/A
DRAWING TITLE.	FIRST FLOOR PLAN	CONTRACT NO.	19007	DRAWING NO.	003
DATE	08.02.99	CHECKED	DATE	REV.	D