

grunnmynd 1/50

1	02/99	breytt bitum og bendingu plötunnar	sp
BR.	DAGS.	EDLI BREITINGA	SIGN.

Flatahraun 31  
Hafnarfirði 2. áfangi

Þakvirki

mælikv 1/50

DAGS


VERK NR. 9060

TEIKN NR. 01-05 a

HANNAÐ sig 2411483009

TEIKNAD

YFIRFARID

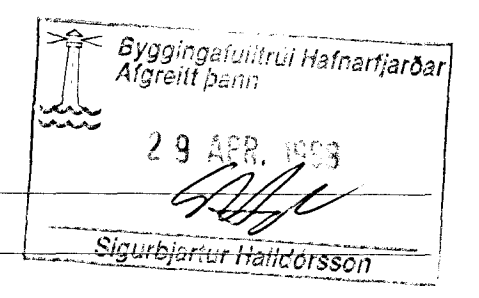

**TÆKNIÞJÓNUSTA SIGURDAR ÞORLEIFSSONAR ehf**  
STRANDGÖTU 11 220 HAFNARFIRÐI  
Sími 555-4255 FAX 565-2875  
E-mail taeknihjonusta@islandia.is

