


ÚTLIT SUÐUR MKV. 1:100.

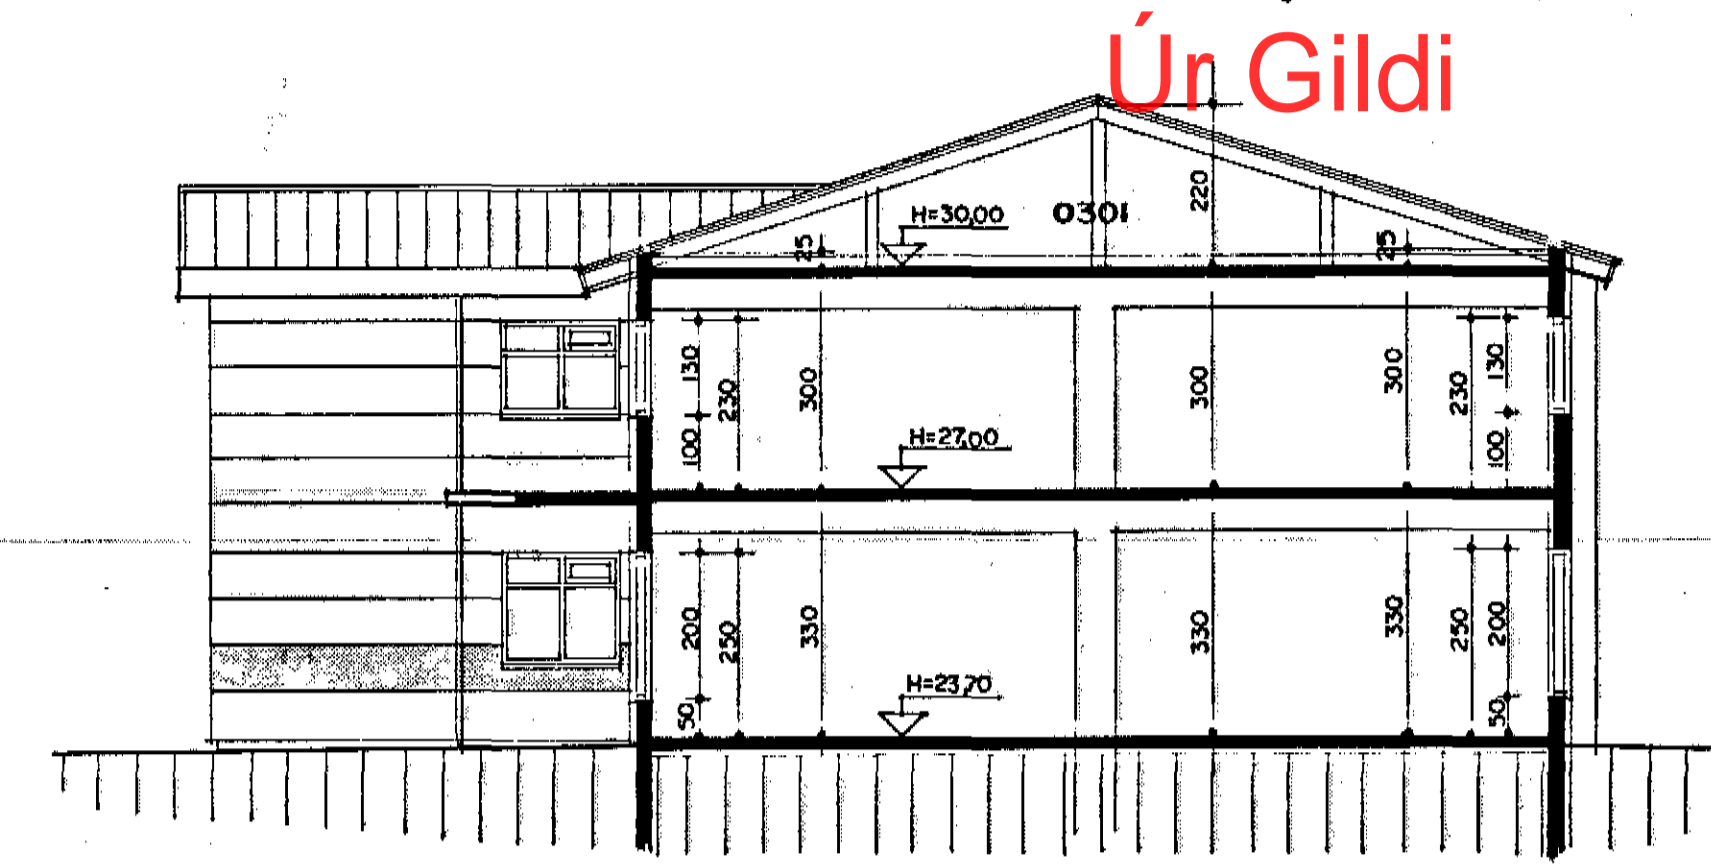


SNID A-A MKV. 1:100.


Ún Gildi




ÚTLIT AUSTUR MKV. 1:100.

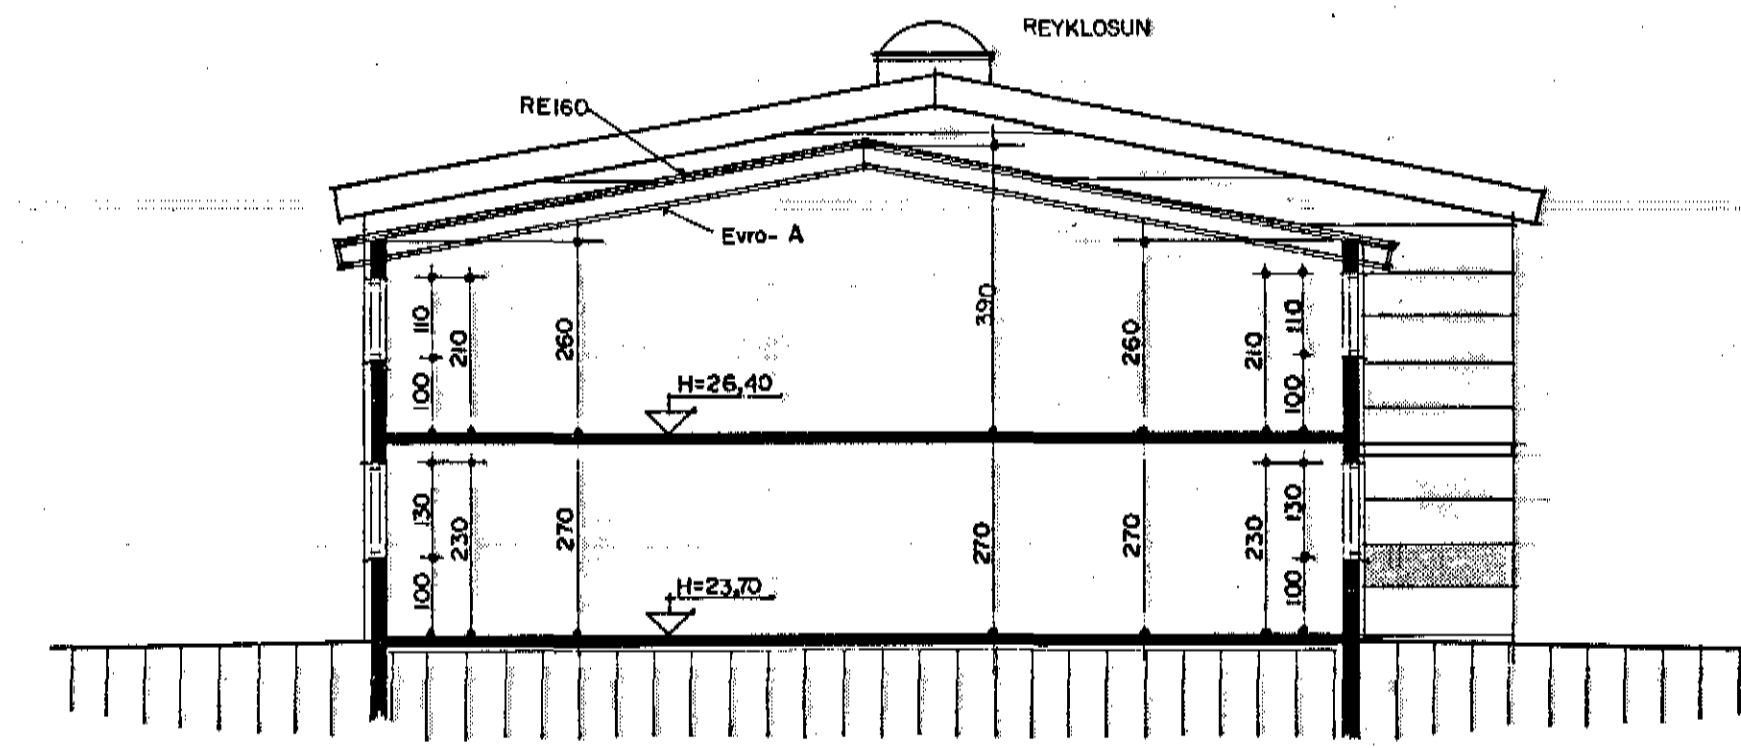

SNID B-B MKV. 1:100.

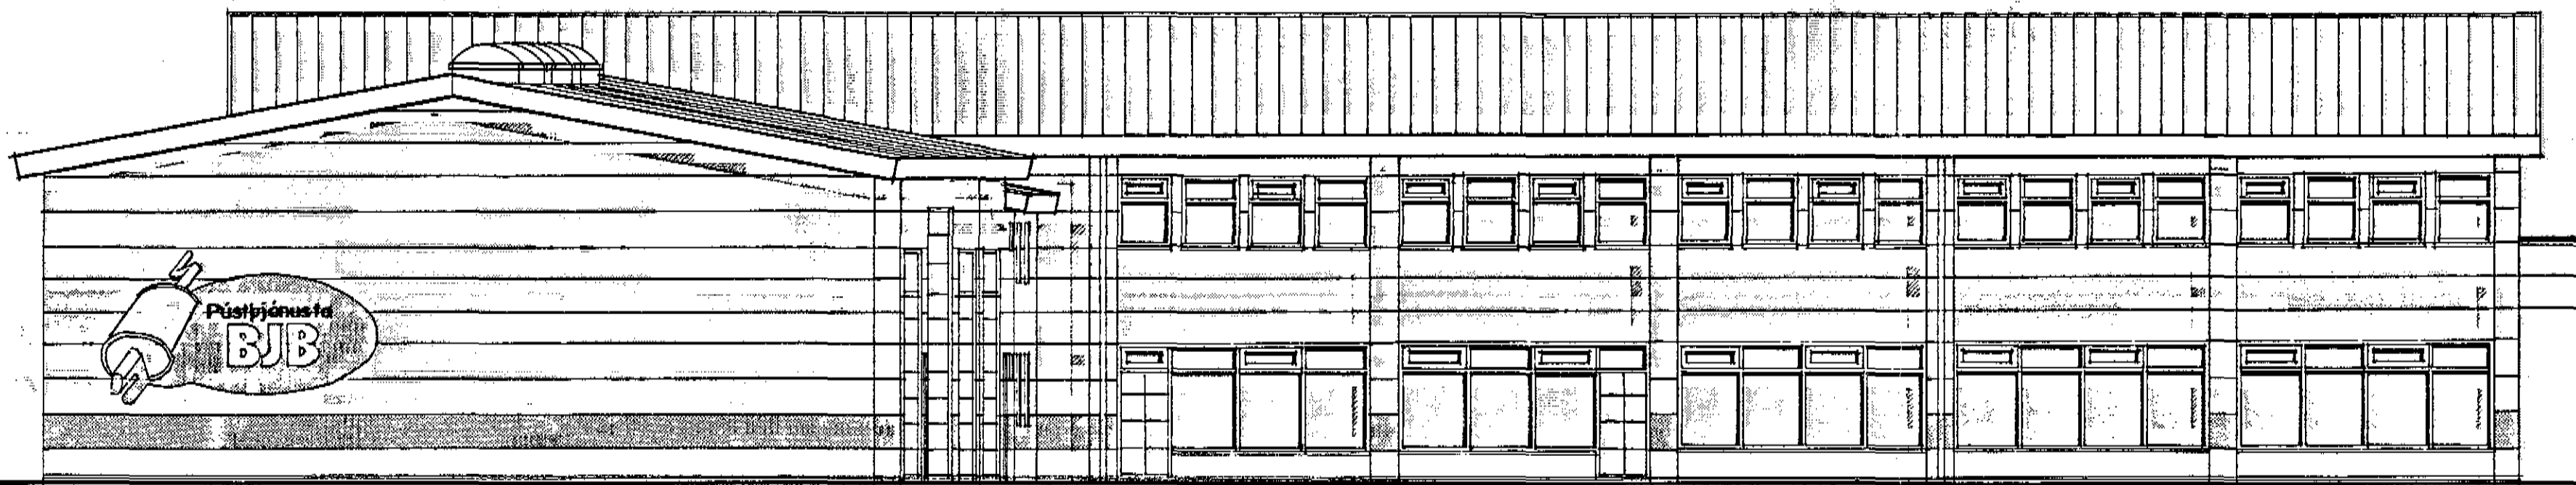


ÚTLIT NORÐUR MKV. 1:100.

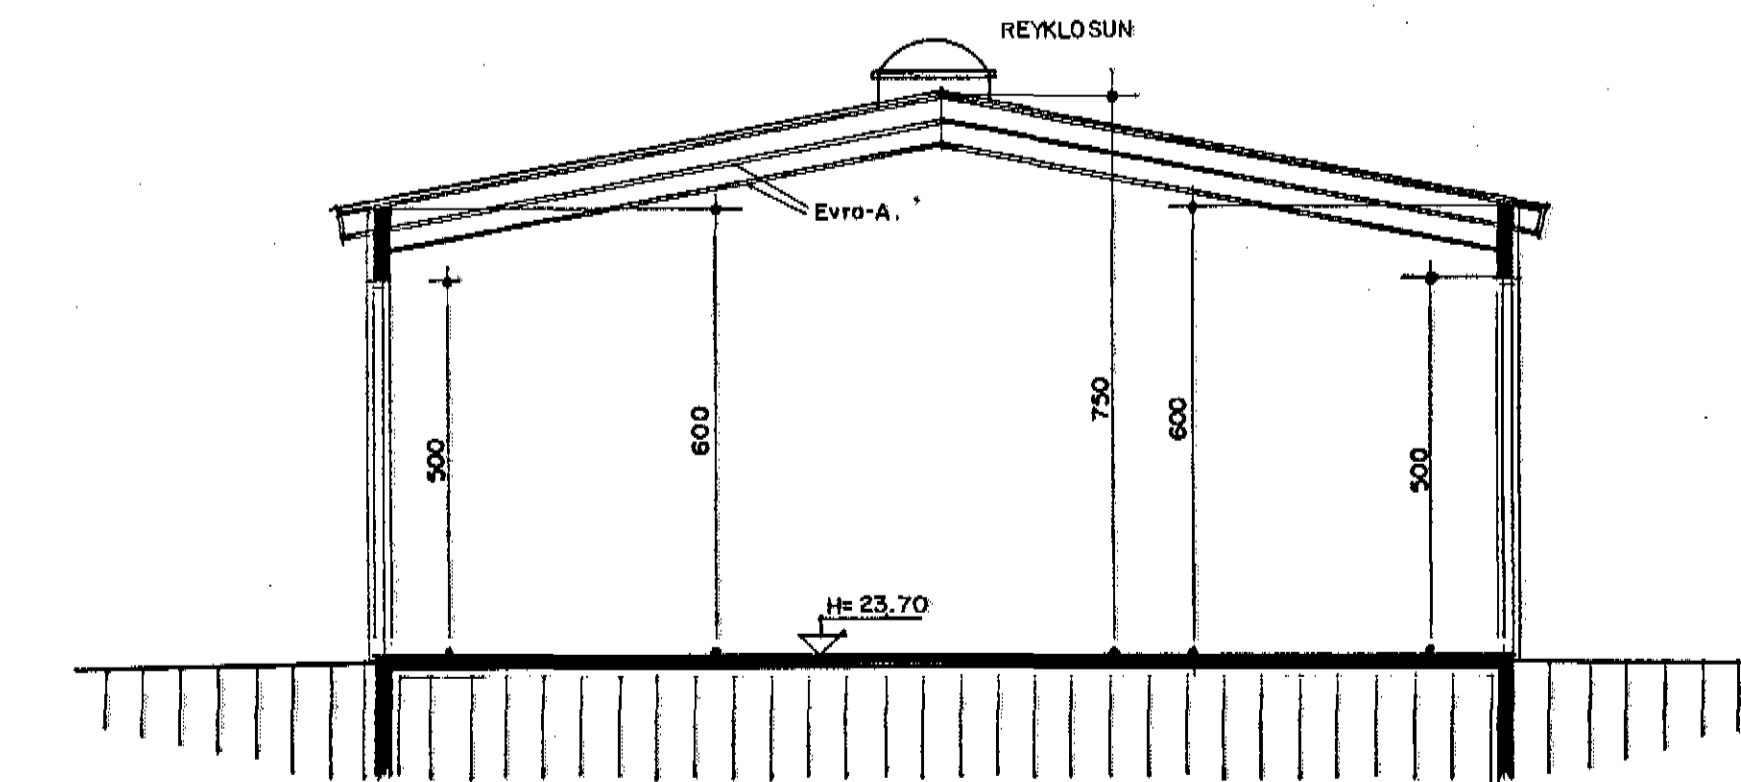

SNID C-C MKV. 1:100.

MHL OG KÓTA BREYTT Í DES. 1998.

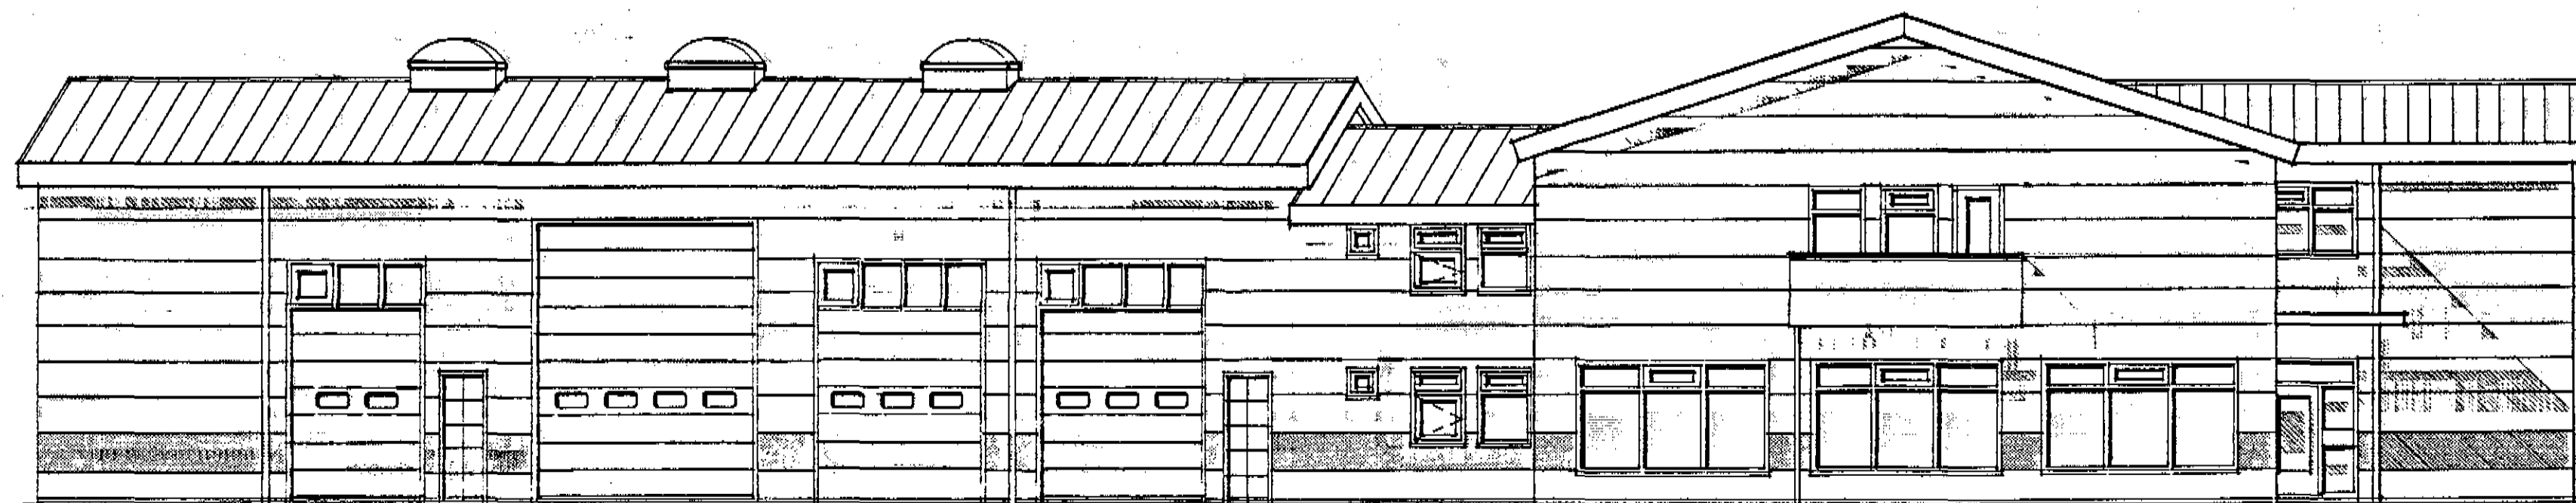

ÚTLIT VESTUR MKV. 1:100.