
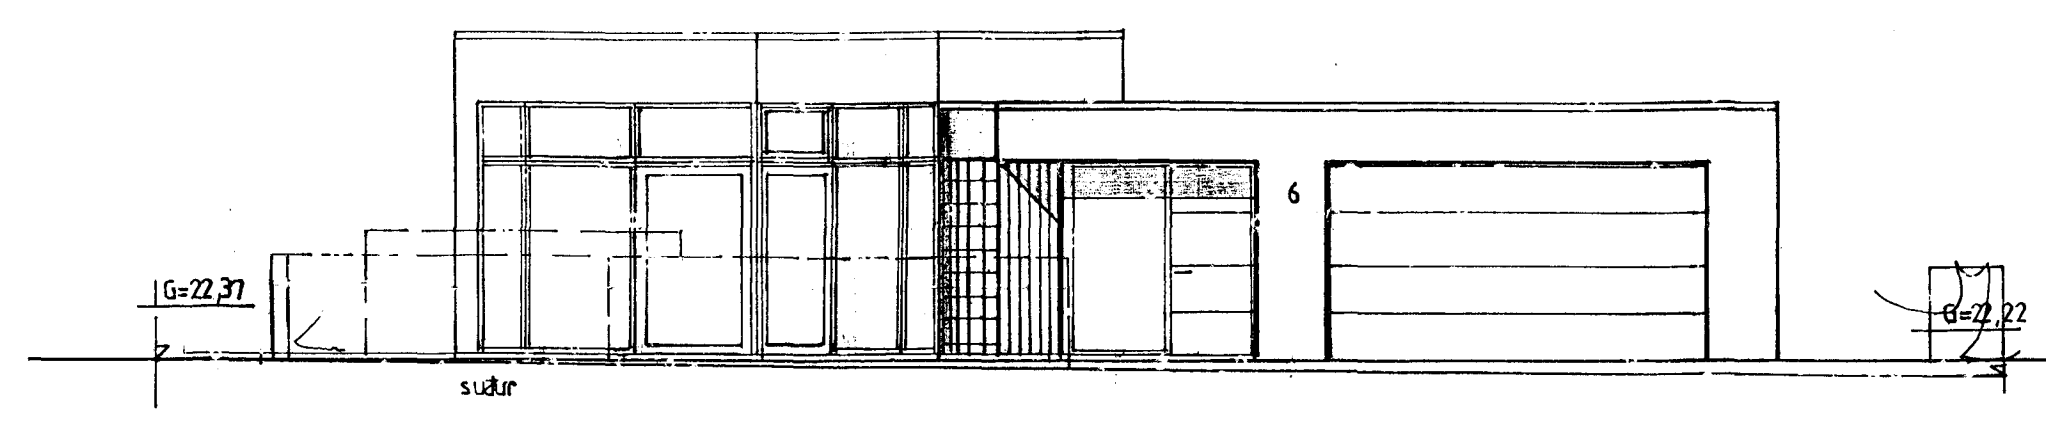
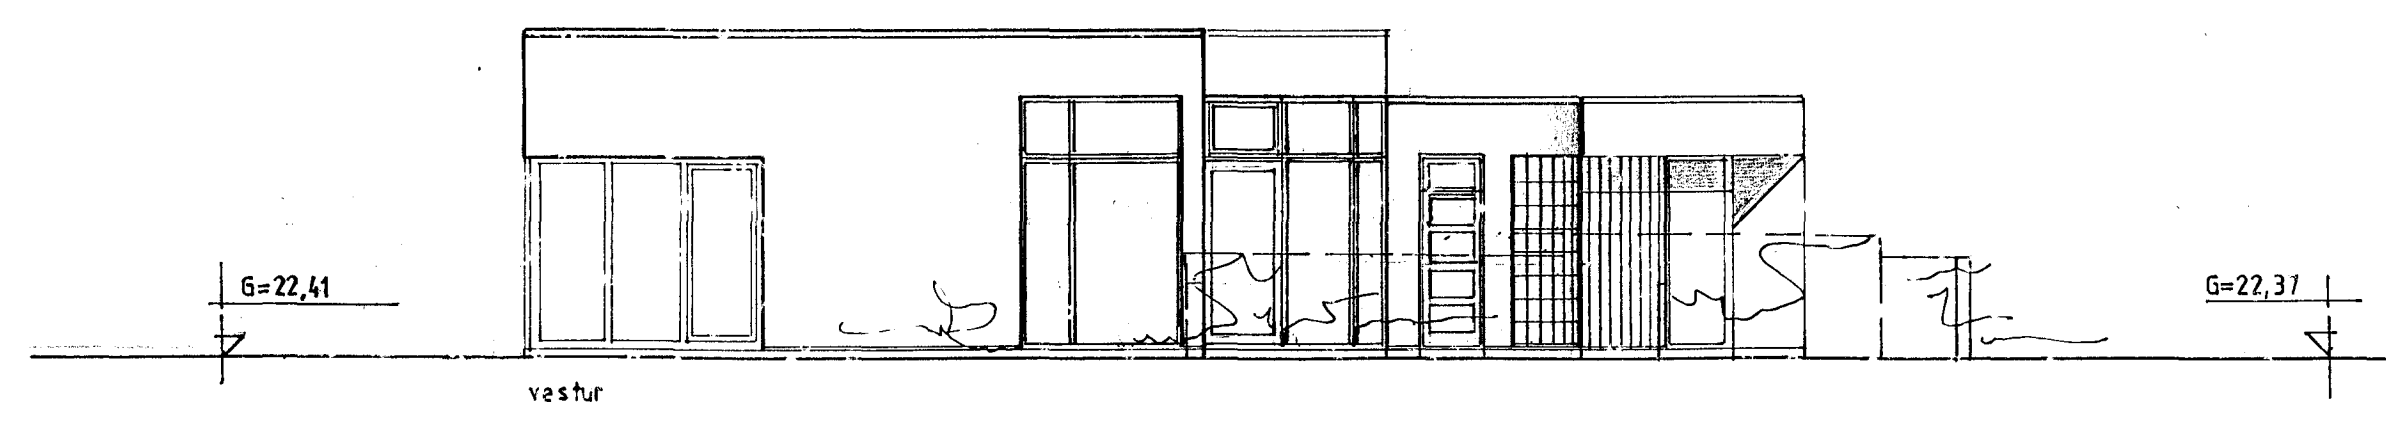
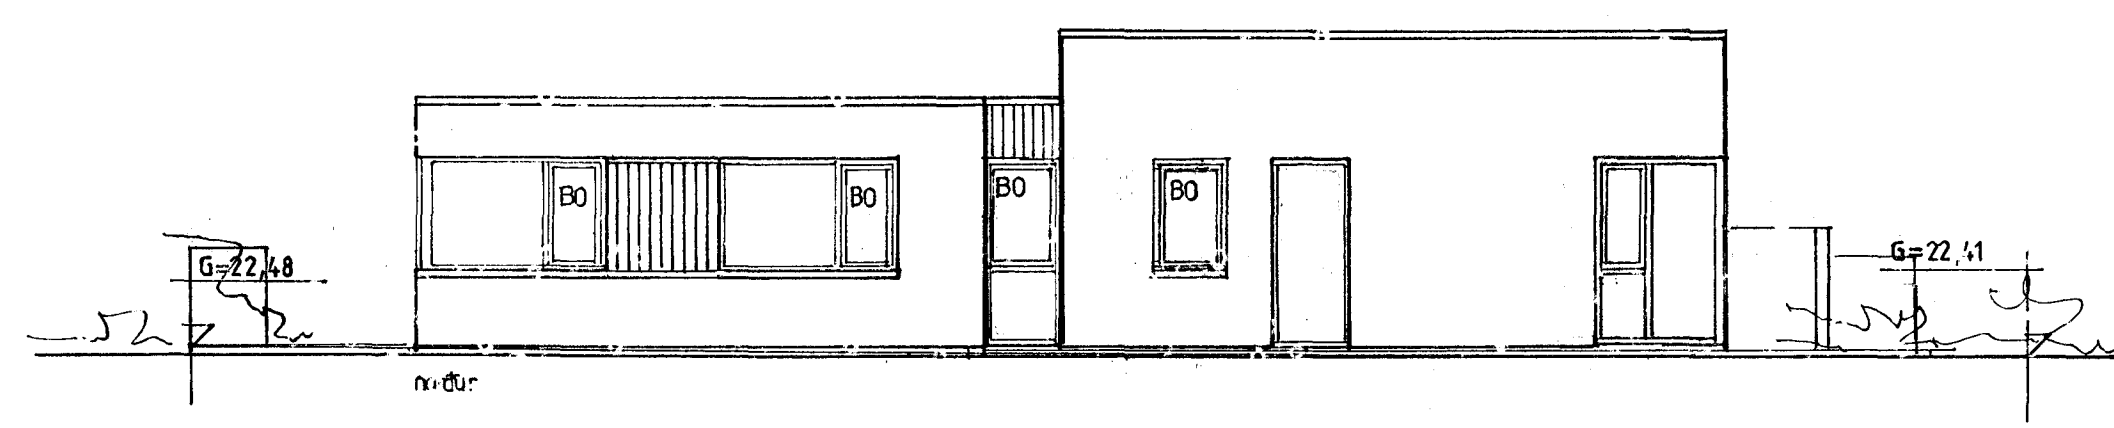


Samþykkt þann
26 APR. 2006
Jon Sig

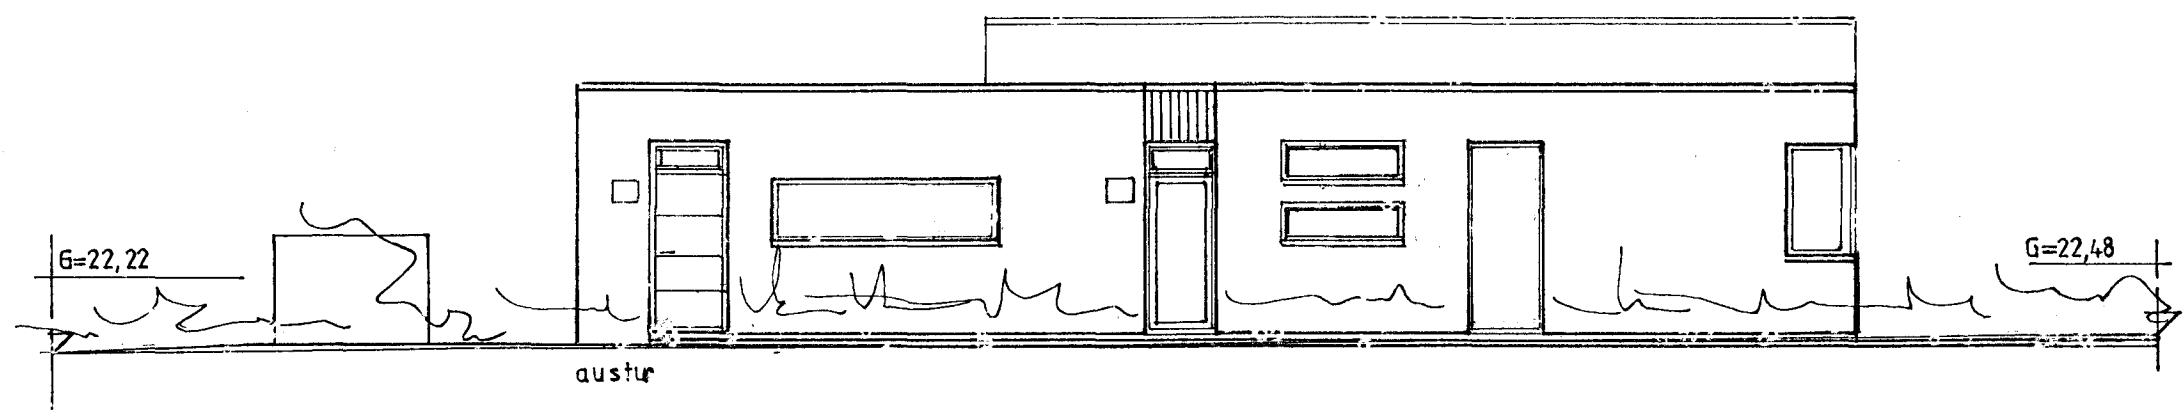

**FLÉTTUVELLIR 6,
HAFNARFIRÐI**

ÚTLIT MKV. 1:100
2005-11-14 BR. 2006-04-04 GLUGGAR J.P. SS.
Jóhannes Pétursson 010448-3959 S - 567-5107
Sigurður Sigurðsson 021146-2349 S - 566-6613
johp@isholf.is

Jon Sig

ABS teiknistofa 566-6613, 567-5107 Nr. 2