


Kötti Kjallara golfi  
settur = 1.

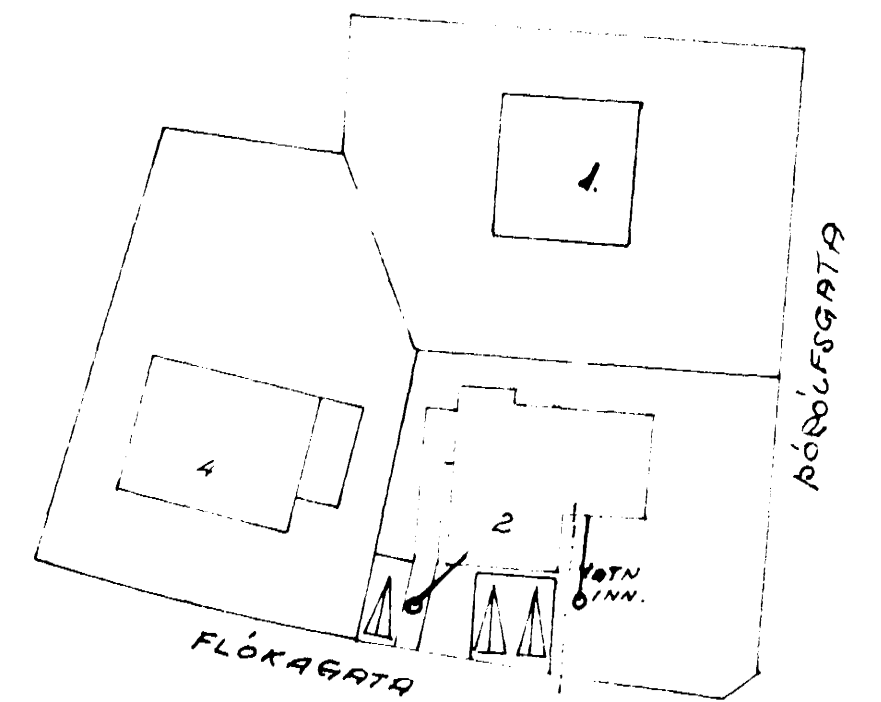

SKOLF & VATNSLÖGN FLÓKAGATA 2 HAFNARF.	Kvarðu	DRGS.	24-4.68
		TEIKN.	Kalk.
KOLBEINN JÓNSSON TEKNIFR. HTFÍ	TEIKN. NÚM.		6508
	BL. NR.		1