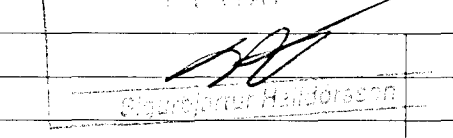
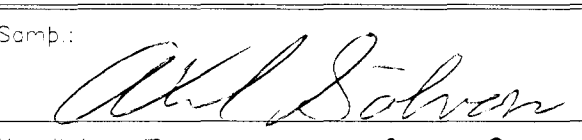


6. Breyting á loftþræsting, vélmáttarstærð Ágripstölur	
	
Nr. Lýsing á breytingu _____ Dags. _____	

SÍF HF. - FORNBÚÐUM 5, HAFNARFIRÐI	
LOFTTRÆSTING TÁKNRÆN KERFISMYND KERFI 3 OG 4	
Kvæði: ENGINN	Tekning nr. _____
Mætti: AHS	Dags: 4.5.2000
Tekniá: AHS	L. 11
Væð nr: 236	Skjal nr: Kerfism.dwg

LAGNATÆKNI	
HÖNNUNAR- OG RÁÐGJAFARSTOFA	
HAMRABORG 12, 200 KÖPAVOGUR	
Sími: 564 5252 Fax: 564 5251	
Netfang: hblagnatak.is	
Samp: 	
Kennitala: 300471-2689	