


SÍF Þingdórstöð
Fornuðóir 5
Gólfkæti : 4.00

20/5 1998.
Tólk. 1. af 10
E.H.
breytt 1/5 1998

200 mm ST. 20 pr.mill
Laginn af lögð að
þrjúgarkí við Hofmannakla

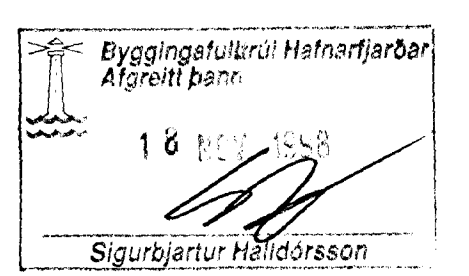

VIÐSKRÁ

N	V	NR.
23516.099	8019.027	9
23721.354	8010.227	10
23724.724	9007.737	13
23530.337	9022.174	24
23530.110	9020.652	25

C	Heilbrigði vð sápt. af	JRS	17.11.98
B	Ýmsar breytingar	JRS	10.11.98

St	Fornuðóir 5 - Heilbrigði	SKV	16.10.98
Stjórnun	1997	SKV	16.10.98
Rekstrar	1997	SKV	16.10.98
