


REYNDARTEIKNING

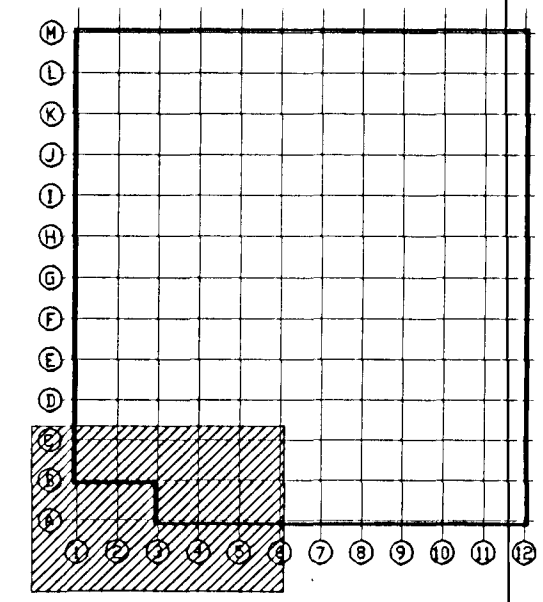

T11 TEIKNISTOFAN SMÍÐJUVEGI 11, 200 KÖP. S.564 4680 FAX: 564 4681

Verkhelti:	SÍF BIRGDARST. FORNUBÚÐIR 5 HF	Msk: 1:50	Homnab: HS/ÖS/AGE
Verkhilti:	RAFLAGNIR 1-HÆÐAR	Dag: 26.08.97	Teknab: HS
Unirskrift:	<i>Stefn Sig</i>	Þrext: 23.11.98	Vrkunab: ÖS/AGE
		Fjöldi blaða	Blað nr.
		45	41101

ARKITEKTAHÖNNUN: Stefán Halsson BFI, Kristinn Ragnarsson FAI, Agóstr Þórðarson BFI
VERKFRÆÐITEIKNINGAR: Bjarni Arnason TFI, Ragnar Gunnarsson TFI
RAFLAGNAHÖNNUN: Hannes Snabjörn Sigurjónsson TFI, Arni Guðni Einarsson TFI, Ófeigur Sigurðsson TFI