


C:\1-ACAD-Teikninga\1-VERKFRÆÐI\06-07\NS\1\06\UNNAR\Teikningur\Hrafslag.dwg Tue Nov 24 17:06:19 1998 Reyndarteikning

REYNDARTEIKNING

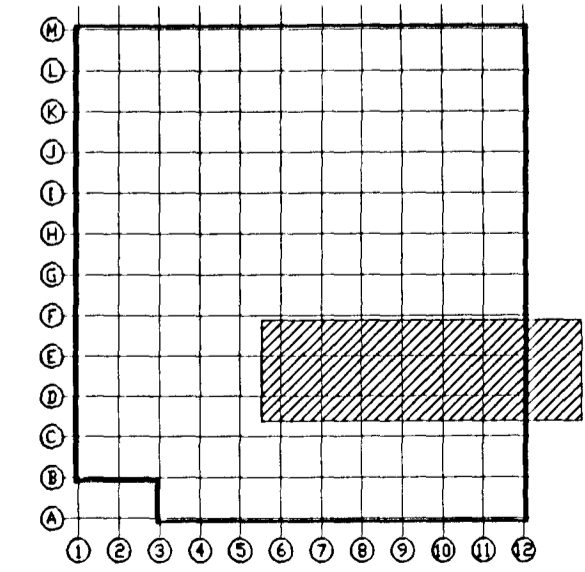

**T11** TEIKNISTOFAN SÍÐUVEGI 11, 200 KÖP. S.564 4680 FAX: 564 4681

VERKFRÆÐI SÍF BIRGDARST. FORN RAFLAGNIR 1-HÆÐAR	VERKFRÆÐI Björn Arnason TFI Ragnar Gunnarsson TFI	RAFLAGNAHÖNNUN Hannes Snabjörn Sigurjónsson TFI Arni Guðni Einarsson TFI Óteigur Sigurðsson TFI
Msk. 1:50 Daga: 26.08.97 Breytt: 23.11.98 Únskrift: Hamner Sig	Hannað: HS/OS/AGE Teknið: HS Vefandi: OS/AGE	Blað nr.: 41106