



Byggingafræði Hafnarbætur
Móti-Ó þinn
28 SEP 2012
Sj
Sigurður Steinar Jónsson

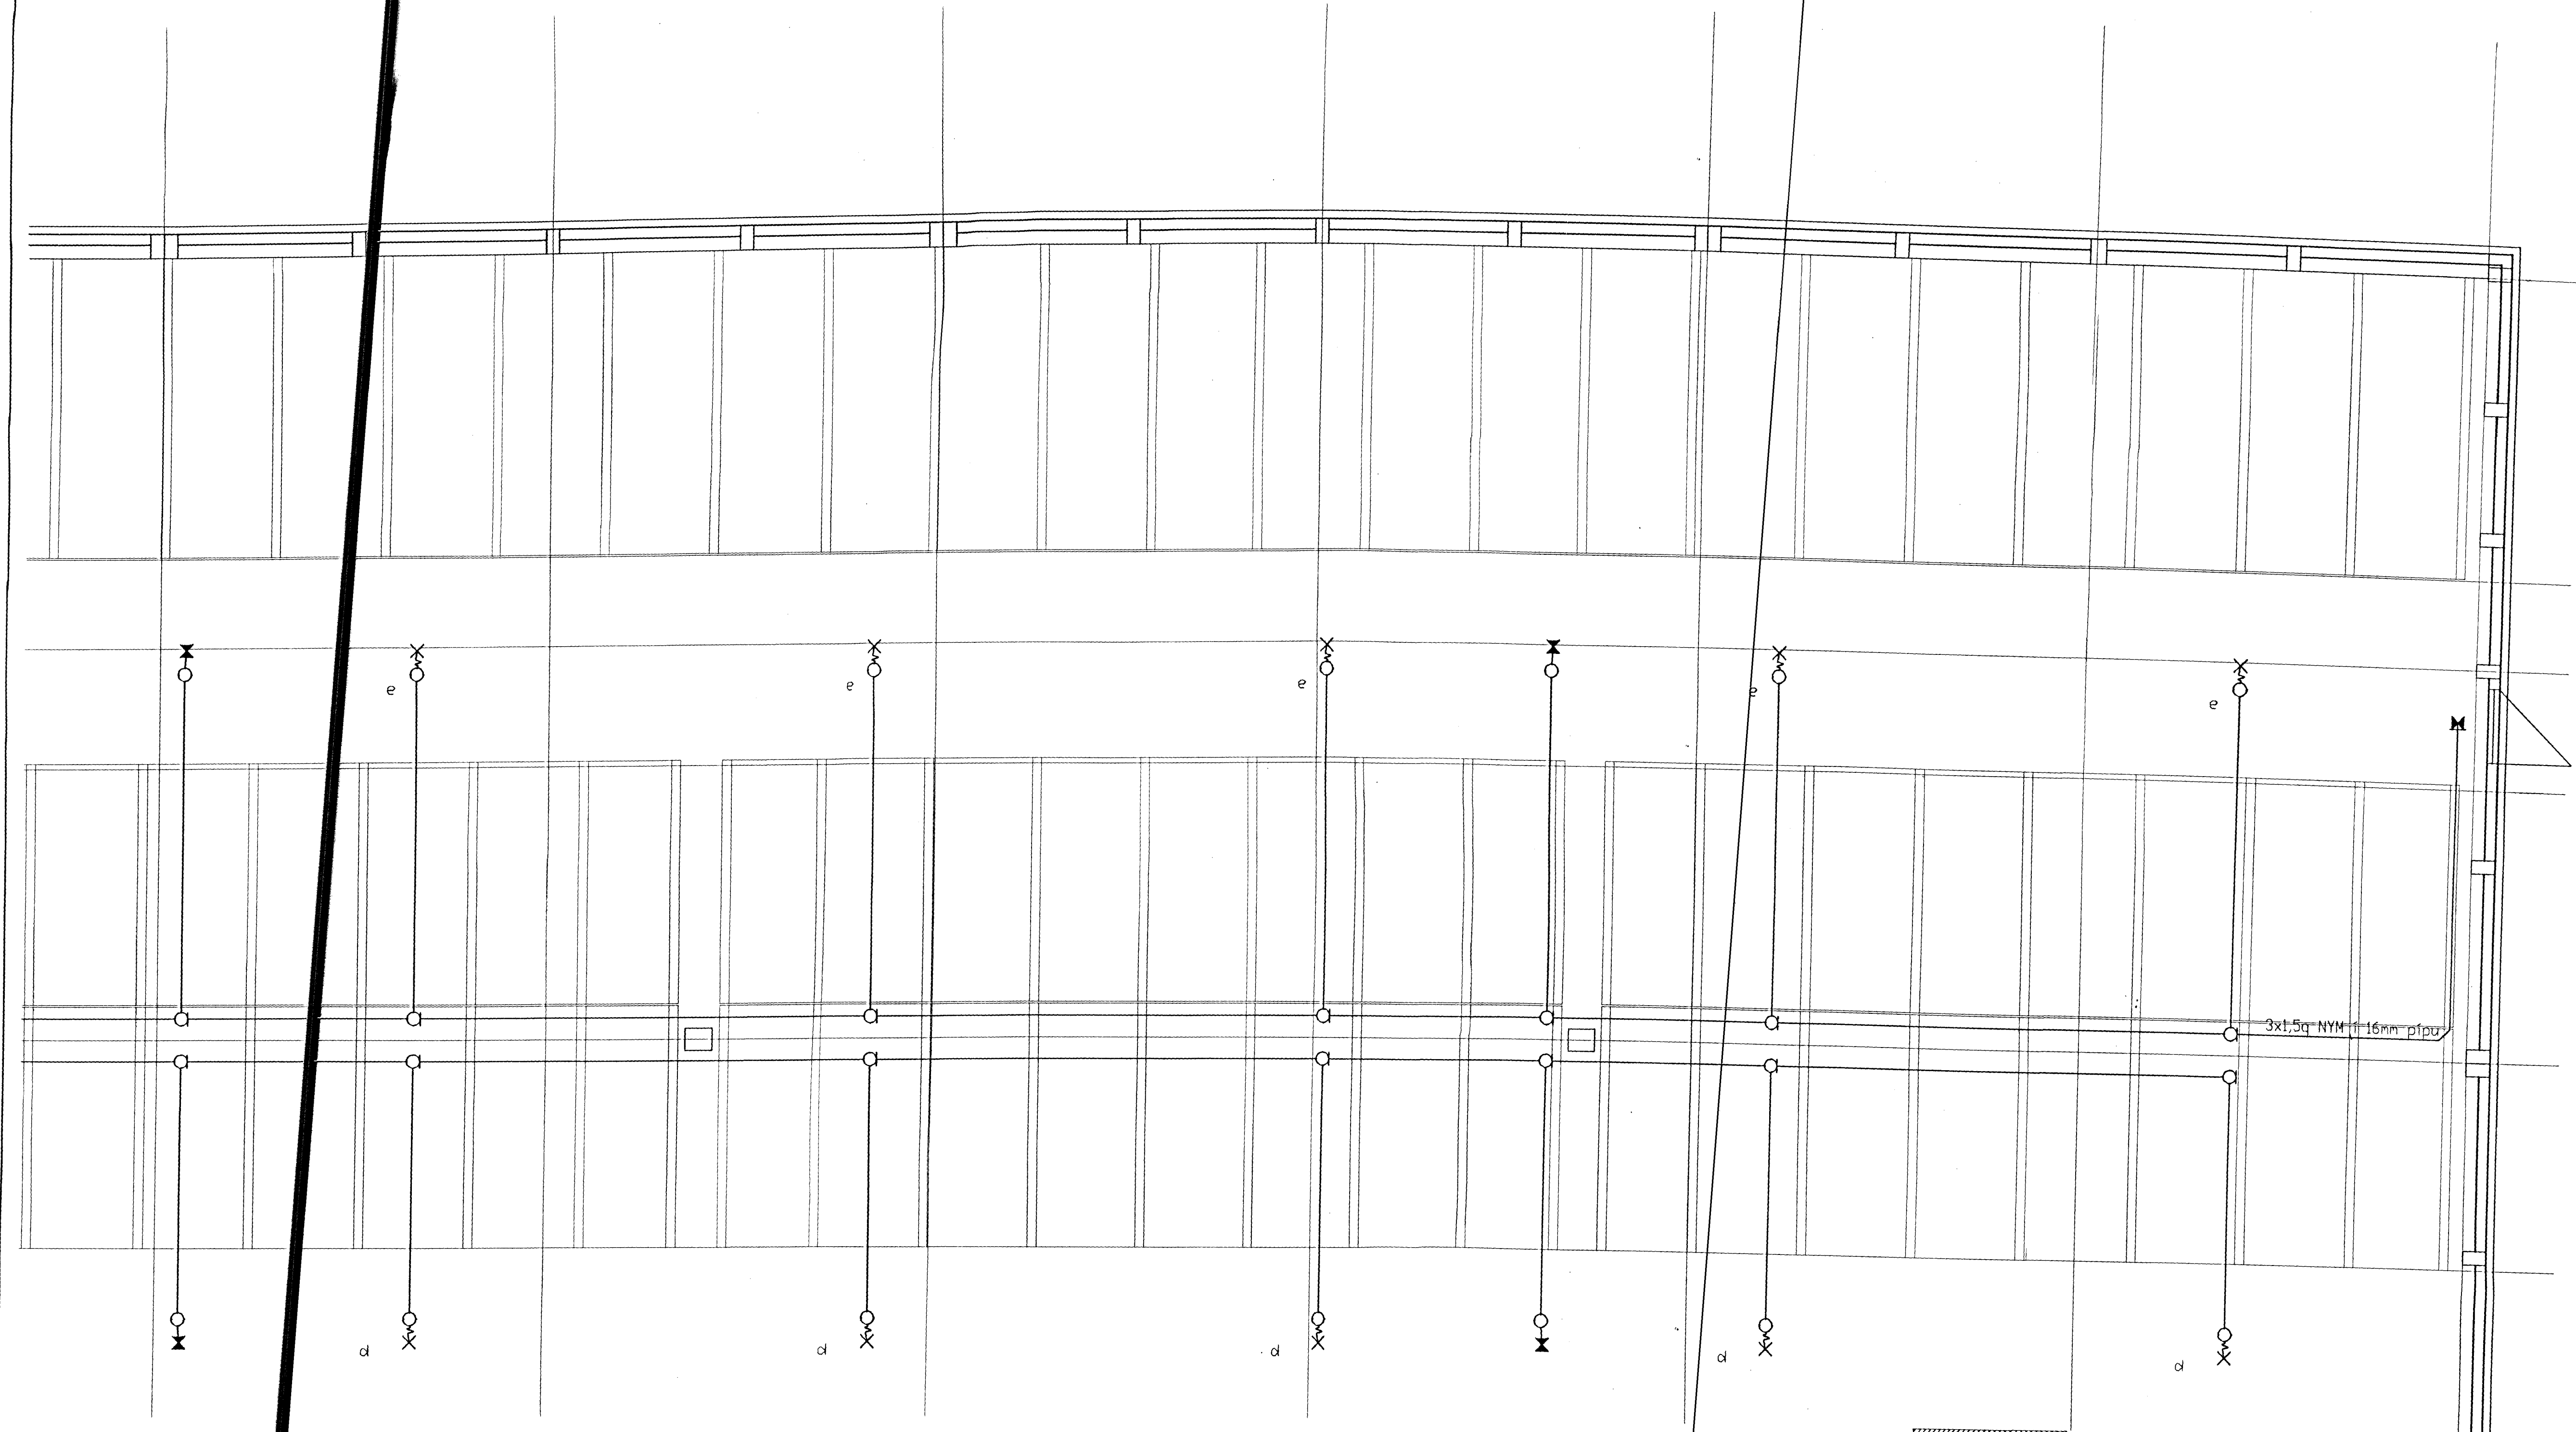

3x1.5q NYM 16mm p/ps

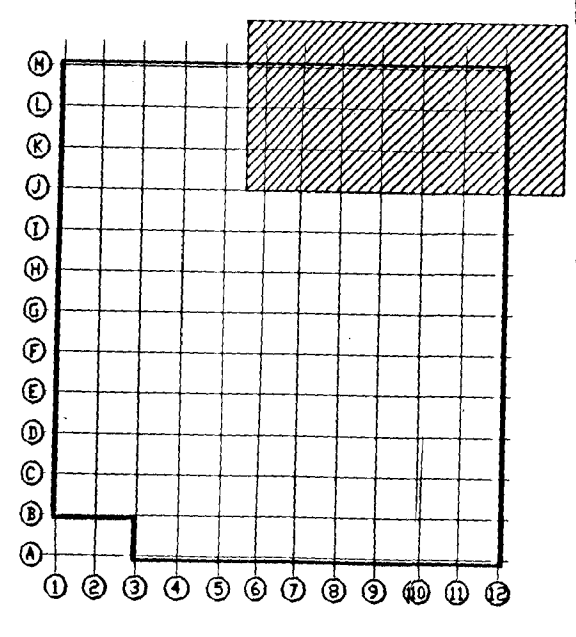

REYNDARTEIKNING

T11 TEIKNISTOFAN SMÞÁJVEGI 11, 200 KÓP. S.564 4680 FAX: 564 4601

ARKITEKTARÁÐGJAFUR Stefán Halldórsson BFI	VERKFRÉDITEIKNINGAR Bjarni Árnason TFI	RAFLAGNAÐÁÐGJAFUR Hannes Snabáttur Sigurðsson TFI
Kristlín Ragnarsdóttir FAF	Ragnar Gunnarsson TFI	Arni Guðni Einarsson TFI
Agnýs Þórkásson BFI		Ófeigur Sigurðsson TFI

Verkhelti: SÍF BIRGDARST. FORNUBÜÐIR 5 HF

Verkhelti: RAFLAGNIR 1-HÆÐAR

Unirskrift: *Hannes Snabáttur*

Mev. 1:50	Hannak. HS/OS/AGE
Dagur 28.09.12	Teknaok. HS
Þeyti 23.11.98	Teknaok. OS/AGE
Fjöldi blaða 45	Blað nr. 41108

C:\D-teknir\regal1-VERKEN\136-97A\S1\GRUNNARVAFI.LAGNIR\11-raf1.dwg Tue Nov 24 17:07:04 1998 Reyndarteikning