
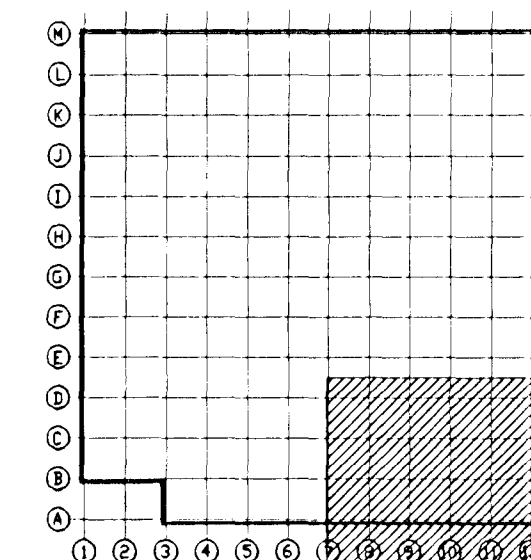


Byggingaframtíð Hafnarfjarðar
Mótekið þann
28 SEP 2012
Sigurður Steinar Jónsson

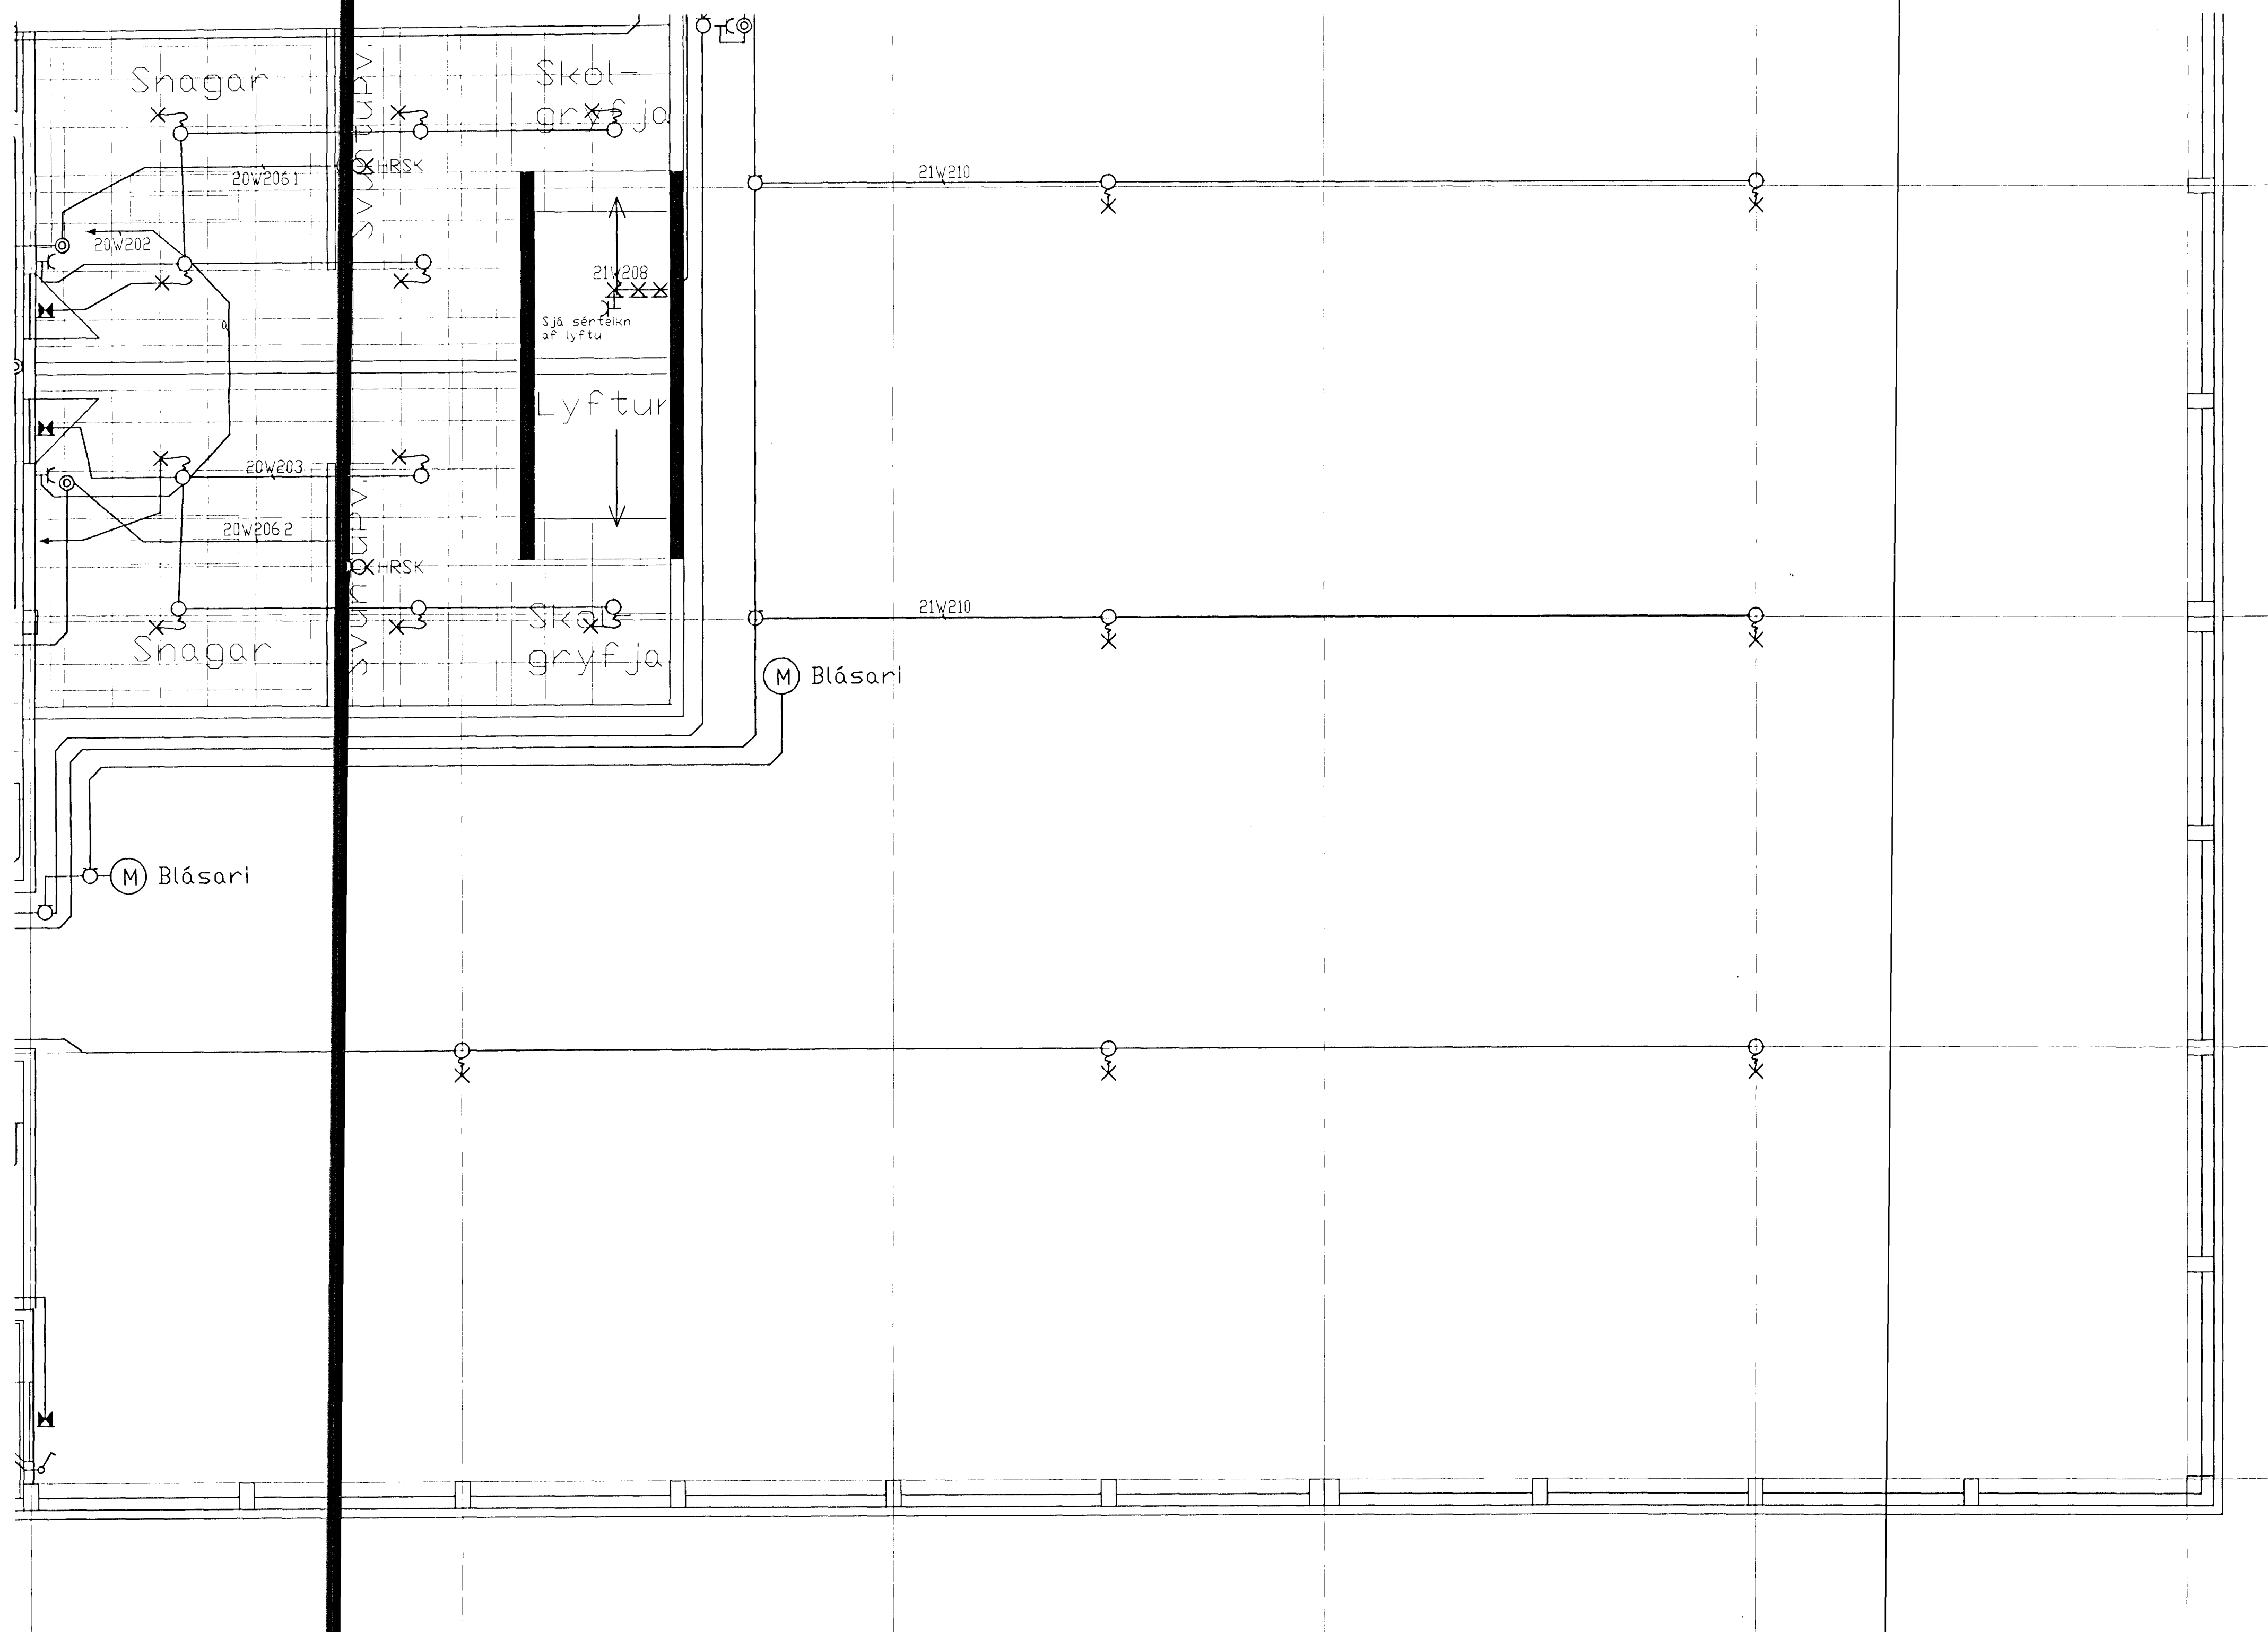

7 8 9 10 11 12

REYNDARTEIKNING

T11 TEIKNISTOFAN SMÍÐJUVEGI 11, 200 KÖP. S.564 4680 FAX: 564 4681

ARKITEKTARÖNNUN Stefán Halsson BFI Kristinn Ragnarsson FAL Agúst Þórðarson BFI	VERKFRÉDITEKNINGAR Bjarni Árnason TFI Ragnar Gunnarsson TFI	RAFLAGNAÖNNUN Hannes Snabjörn Sigurjónsson TFI Árni Guðni Einarsson TFI Ófeigur Sigurðsson TFI
Verkhætti: BIRGDARSTÖÐ FORNUBÚÐIR 5	Mæsk: 1:50	Hannað: HS/AGE/OS
Verkhliuti: RAFLAGNIR 2-HÆÐ	Dagur: 28.08.12	Teknað: HS
Unirskrift: <i>Hannes Sig</i>	Blætt: 23.11.98	Verfarar: OS/AGE
	Fjöldi blæða: 45	Blæð nr: 41204

C:\1-ACAD-Teikningar\1-VERKENINGAR\96-97\51\GJUNNA\Varflagnir\20-Varflagnir.dwg Mer Nov 25 15:04:50 1998 HEYNDARTEIKNING