
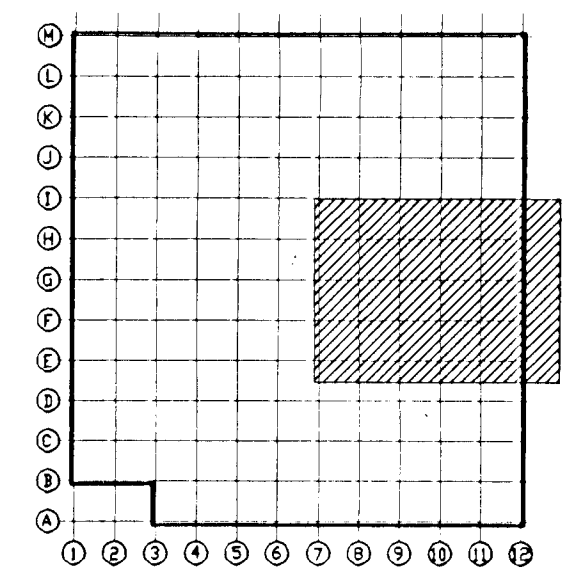


Byggingafulltrúi Hafnarjarðar  
Móttækis þann  
28 SEP 2012  
Sigurður Steinar Jónsson

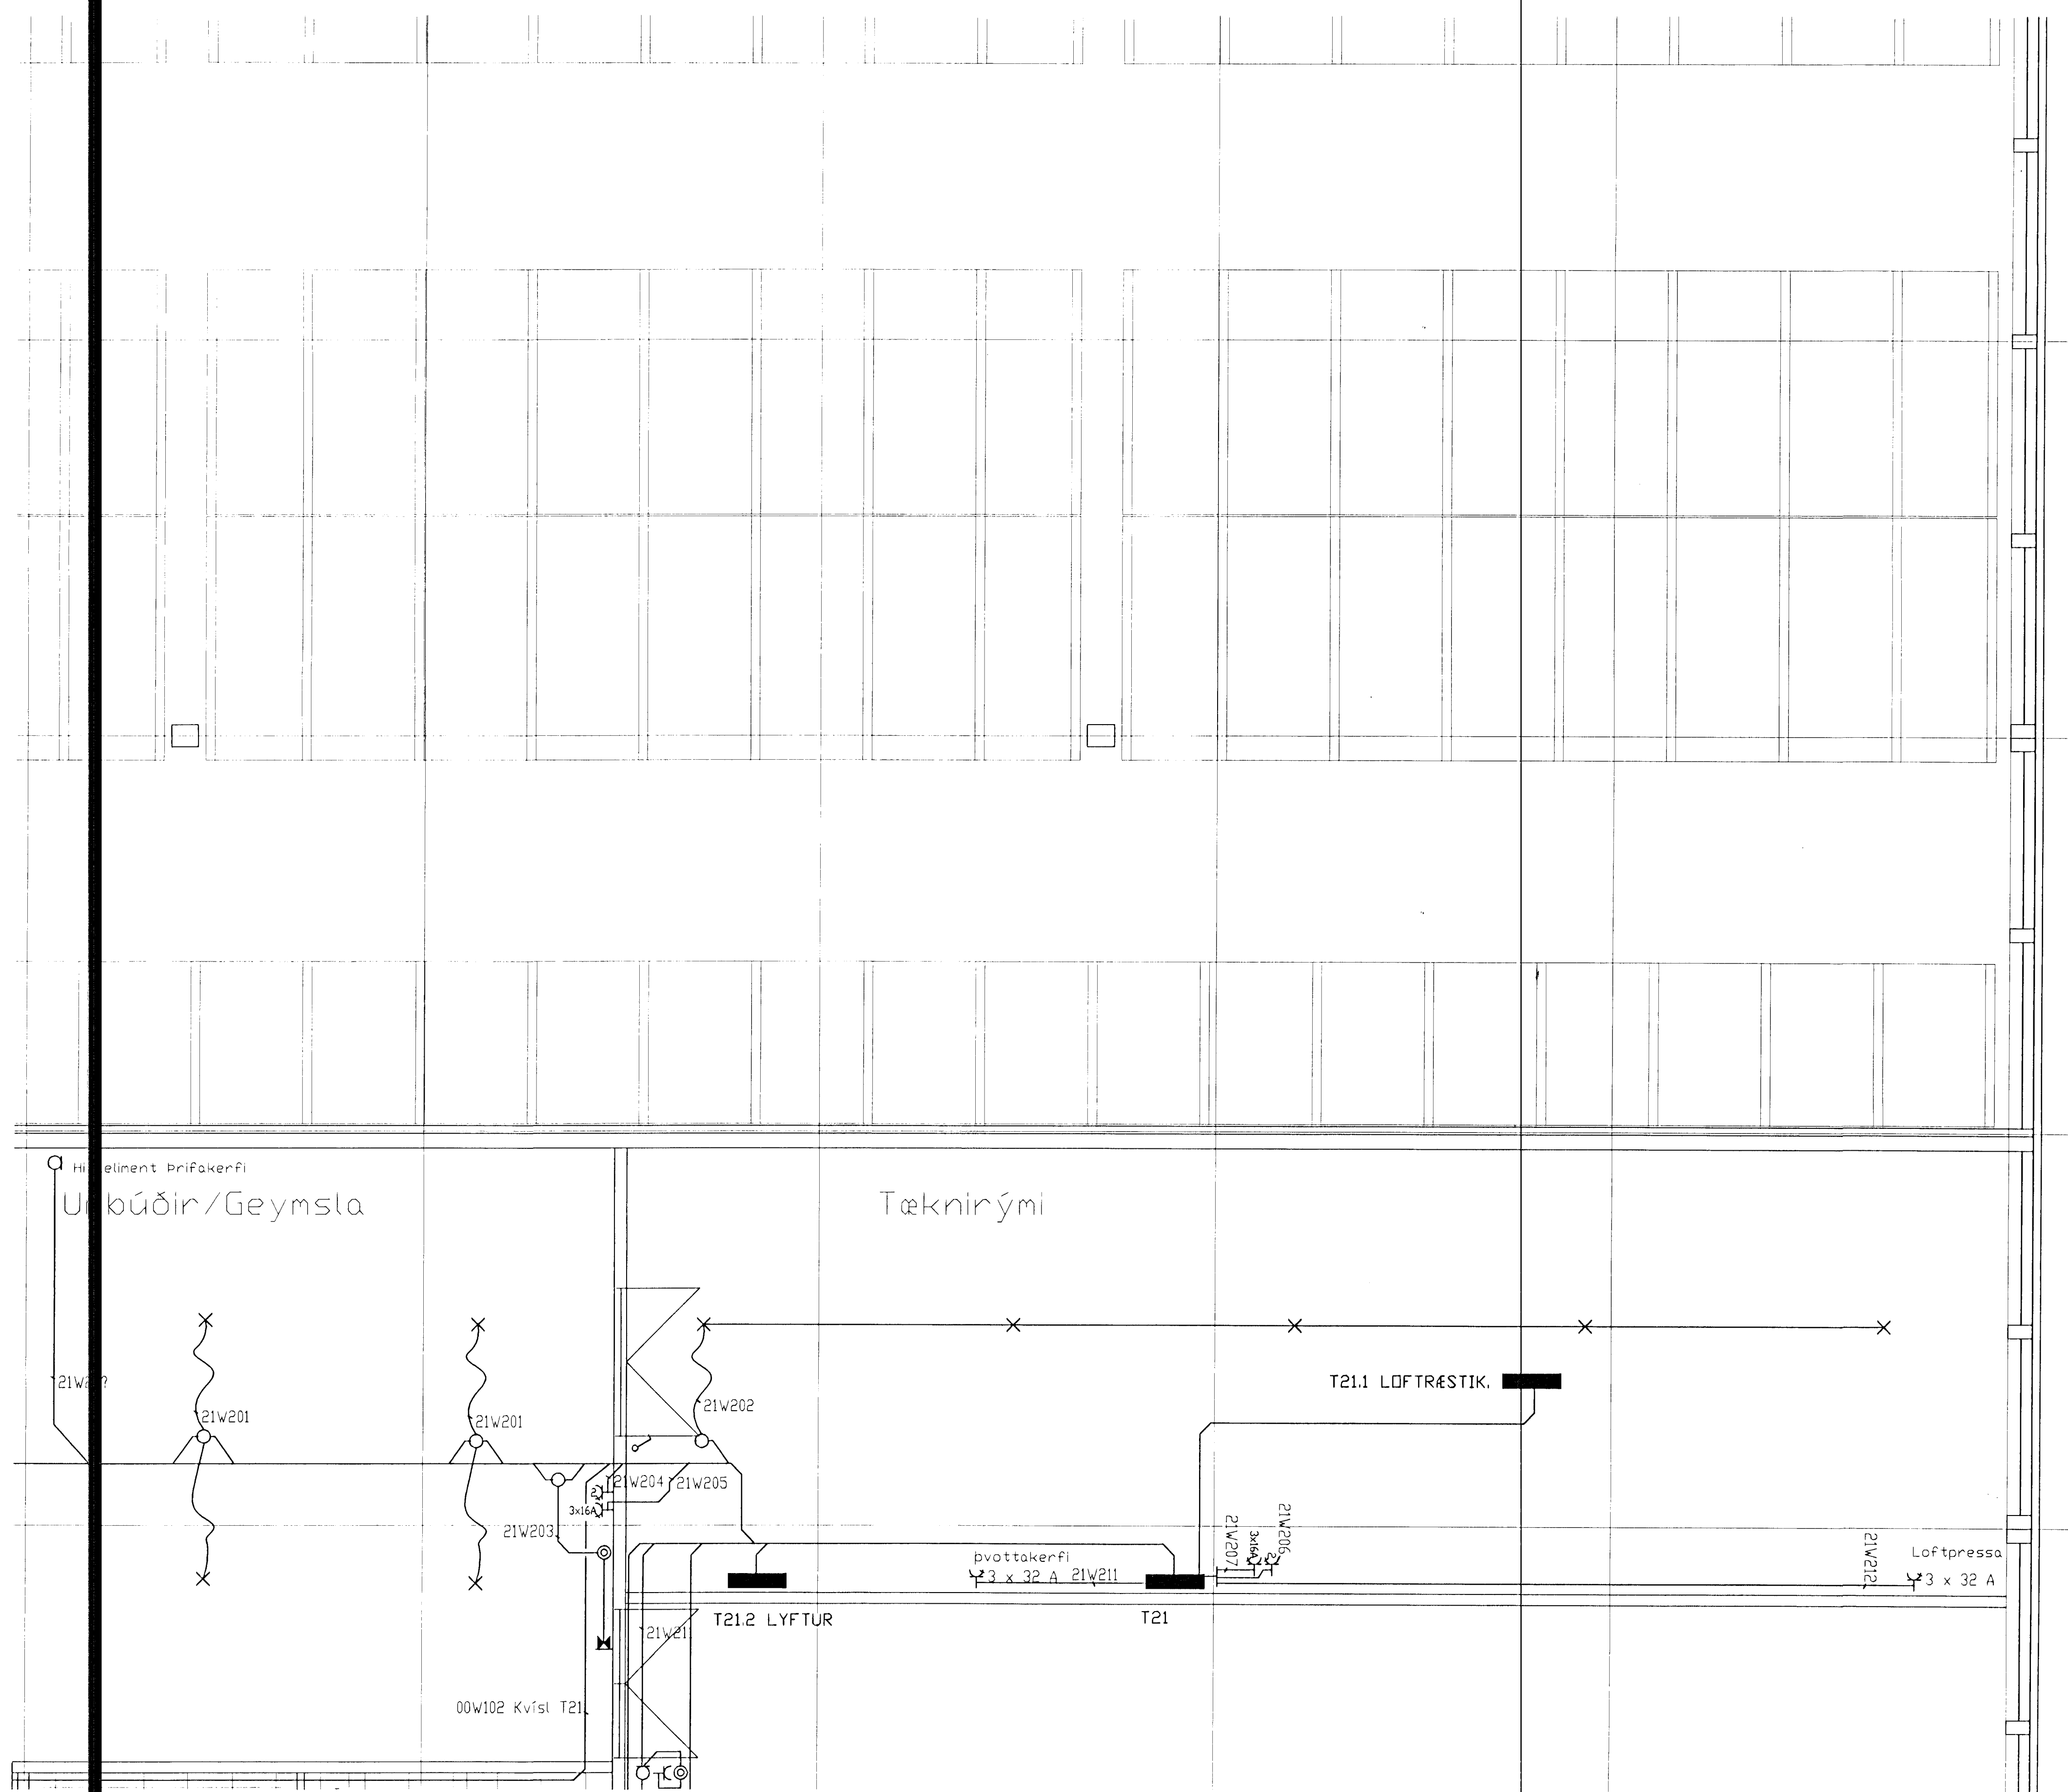

REYNDARTEIKNING

**T11** TEIKNISTOFAN SMÍÐJUVEGI 11, 200 KÓP. S.564 4680 FAX: 564 4681

ARKITEKTAHÖNNUN Stefán Halsson BFI Kristinn Ragnarsson FAL Ágúst Þórðarson BFI	VERKFRÉDITEIKNINGAR Bjarni Árnason TFI Ragnar Gunnarsson TFI	RAFLAGNAHÖNNUN Hannes Snabjörn Sigurjónsson TFI Árni Guðni Einarsson TFI Ófeigur Sigurðsson TFI
Verkefni: BIRGDARSTÖÐ FORNUBÚÐIR 5	Skala: 1:50	Maðað: HS/AGE/OS
Verkið: RAFLAGNIR 2-HÆÐ	Dag: 28.08.97	Teknað: HS
Unnskilt: Hannes Sig	Þeytt: 23.11.98	Yfirfarið: OS/AGE
	Fjöldi blaða: 45	Blað nr.: 41205