



Byggingafullnúi Hafnarjarðar
Móttekið þann
28 SEP 2012
Sigurður Steinar Jónsson

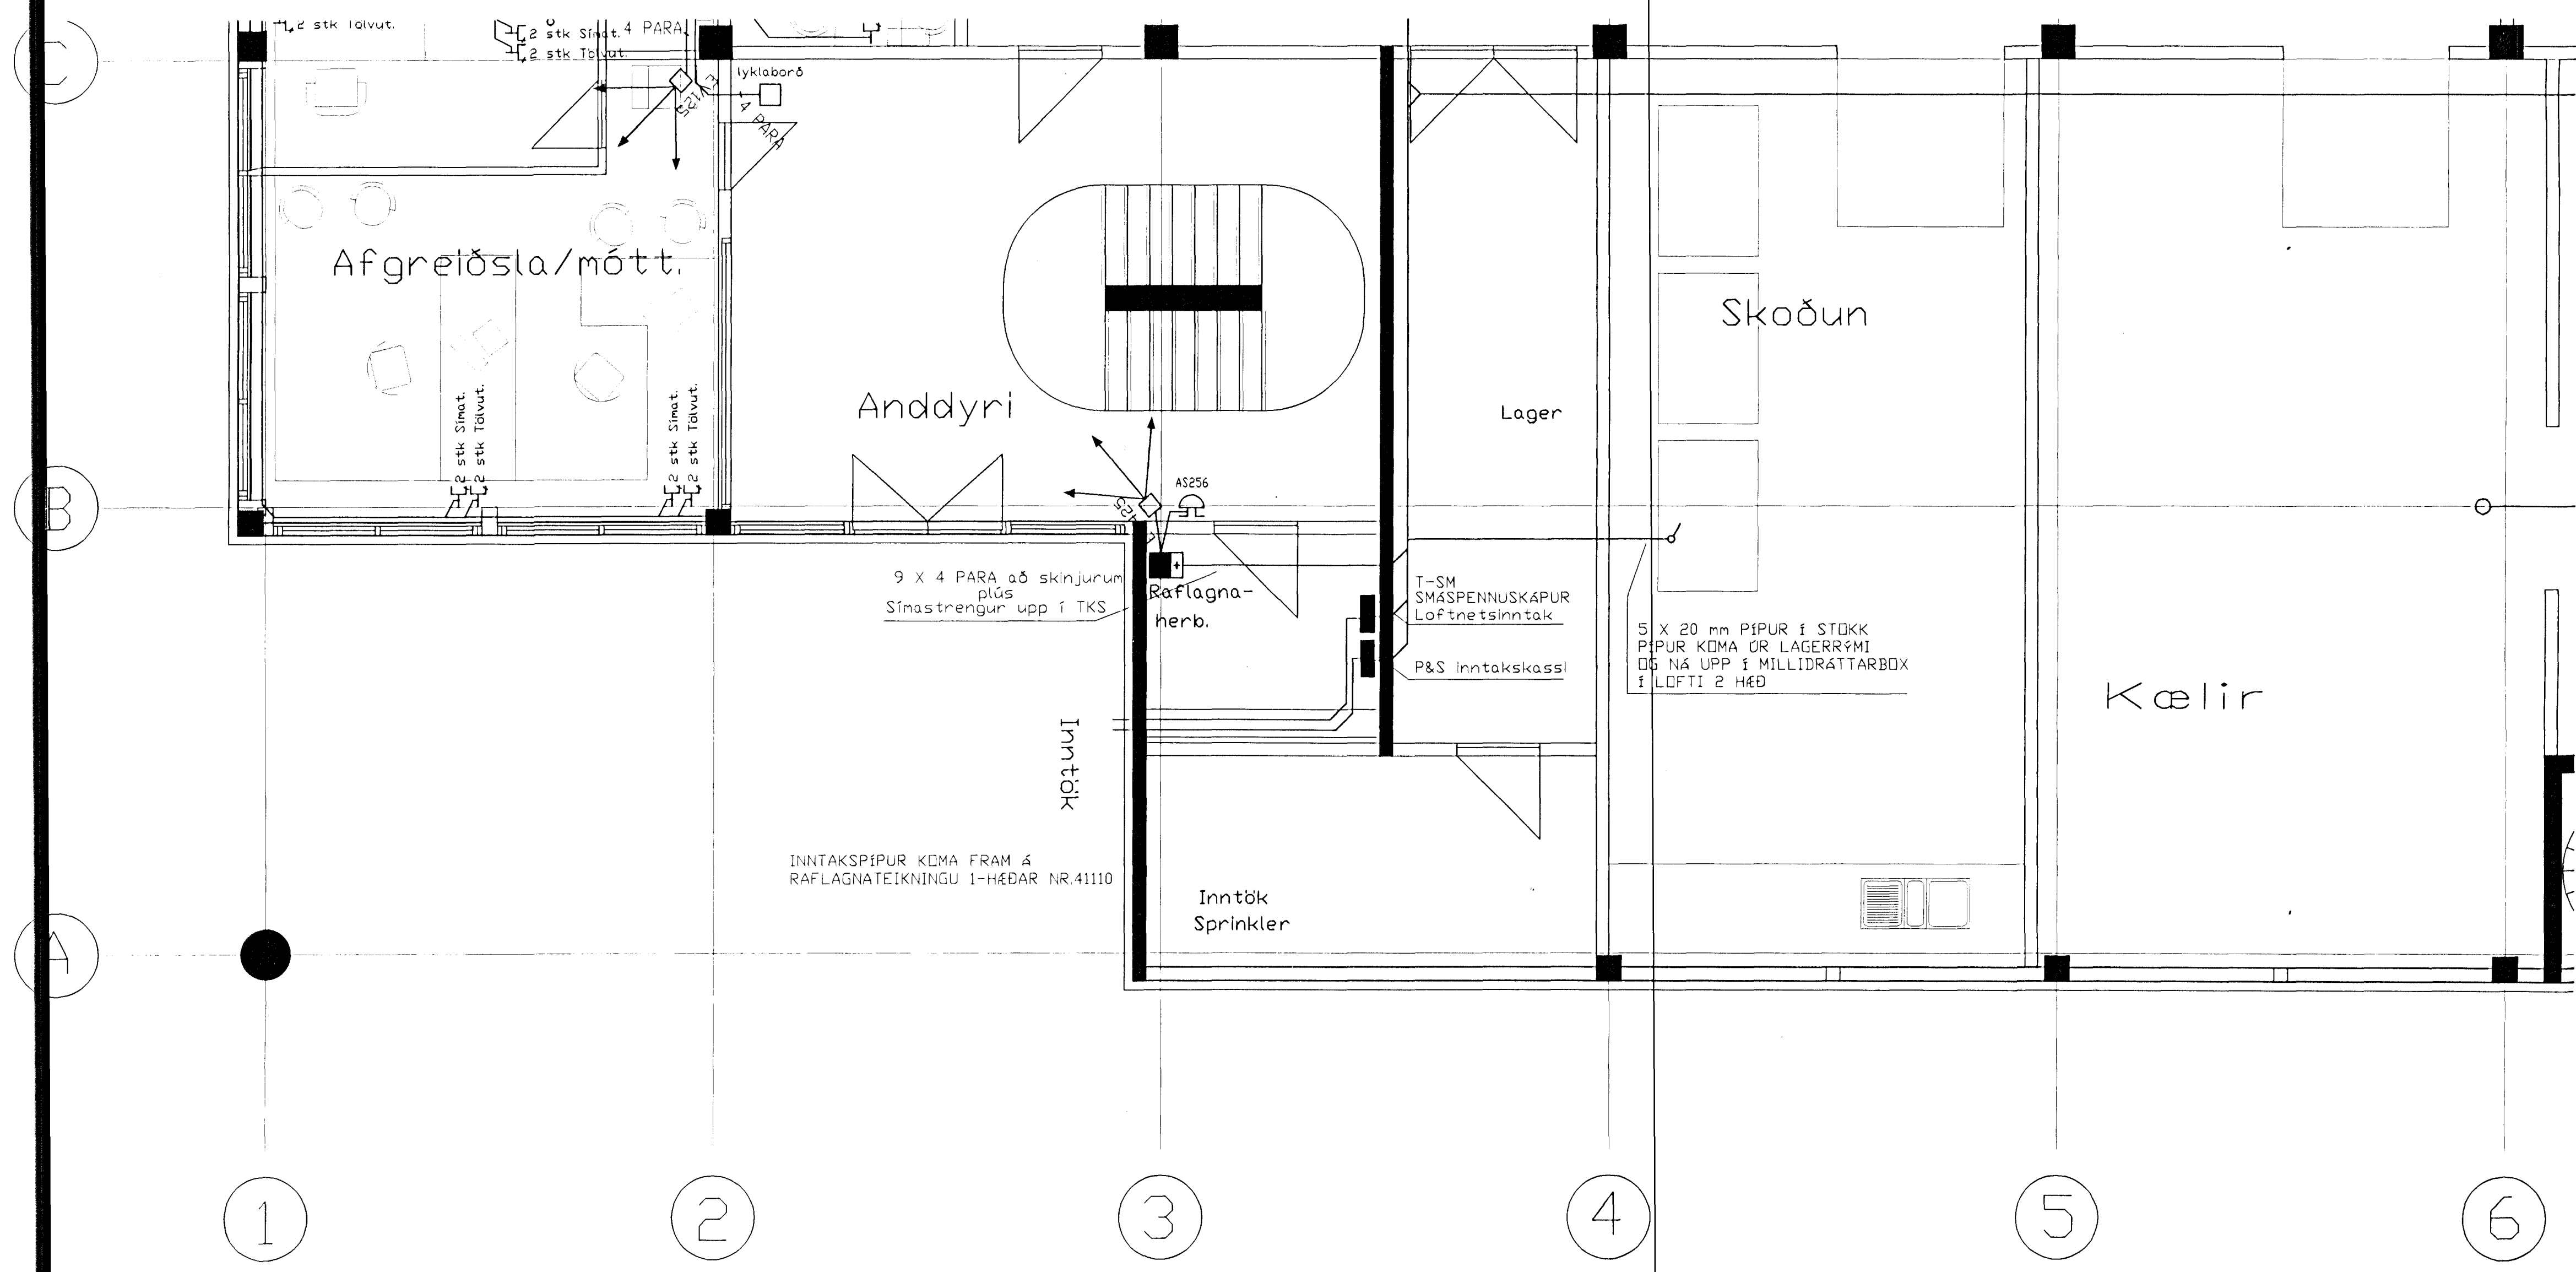

REYNDARTEIKNING

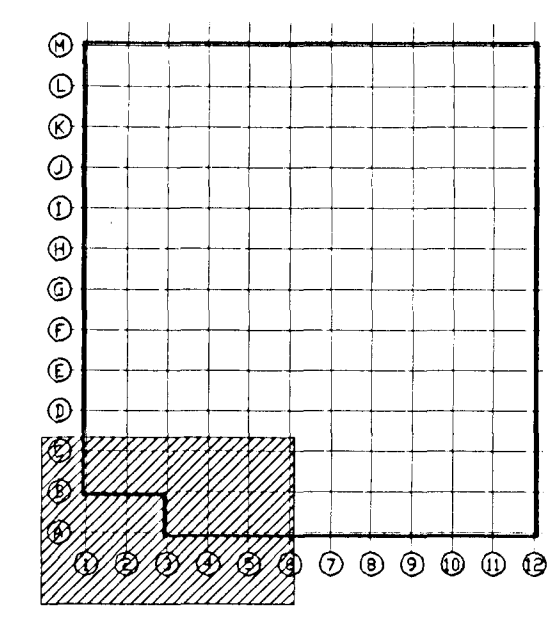

T11 TEIKNISTOFAN SMÍÐJUVEGI 11, 200 KÖP. S.564 4680 FAX: 564 4681

ARKITEKTAHÖNNUN Steinir Halsson BFI Katrín Ragnarsdóttir FAI Ágúst Þórðarson BFI	VERKFRÆÐITEIKNINGAR Bjarni Arnason TFI Ragnar Gunnarsson TFI	RAFLAGNAHÖNNUN Hannes Snabjörn Sigurjónsson TFI Árni Guðni Einarsson TFI Ófeigur Sigurðsson TFI
---	--	--

Verkhætti: SÍF BIRGDAST. FORNUBÚÐIR 5 HF
Verkhliuti: SMÁSPENNULAGNIR 1-HÉÐAR
Uniskrift: *Hannes Bj*

Msk. 1:50	Hornd. ÖS/HS/ÁGE
Daga 28.08.97	Teknd. HS
Beyti 24.11.98	Verfnd. ÁGE/ÖS
Fjöldi blaða 45	Blað nr. 42101