



Byggingafróðingur Hafnarfjarðar
Móttækibúnaður
28 SEP 2012
Sigurður Steinar Jónsson

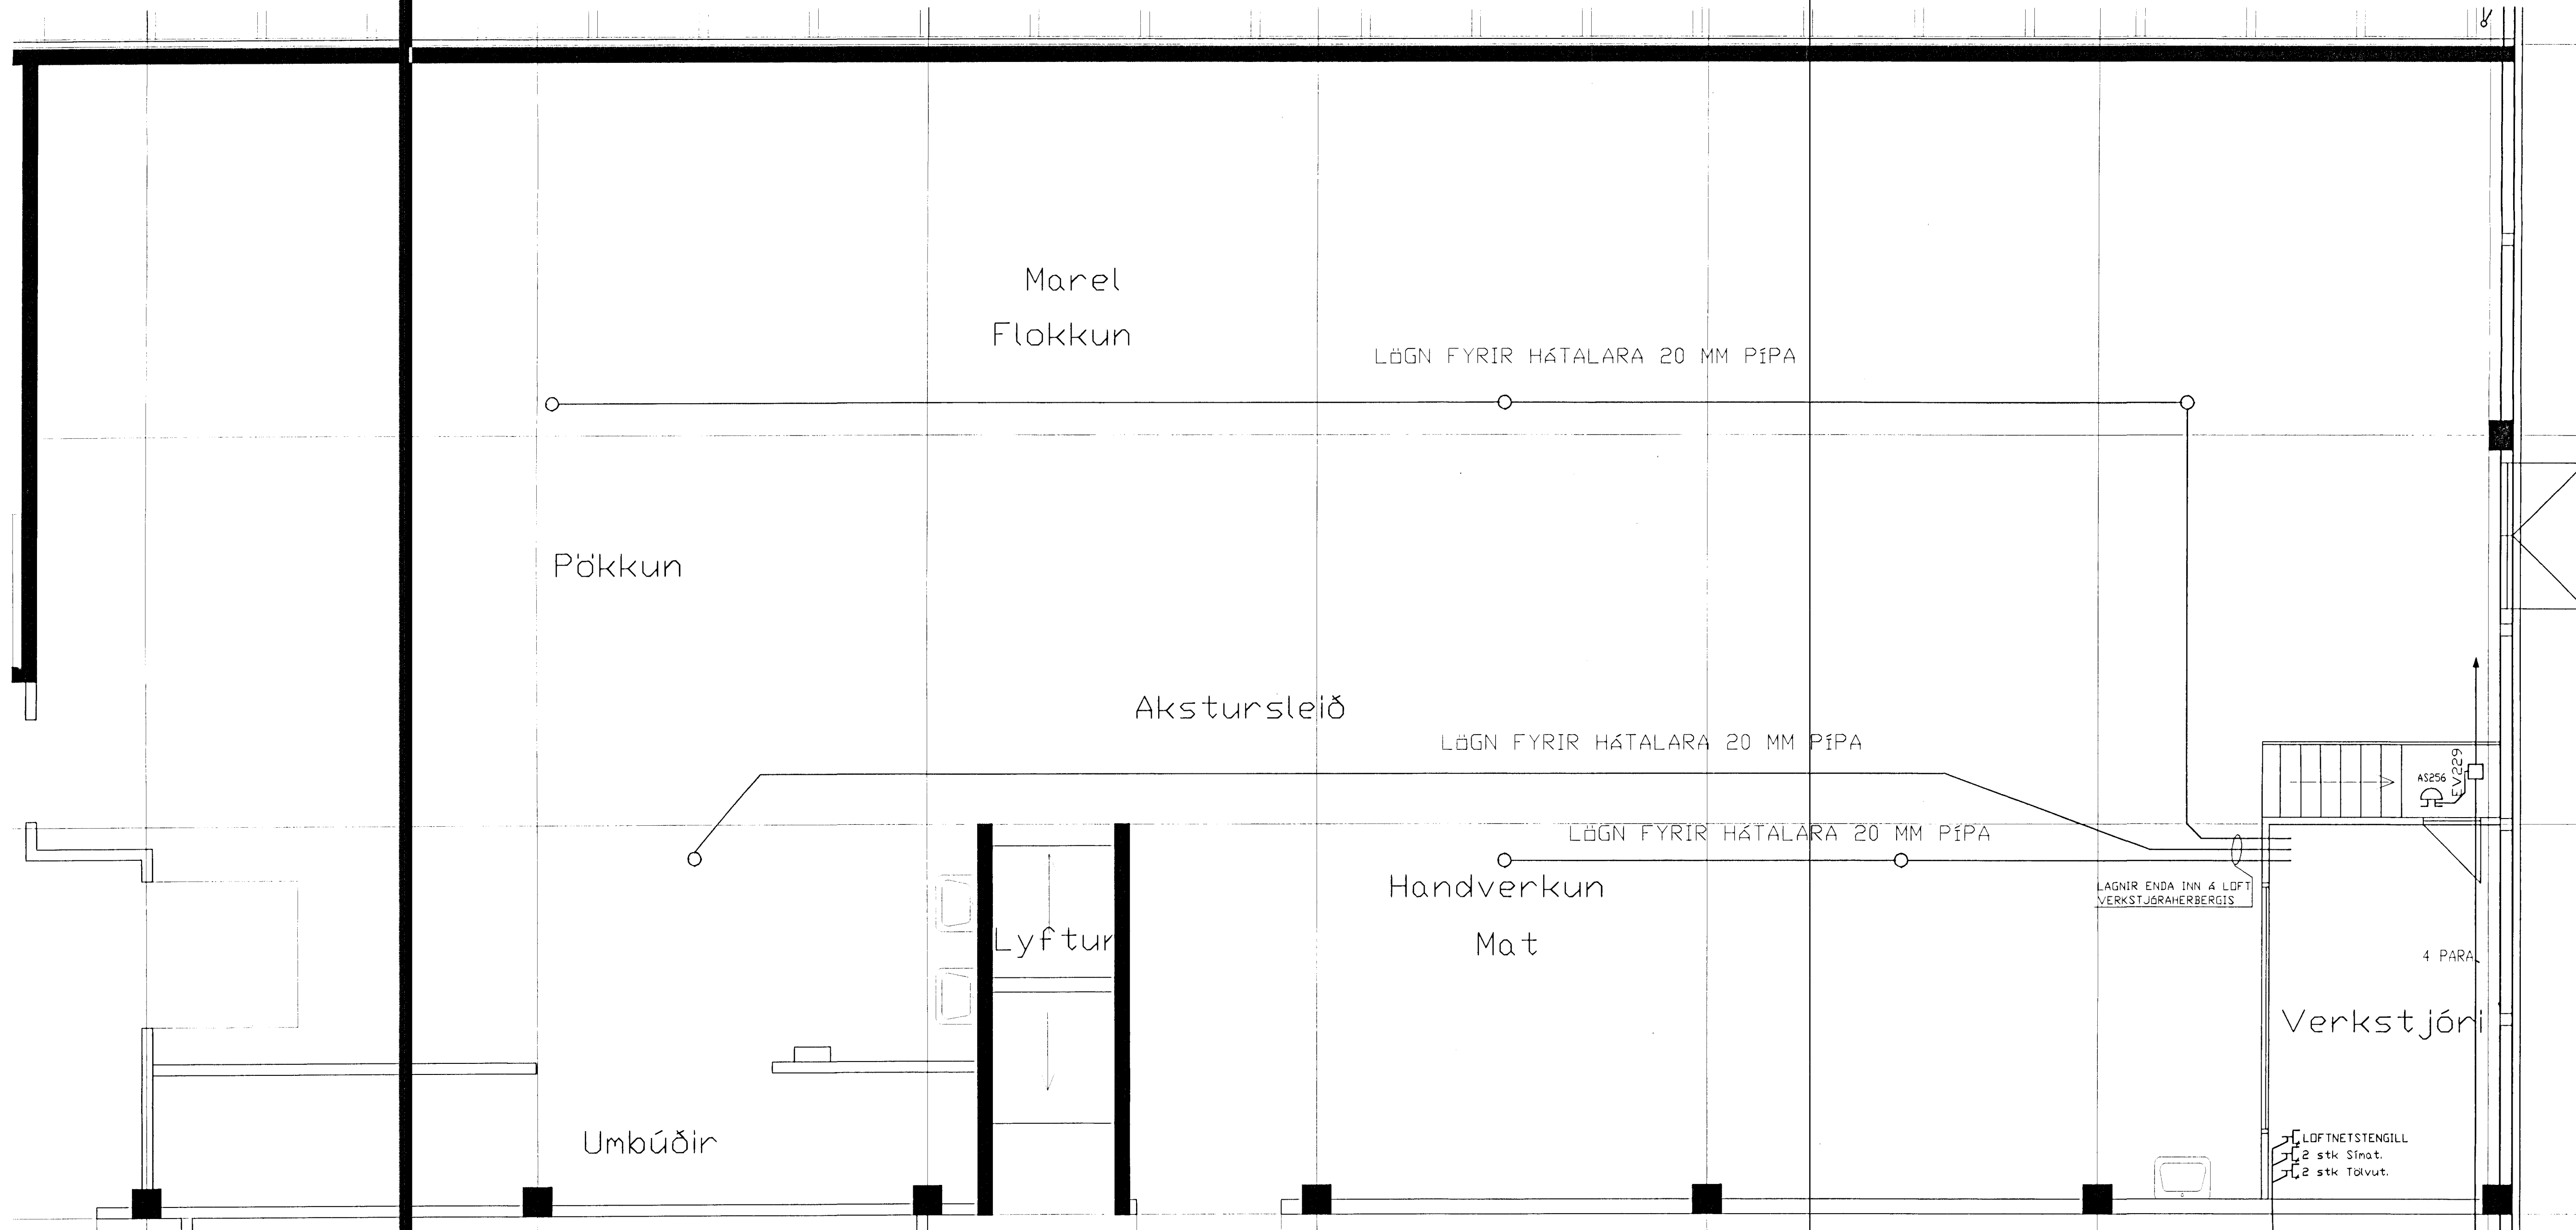

REYNDARTEIKNING

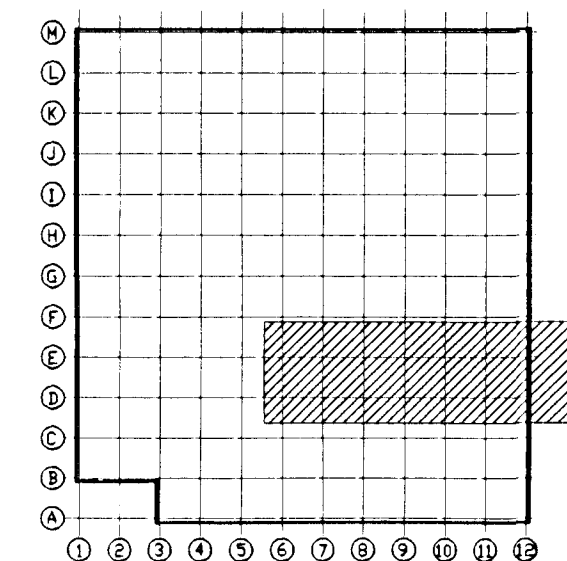

T11 TEIKNISTOFAN SMÍÐJUVEGI 11, 200 KÖP. S.564 4680 FAX: 564 4681	
ARKITEKTAHÖNNUN Stefán Halsson BFI Krislín Ragnarsón FAI Ágúst Þóroddsson BFI	VERKFRÉDITEIKNINGAR Bjarni Árnason TFI Ragnar Gunnarsson TFI
RAFLAGNAHÖNNUN Hannes Snabjörn Sigurjónsson TFI Árni Guðni Einarsson TFI Ófeigur Sigurðsson TFI	
Verkefni: SÍF BIRGÐAST. FORNUBÚÐIR 5 HF	Maa: 1:50
Verkhúti: SMÁSPENNULAGNIR 1-HÉÐAR	Daga: 26.08.97
Unirskrift: <i>Hannes Sig</i>	Breytt: 24.11.98
	Fjöldi blaða: 45
	Blað nr.: 42106