



Byggingafulltrúi Hafnarfjarðar
Móttekið þann
28 SEP 2012
Sigurður Steinar Jónsson

Kæligeymsla
1907,1m²

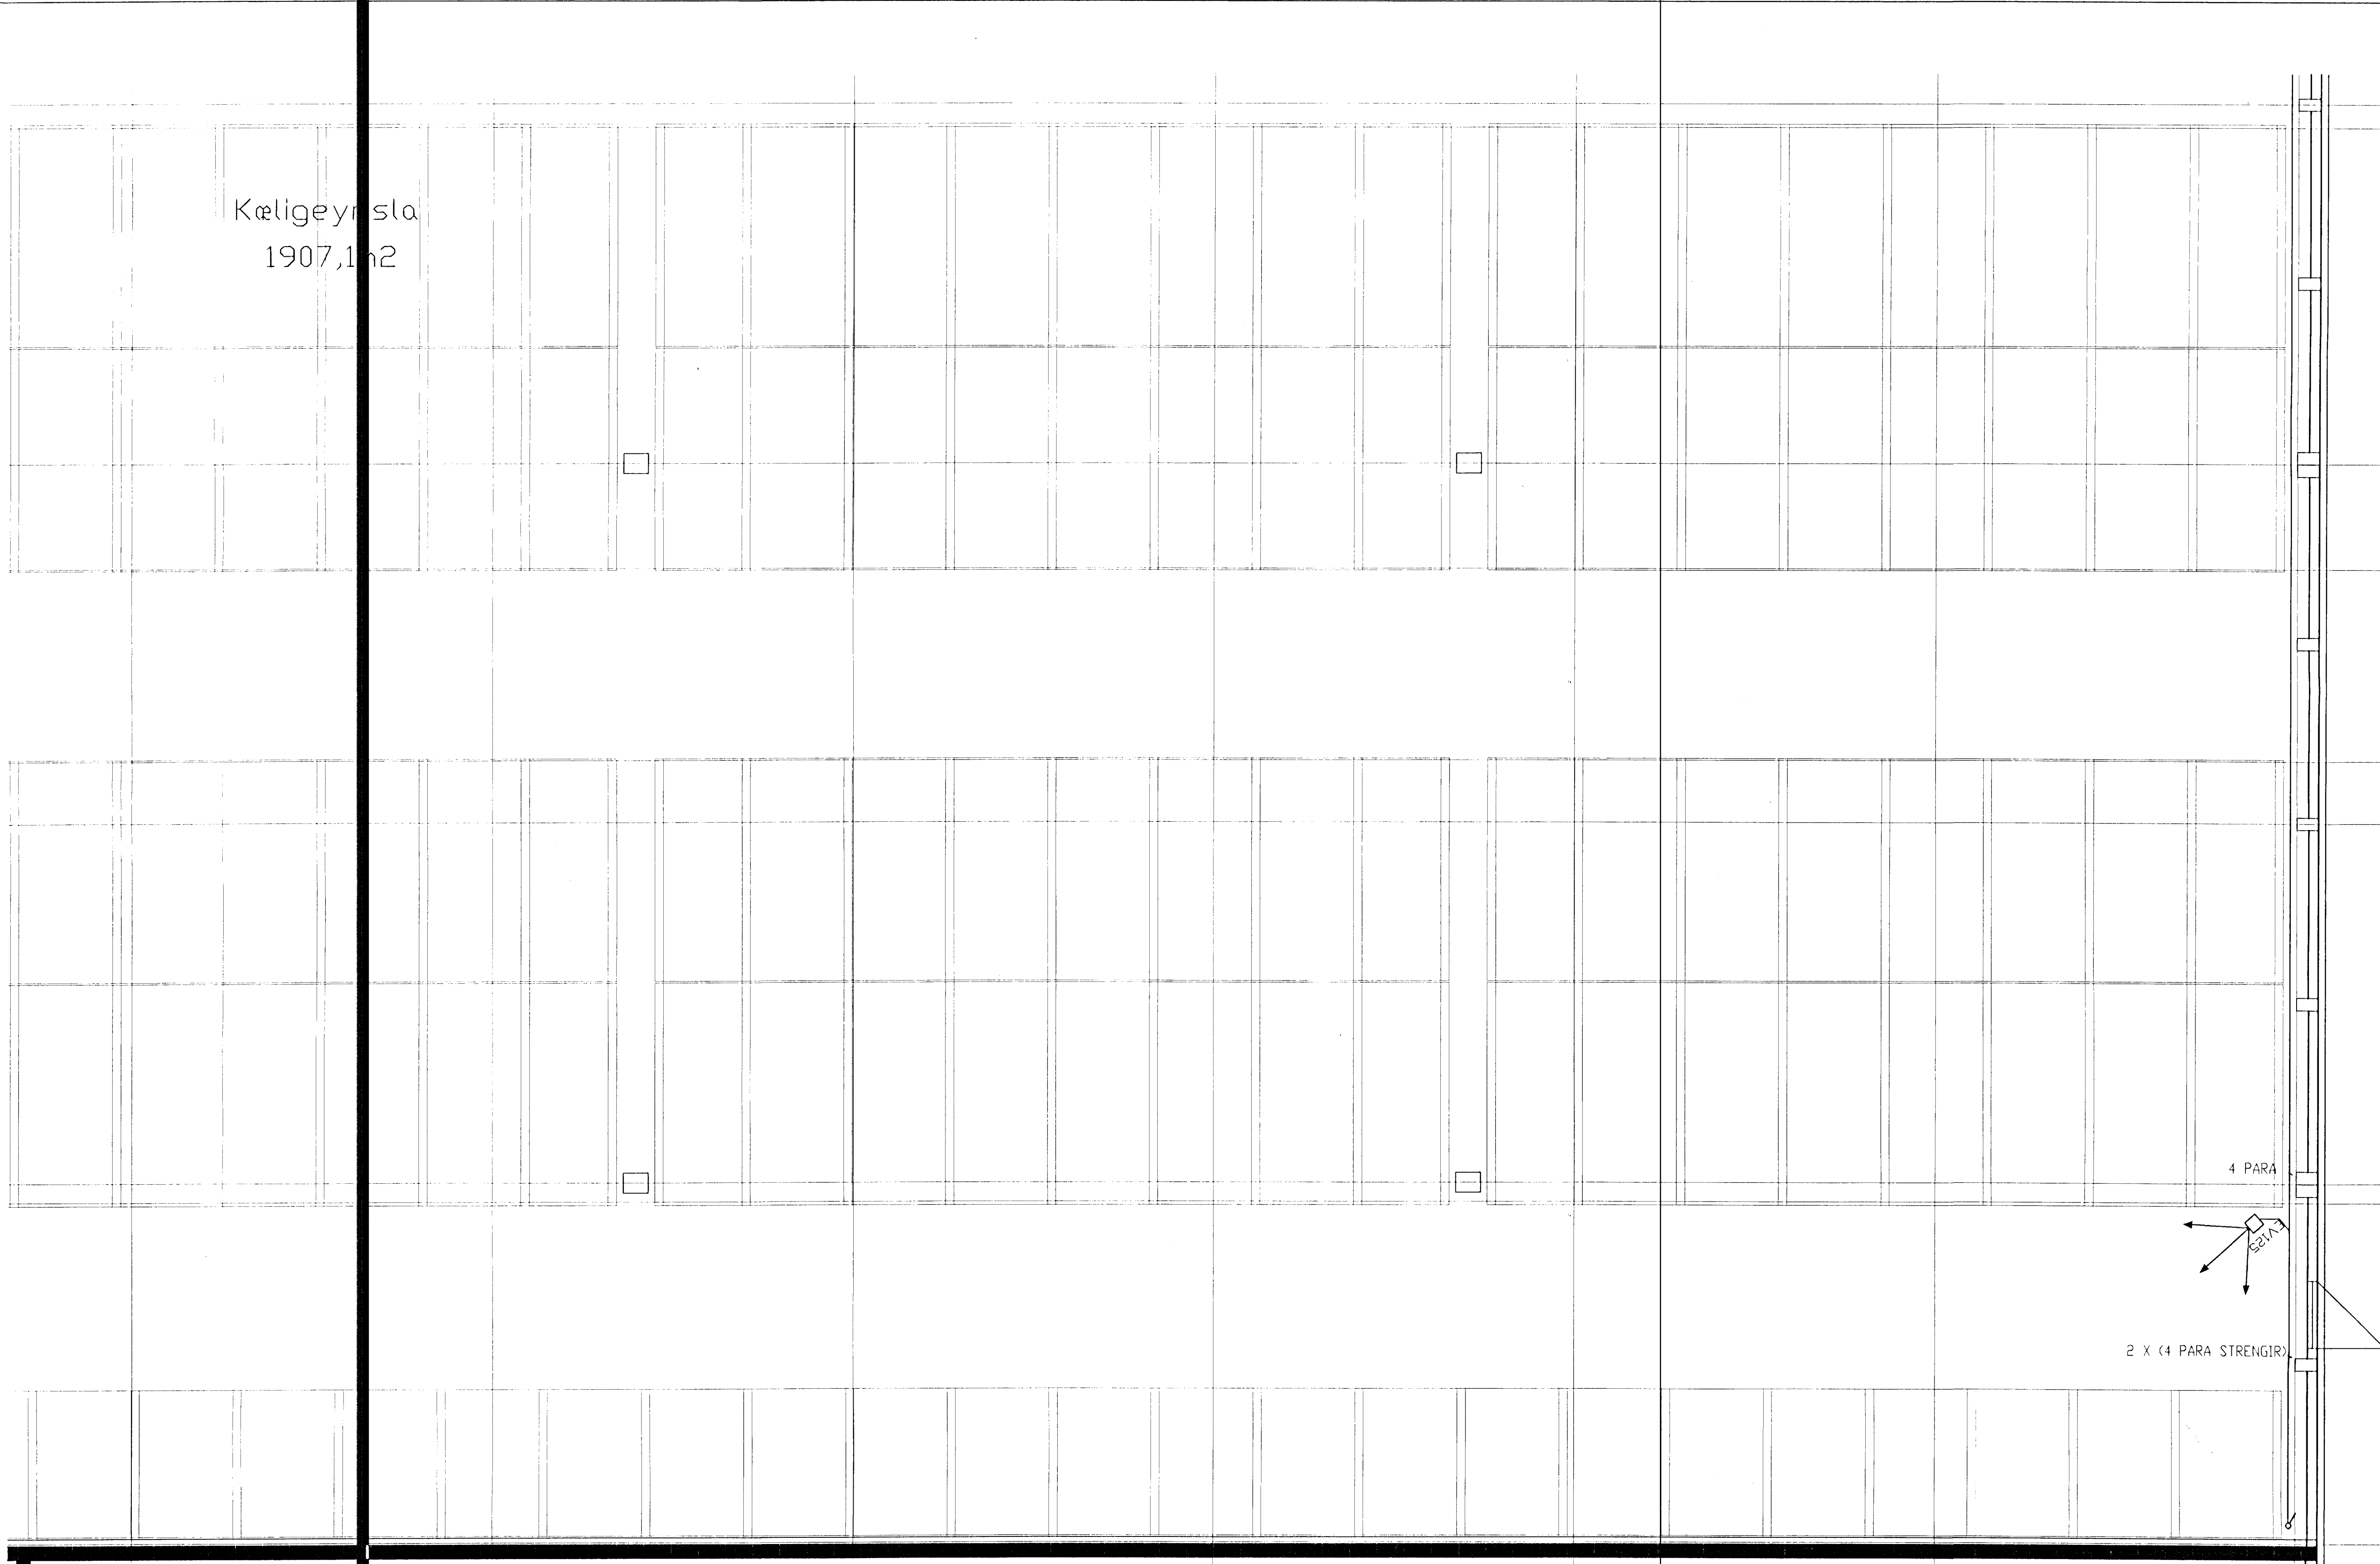

4 PARA
2 X (4 PARA STRENGIR)

REYNDARTEIKNING

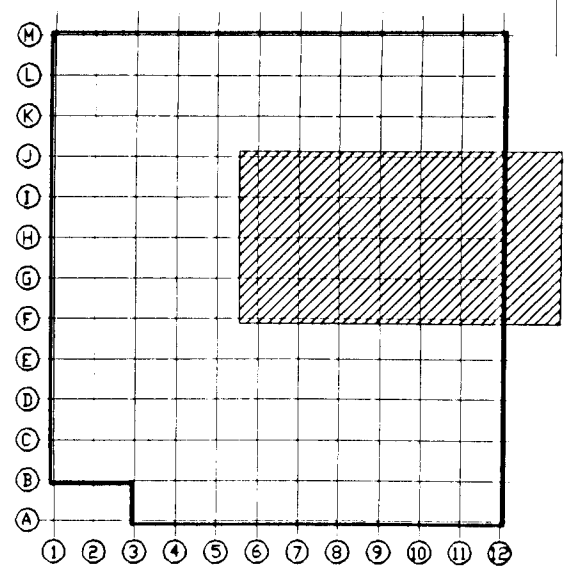

T11 TEIKNISTOFAN SMÍÐJUVEGI 11, 200 KÖP. S.564 4680 FAX: 564 4681

ARKITEKTAHÖNNUN Stefán Halsson BFI Kristinn Ragnarsson FAL Ágúst Þórðarson BFI	VERKFRÉÐITEIKNINGAR Bjarni Árnason TFI Ragnar Gunnarsson TFI	RAFLAGNAHÖNNUN Hannes Snabjörn Sigurjónsson TFI Arni Guðni Einarsson TFI Ófeigur Sigurðsson TFI
---	--	--

Verkefni: SÍF BIRGÐAST. FORNUBÚÐIR 5 HF
Verkhúti: SMÁSPENNULAGNIR 1-HÆÐAR
Unirskrift: *Hannes Sig*

Msk. 1:50	Þessi 28.08.97	Teiknað: HS
Þessi 24.11.98	Teiknað: AGE/OS	
Fjöldi blaða 45	Blað nr. 42107	