
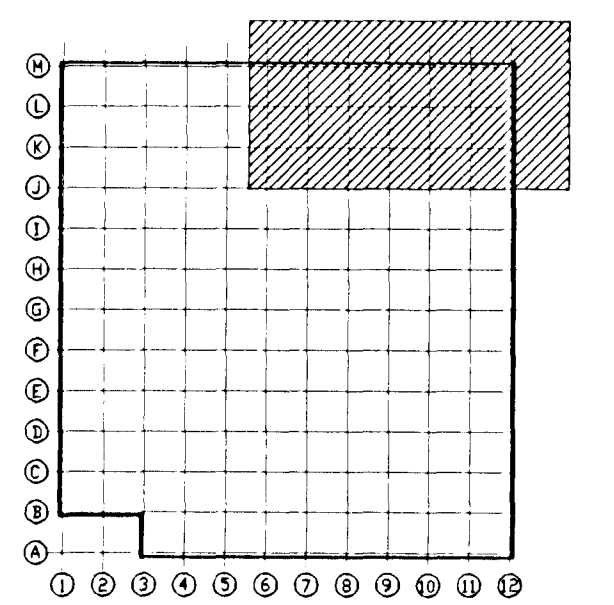


Byggingarfulltrúi Hafnarfjarðar  
Móttækil þunn  
28 SEP 2012  
Si  
Sigurður Steinar Jónsson

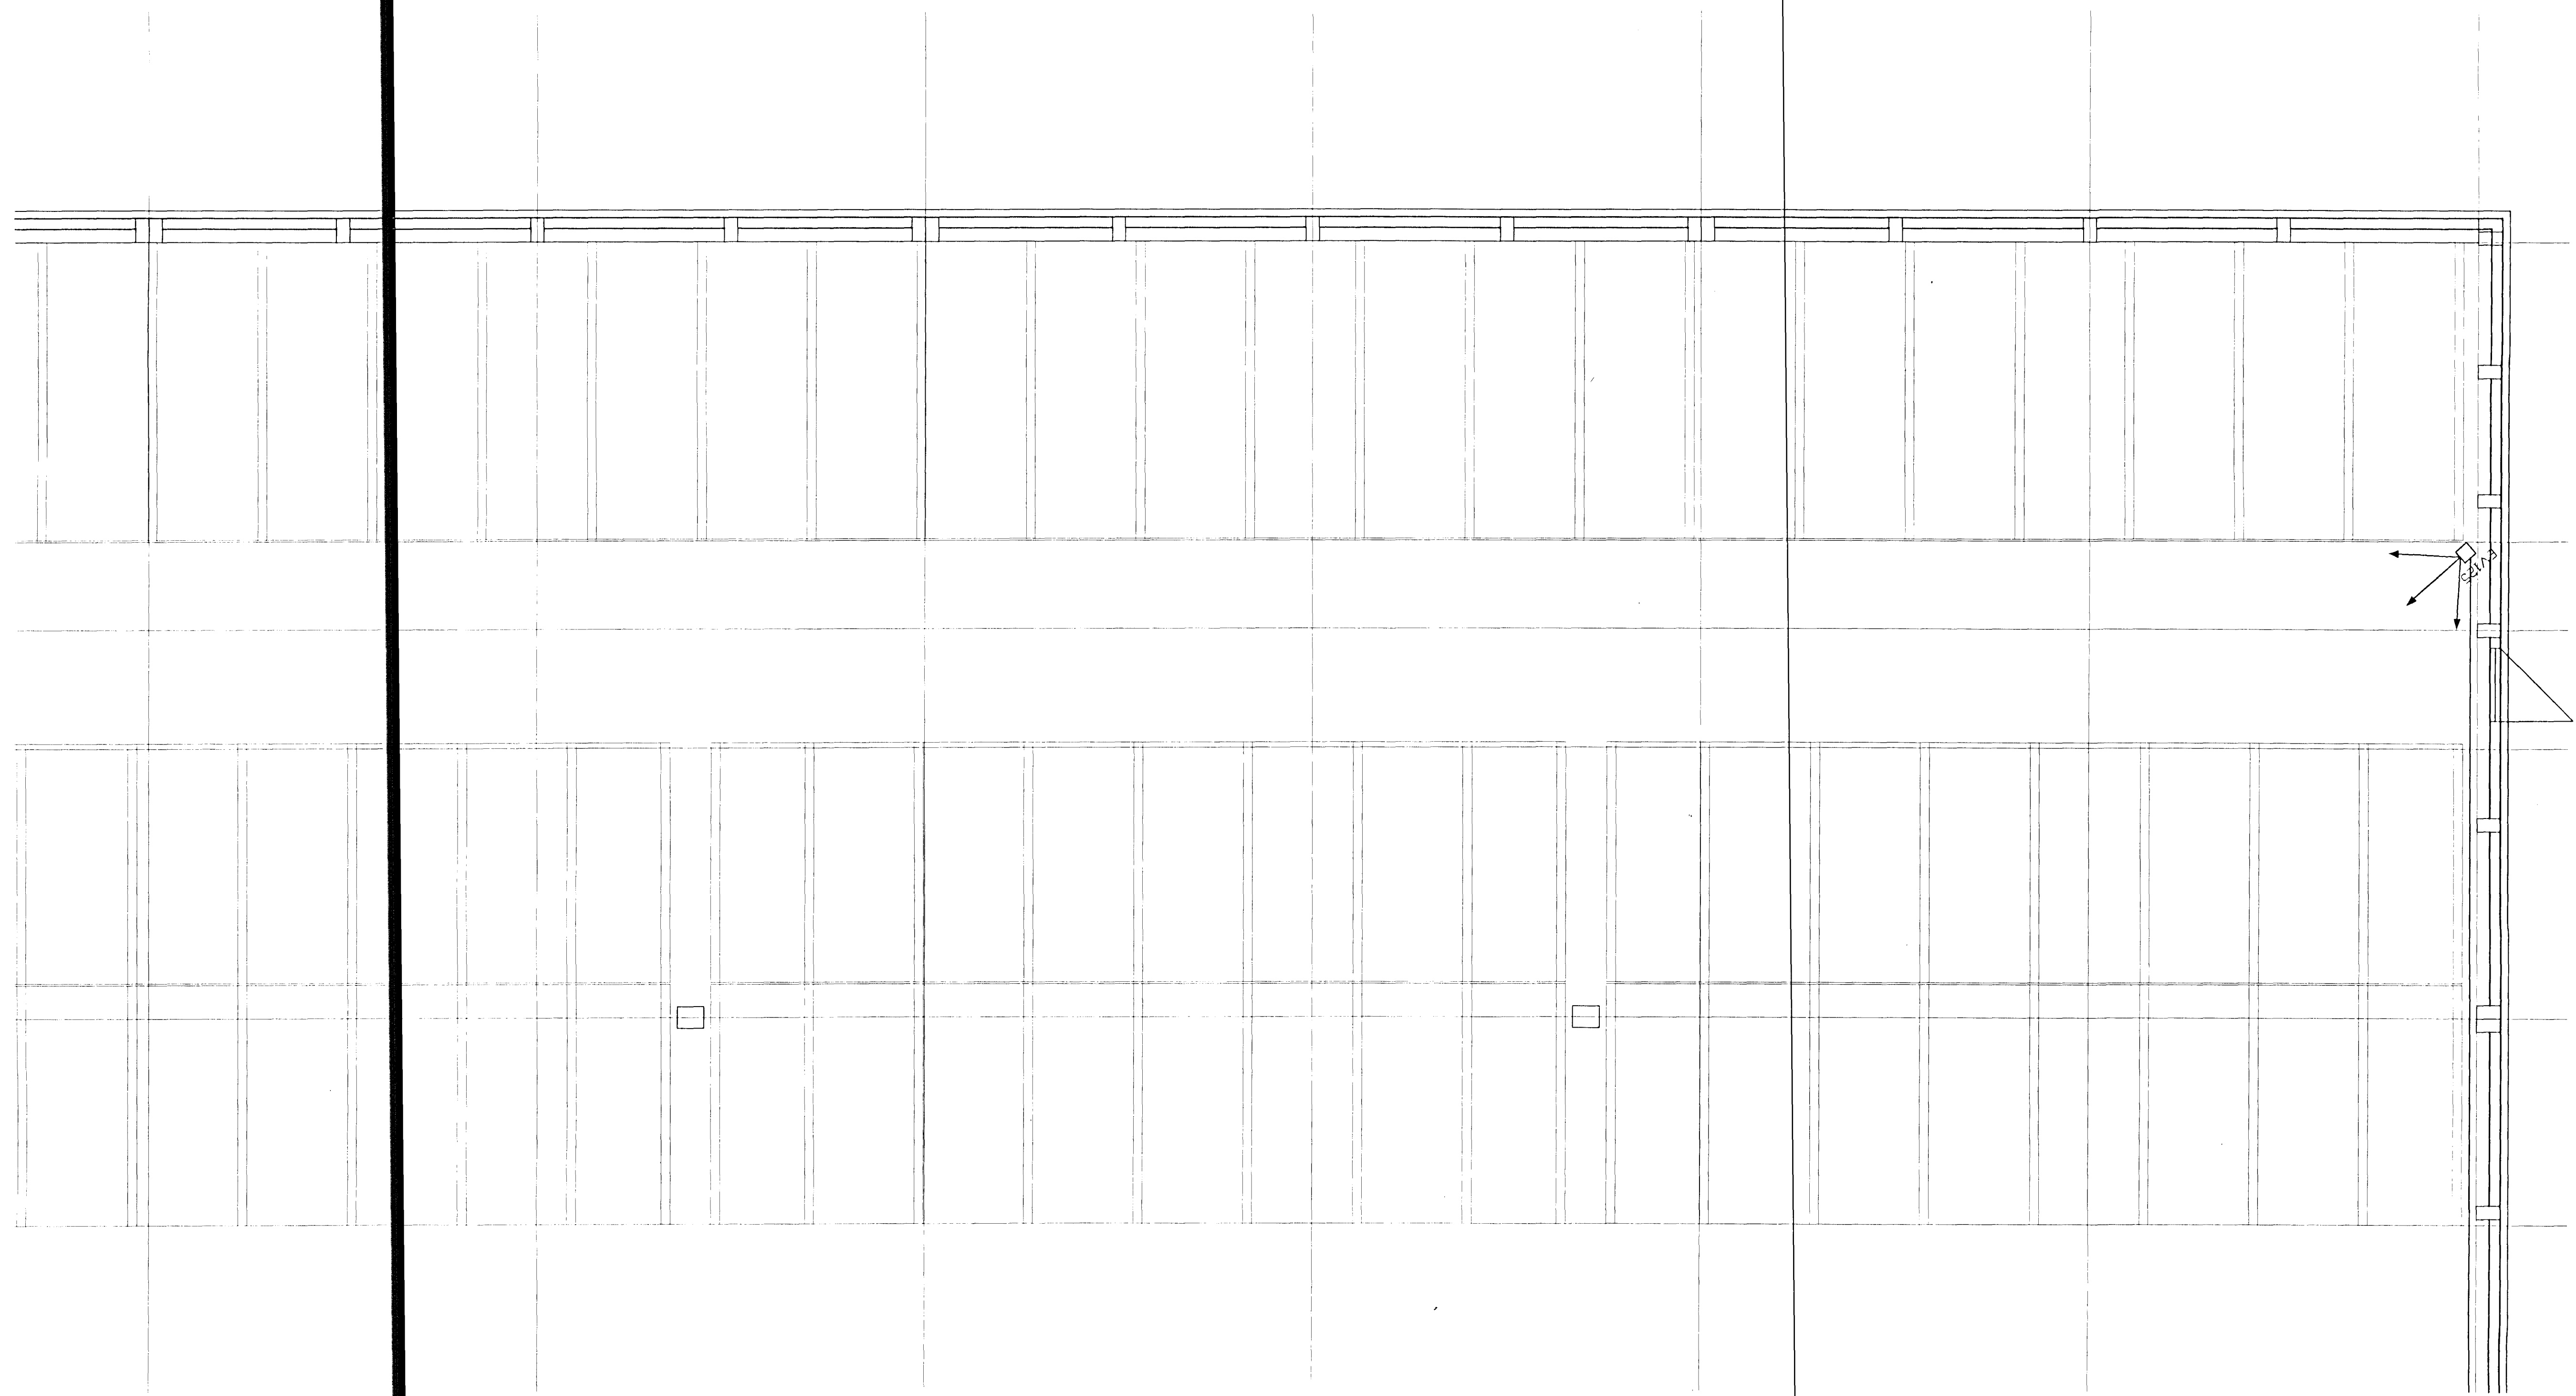

REYNDARTEIKNING

**T11** TEIKNISTOFAN SMÍÐJUVEGI 11, 200 KÖP. S.564 4680 FAX: 564 4681

ARKITEKTANÖNNUN Stefán Halsson BFI	VERKFRÉDTEIKNINGAR Bjarni Árnason TFI	RAFLAGANÖNNUN Hannes Snaabjörn Sigurjónsson TFI
Kristinn Ragnarsson FAL	Ragnar Gunnarsson TFI	Árni Guðni Einarsson TFI
Ágúst Þórðarson BFI	Ólafur Sigurðsson	TFI

Verkhelti: SÍF BIRGDAST. FORNUBÚÐIR 5 HF	Mkv. 1:50	Horning: OS/HS/AGE
Verkhili: SMÁSPENNULAGNIR 1-HÆÐAR	Daga 26.08.97	Teknað HS
Unirskrift: Hannes Sig	Þrexti 24.11.98	Yfirf. ACE/OS
	Fjöldi blaða 45	Blað nr. 42108