
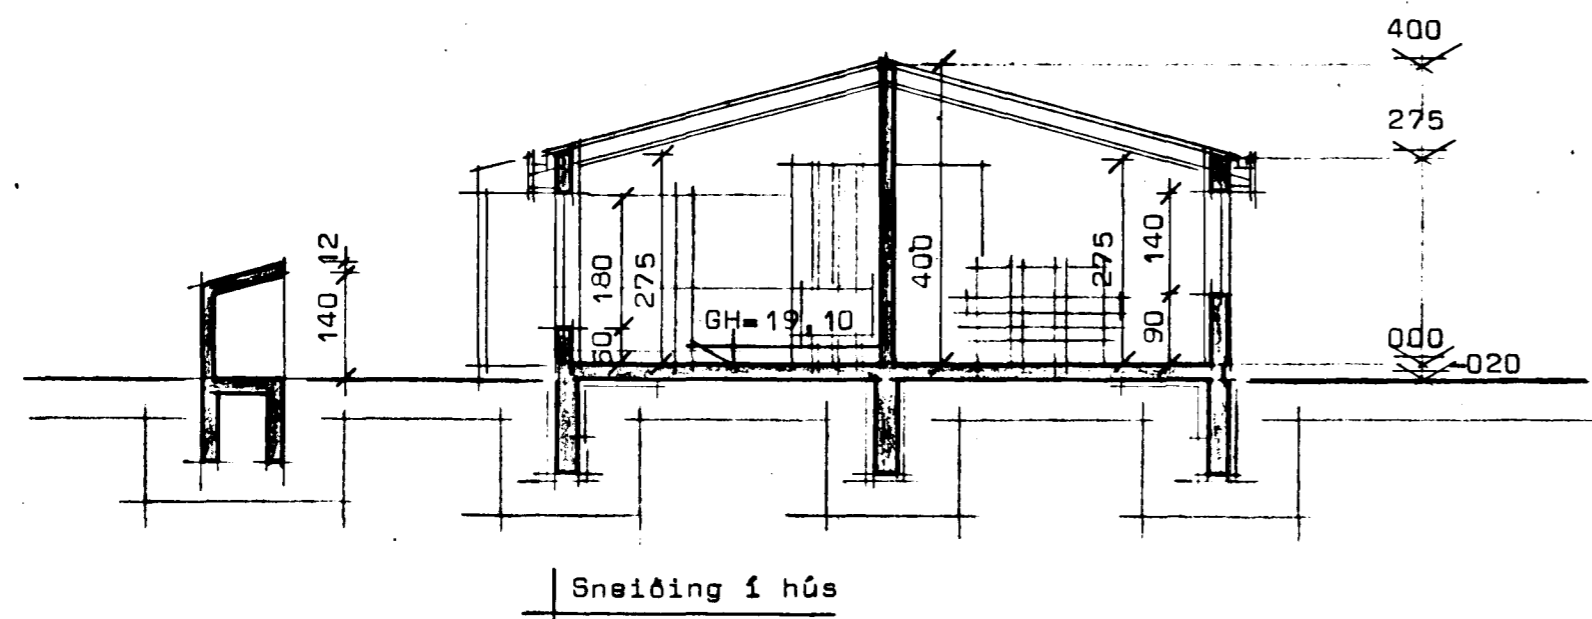
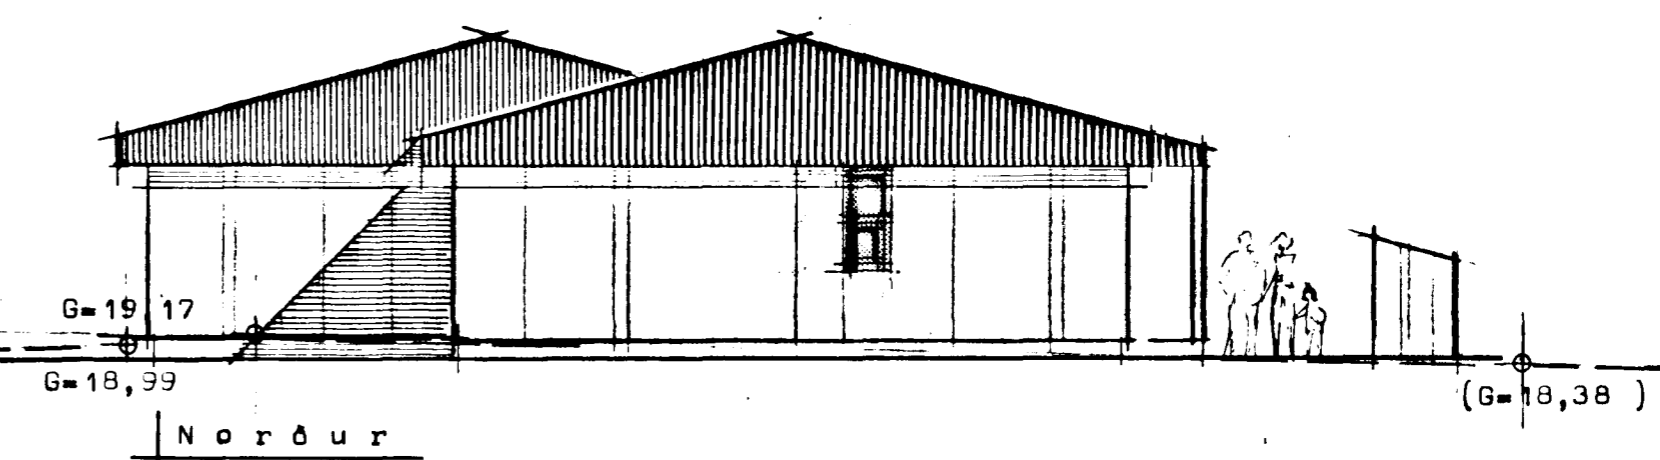
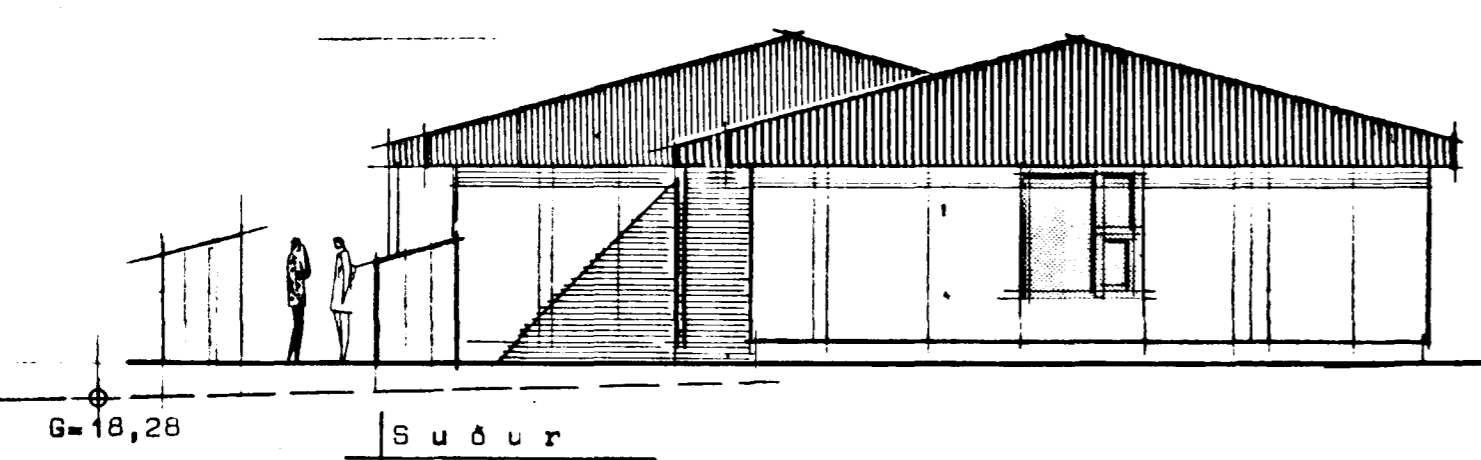
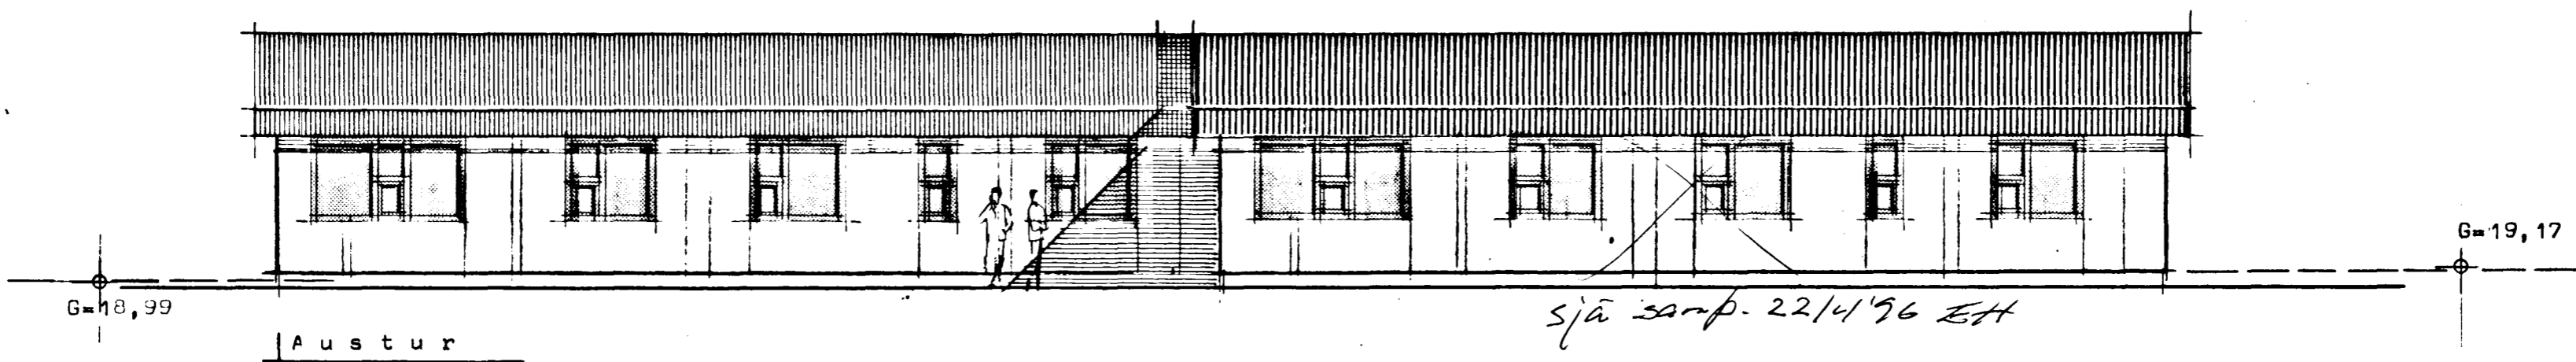


Furuberg 13-15 Hafnarfirði

2600-0130-01

Samþykkt á landi byggisráðs
númer 5/12 1984
BYGGINGAVALTFRÓM
I HAFNARFIRÐI
S. Sigurdsson

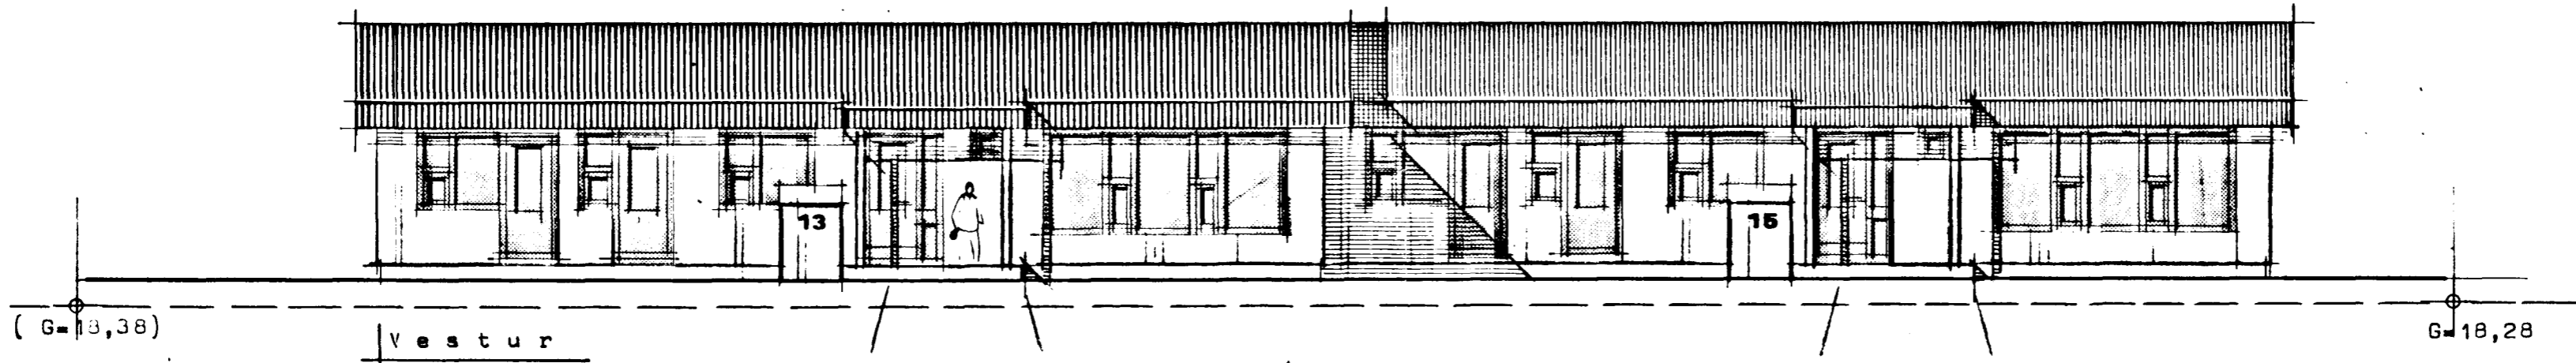

STADALHÚS
TEKNISTOFA SÍÐUMÚLA 31 SÍMI 83141

VERKEFNI	DAGS.	1984	VERK NR
Ótítt og sneiðingar	MKV.	1:100	84-26
Furuberg 13-15 Hafnarfirði	BR.		
	BLAD NR	1.02	
<i>Sigurdur Gudmundsson</i>		<i>Sigurdur P. Kristjánsson</i>	
SIGURDUR GUDMUNDSSON		SIGURDUR P. KRISTJÁNSSON FTFÍ	