
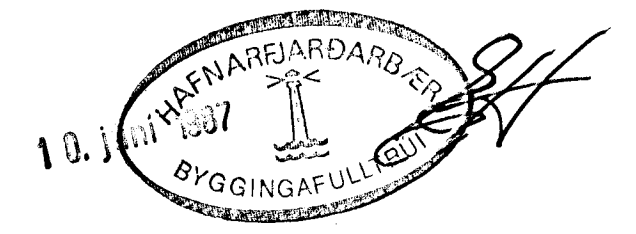


AFSTÖÐUMYND, M=1:500

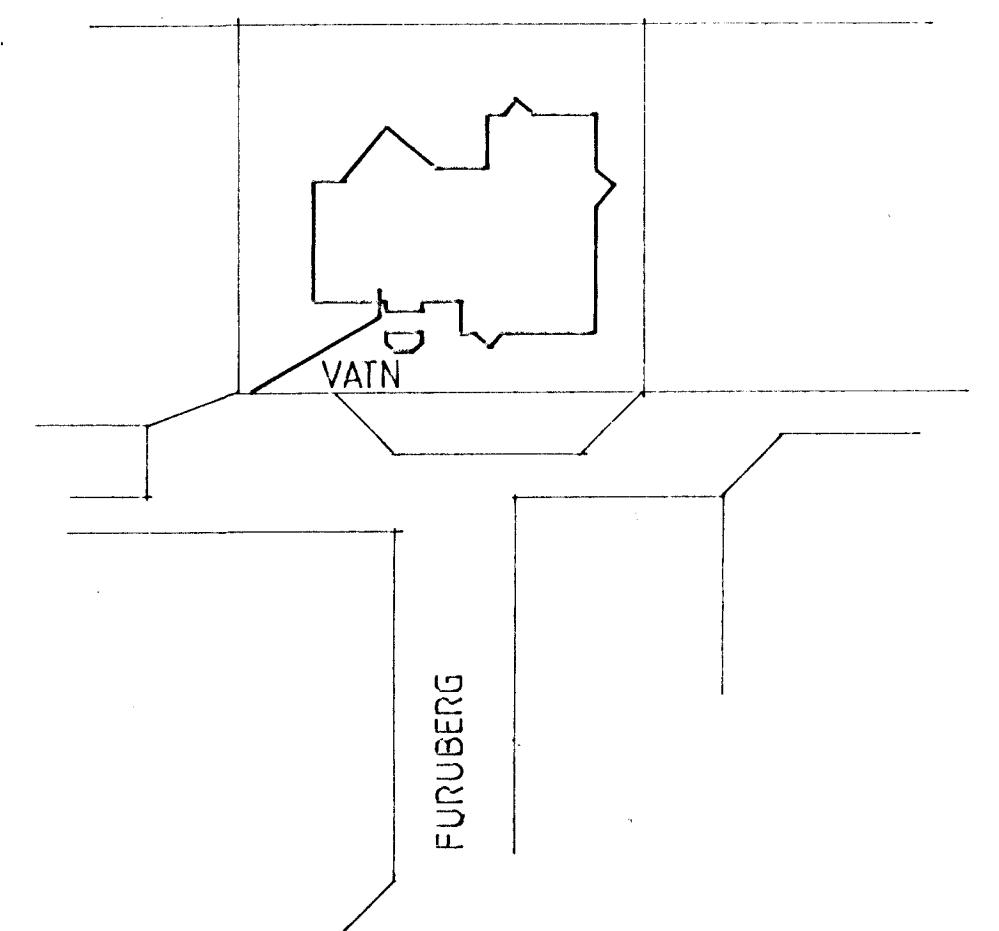

FURUBERG 5, HAFNARFIÐI.

TEIKNAD Í KEFLAVÍK, APRÍL '87.  
 EINAR STEFÁNSSON  
 VILHJÁL MUR GUDMUNDSSON, E.V.F.I.  
 VATHELDUR GRJIMMÝND, AFSTAD

TEIKNING. 22  
 M=1:50, 500