




SUDURHLID, M=1:50

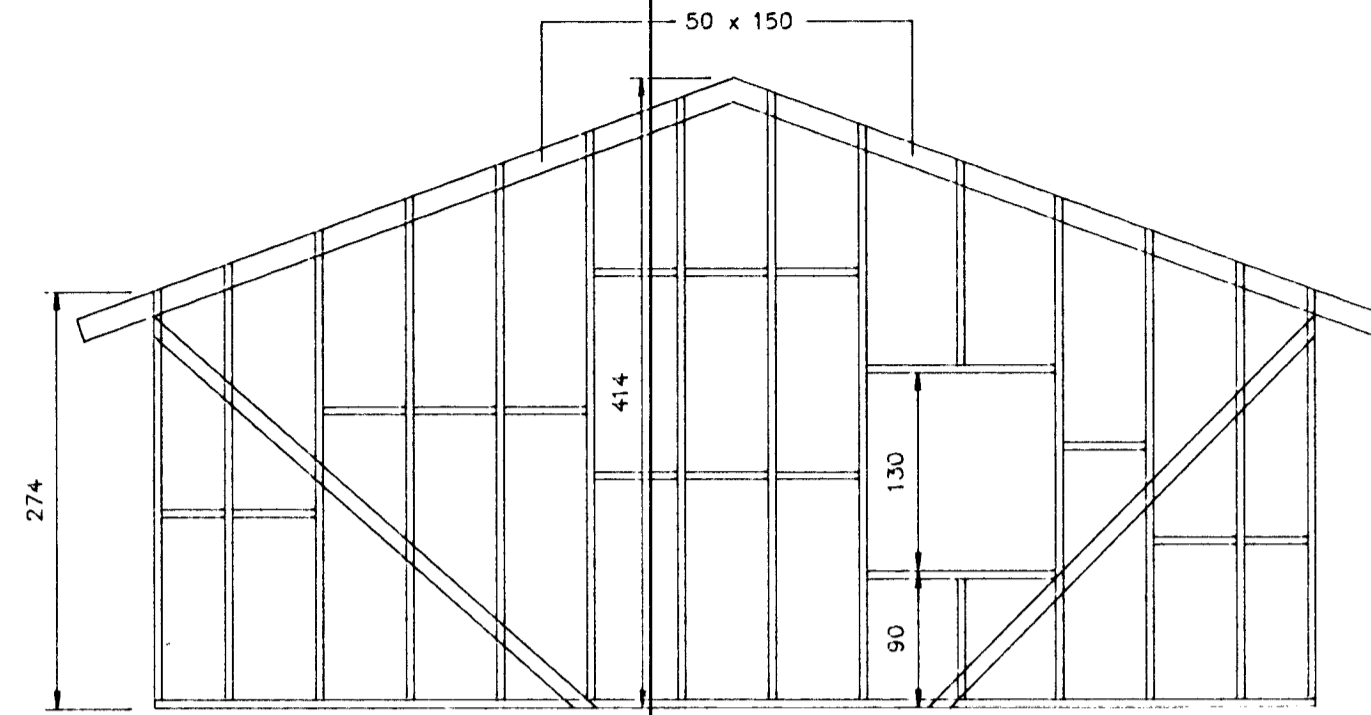

NORDURHLID, M=1:50

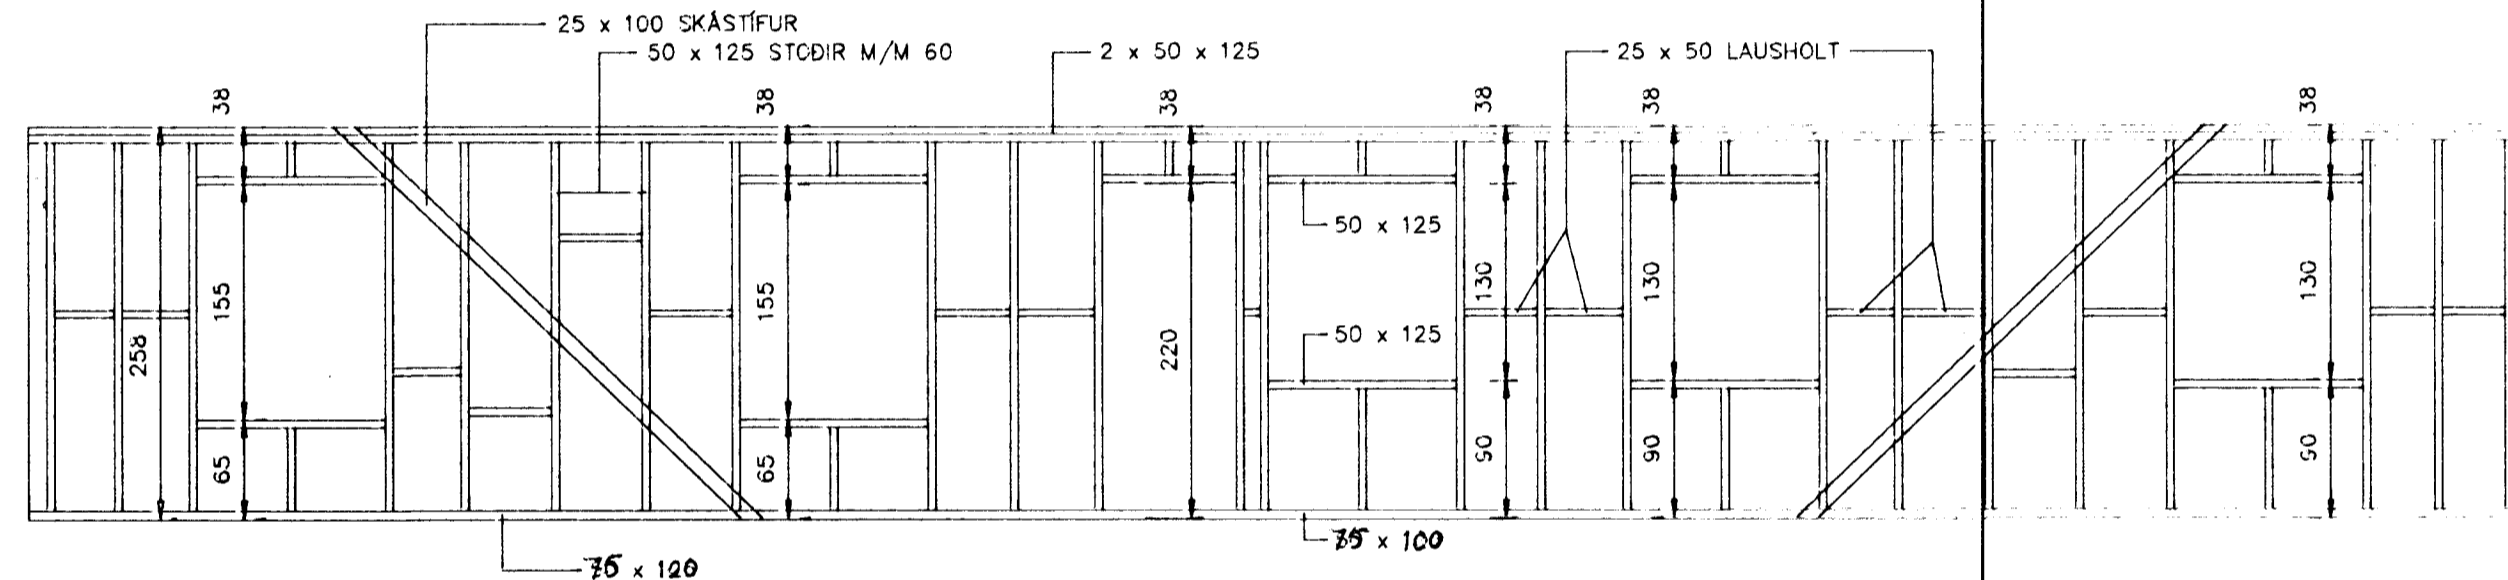

AUSTURHLID, M=1:50

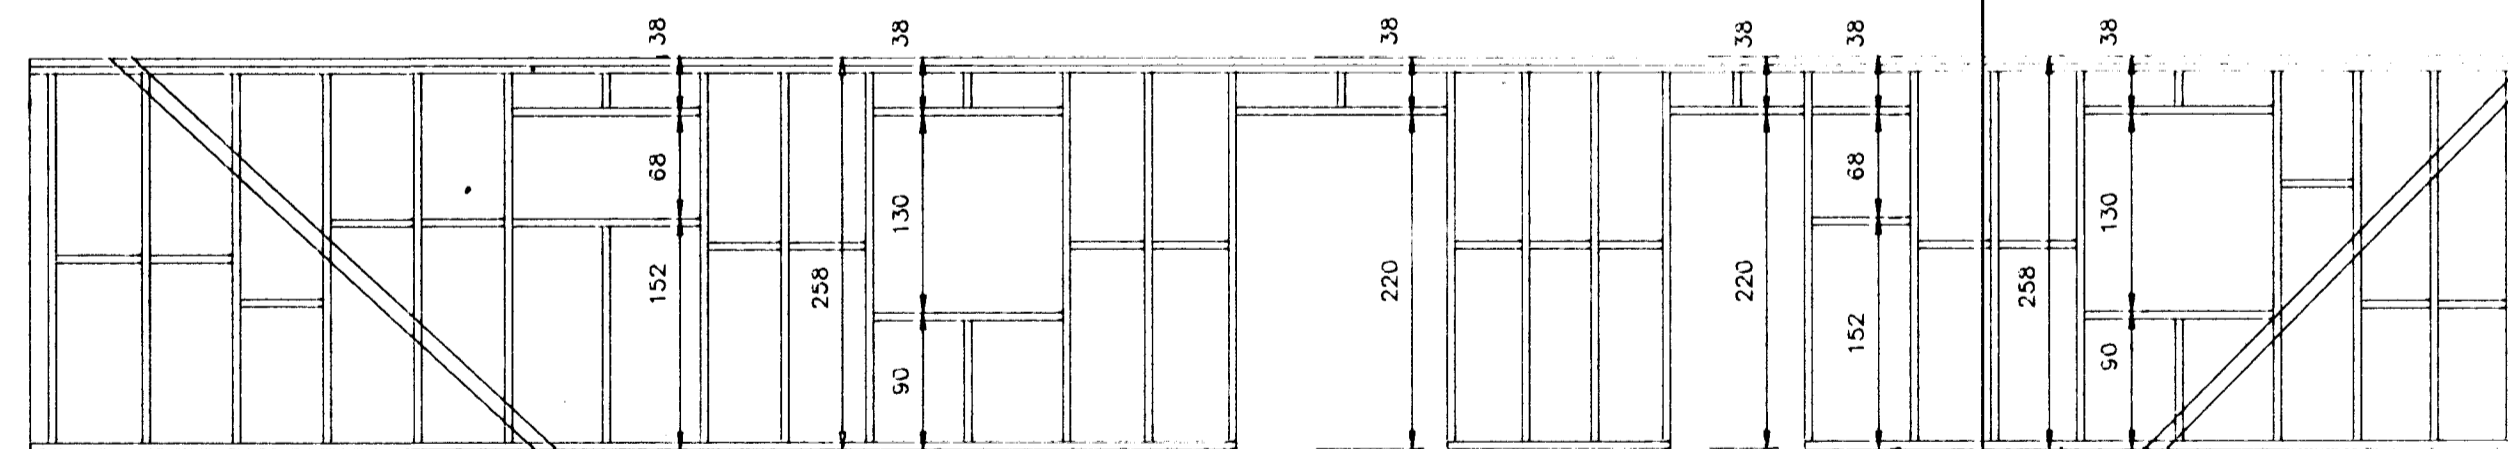

VESTURHLID, M=1:50

Byggingafultrúll Hafnarfjarðar
 Afgreitt þann
 25 MARS 1997
 Sigurbjartur Halldórsson

TEIKNISTOFA AGNARS MAGNÚSSONAR
 ARNARHRAUNI NR.47, HAFNARFIRDI. Sími: 565-1412

FURUHLÍÐ NR. 12	TEIKNING NR. A:8-2-9
M = 1:50	HAFNARFIRDI Í MARS 1997
ÚTVEGGJASTODIR Í BÚÐARHÚSS	
BYGGINGAVERKFRÉÐINGUR FVFÍ OG BYGGINGATEIKNIFRÉÐINGUR	

Agna Magnússon F.V.K.