


NR. 19

GRUNNMYND NEDRI HÆÐAR 1:50

ÁSKILID, ELÐRI
TEIKNING ÓGILD

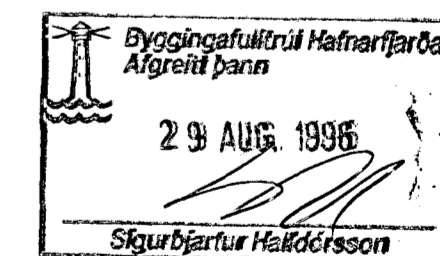


SKÝRINGAR

x MERKIR OPNANLEGT FAG.

TEIKNINGIN KEMUR Í STAÐ BLADS NR. L-02.

A	08.96	LAGNALEIDIR O.FL.
BREYTT.	DAGS.	TEXTI

ÁÖG	HANNAÐ: ÁÖG	TEIKNAD: ÁÖG	YFIRFARID: KMD	DAGS.: DES. 1995
AF	SAMPYKKT:	<i>Sigríður Halldóttir</i>		KT.: 190561-3803

VERKHEITI FURUHLÍÐ 19	HAFNARFIRDI	KVARDI 1:50	TEIKNINR. BLAD NR. L-02b
HITA- OG HREINLÆTISLAGNIR GRUNNMYND NEDRI HÆÐAR		 VERKFRÆÐISTOFA KÓPAVOGS <small>Hamraborg 7 200 Kópavogi Sími: 564 44 22 Fax: 564 44 33</small>	