


NR. 19

GRUNNMYND EFRI HÆÐAR 1:50

SKÝRINGAR

x MERKIR OPANLEGT FAG.

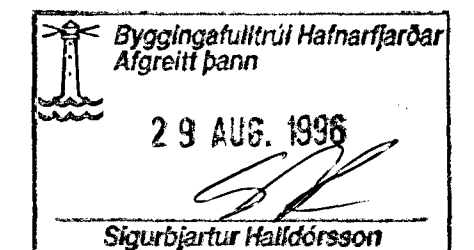

ÁSKILIÐ, ELÐRI
TEIKNING ÓGILD

TEIKNINGIN KEMUR Í STAÐ BLADS NR. L-03.

VERKHEITI	FURUHLÍÐ 19	HAFNARFIRÐI	KVARDI	1:50	TEIKNINR.	L-03b
HITT	HITA- OG HREINLÆTISLAGNIR	GRUNNMYND EFRI HÆÐAR	BLAD NR.			
A	08.96 LAGNALEIÐIR O.FL.	ÁÖG	HANNAD:	ÁÖG	TEIKNAD:	ÁÖG
BREYTT	DAGS	TEXTI	VF	SAMBÝKKT.	<i>Óskar S. Garðsson</i>	KT.: 190581-1309

