


GRUNNMÝND • 1 : 50

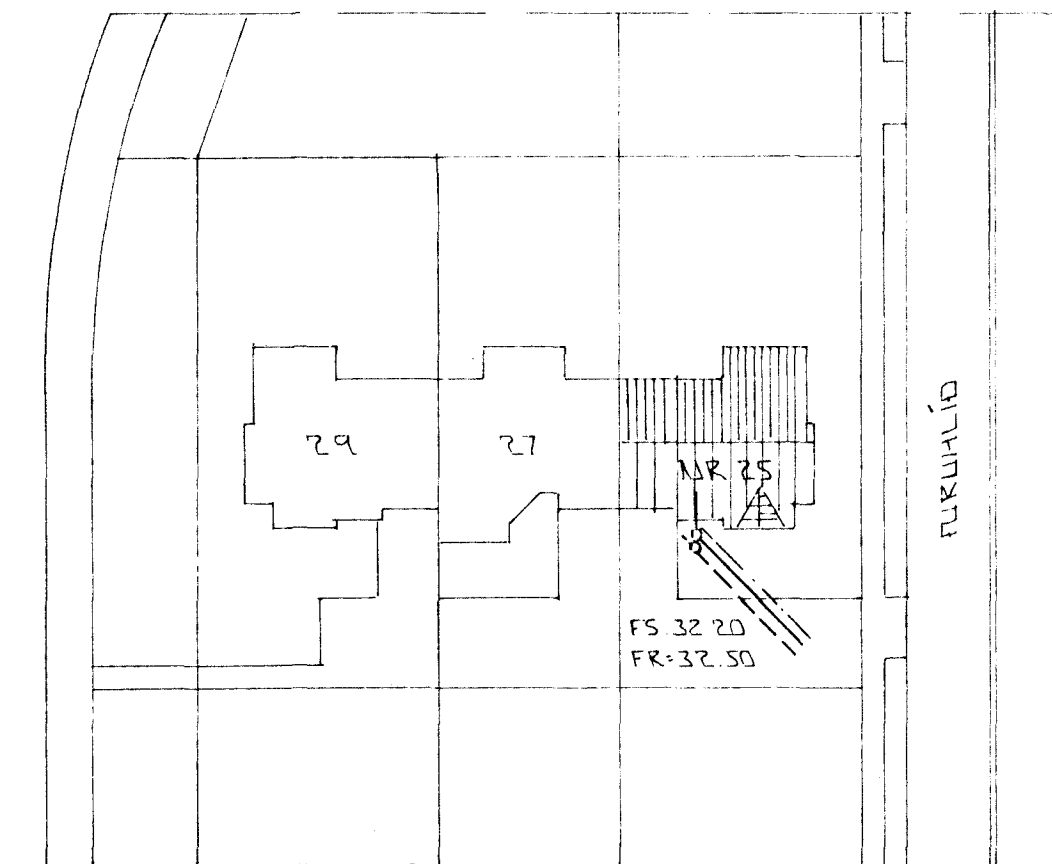

AFSTÖÐLMÝND • 1 : 500

01 JAN 97 BETT VÍÐ VEGGJUM  
BR: DAGS. EDLI BR. GT SIGN.

FURUHÍÐ 25  
HAFNARFIRÐI

GRUNNMÝND - GRUNNLAGNA  
AFSTÖÐLMÝND;

MKV • 1 : 50 • 1 : 500  
DAGS. NÓV. '96  
VERK NR. 9653  
TEIKN NR. 2-02  
HANNAD  
TEIKNAD GT  
YFIRFARID

Byggingafulltrúi Hafnarfjarðar  
Alfreitt Þann  
20 JAN. 1997  
Sigurbjartur Hildórsson

TEKNIPJÓFNA  
SIGURDAR ÞORLEIFSSONAR ehf  
STRANDGÖTU 11 • 220 HAFNARFJÖRÐUR • Sími 555 4255 • FAX 565 2875