

GRUNNMÝND. 1:50

SNID 1. 1:20


SNID 2. 1:20

SÚLA 1. 1:20

SÚLA 2. 1:20

SÚLA 3. 1:20

ÁSKILIÐ, ELÐRI
TEIKNING ÓGILD

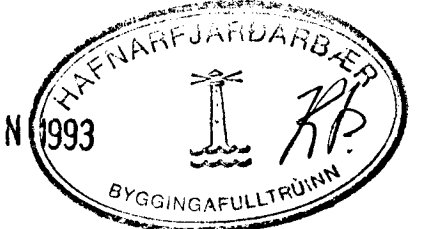

DI	09.06.93	GAT Í PLOTU	4.21
BR.NR.	DAGS	EDLI BREVTINGAR	SIGN.
FURUHLÍÐ 4 HAFNARFIRÐI			DAGS. MAI 93
VEGGIR, PLATA			HANNAÐ 4.21
MÆLIKV. 1:50, 1:20			TEIKNAD 4.21
SIGURÐUR ÞORLEIFSSON TEKNIFRÆÐINGUR F.T.F.I.			VERK NR. 9313
STRANDGÖTU 11 HAFNARFIRÐI SÍMI 54751/54255			BLADNR. 1-03