

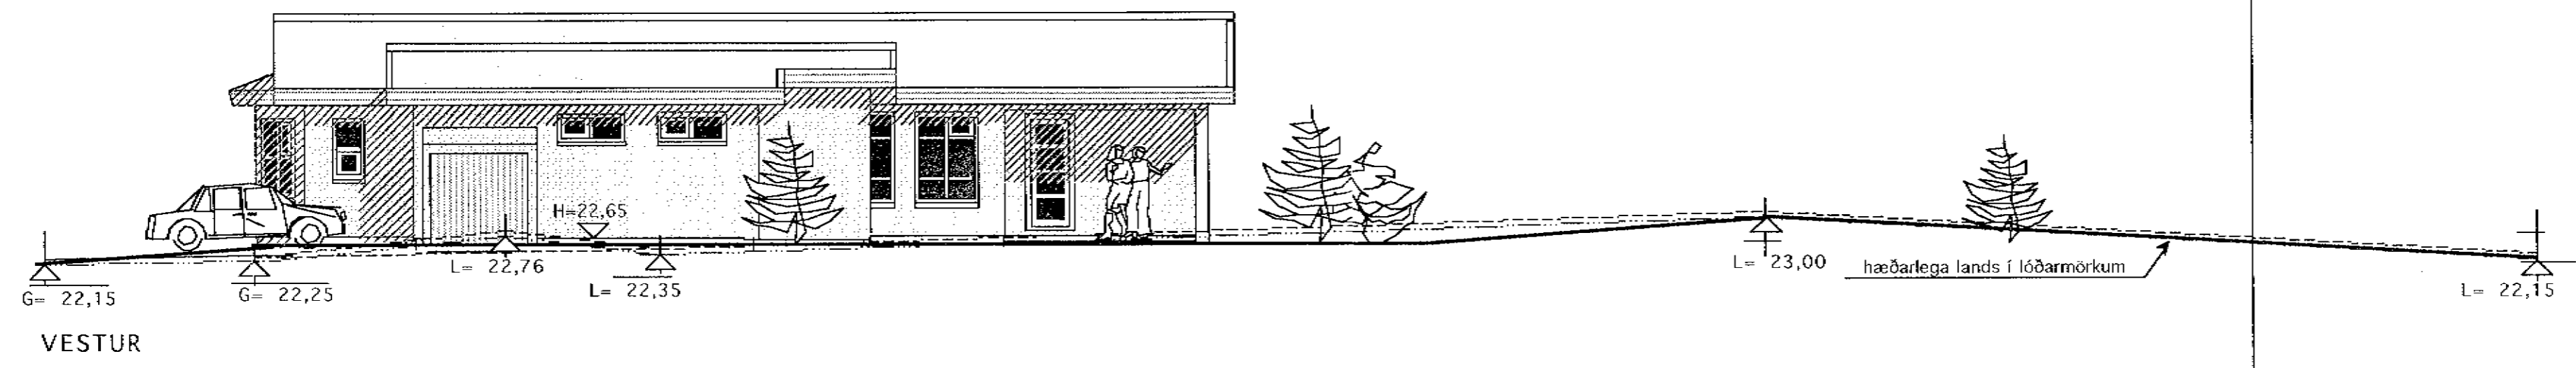
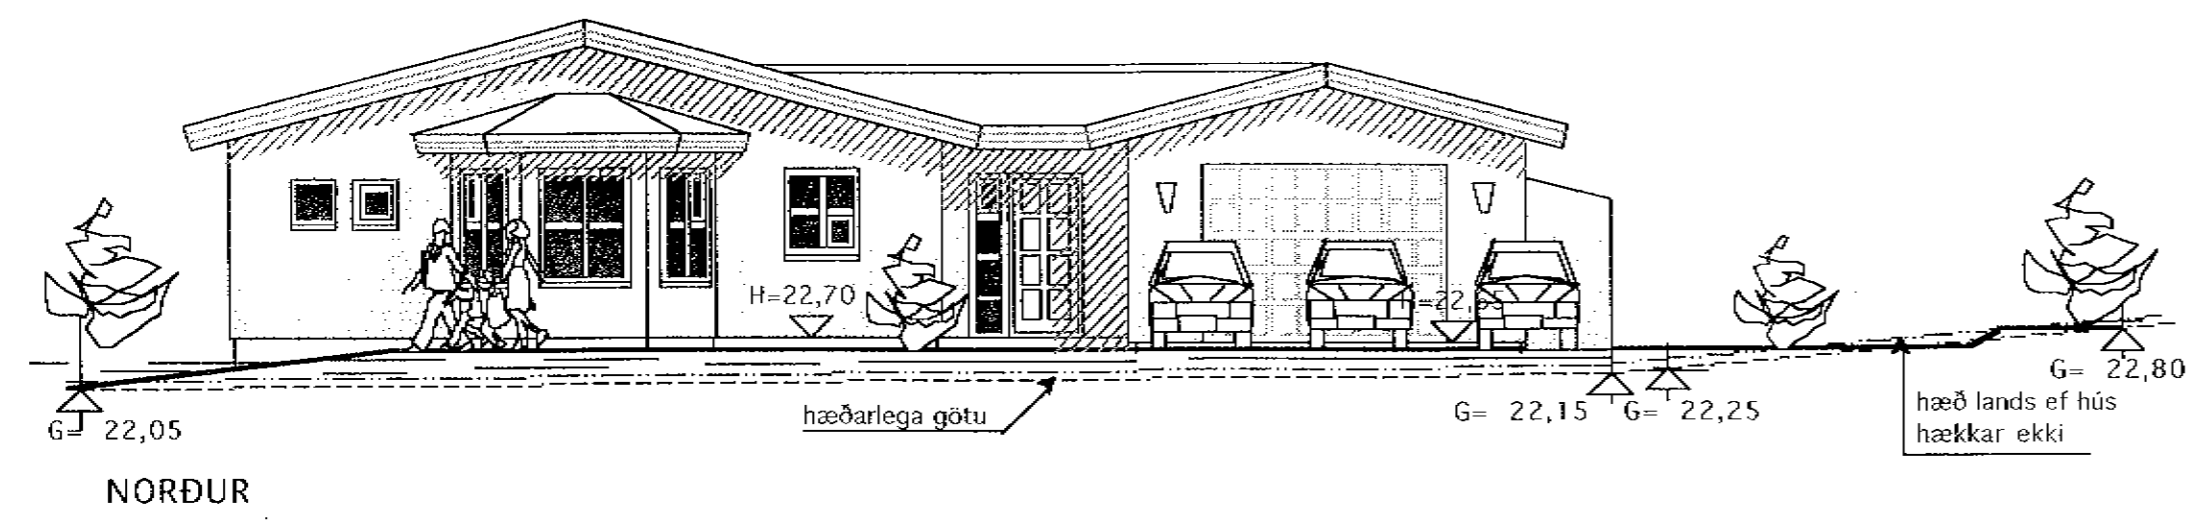


Samþykkt þann
 07 APR. 2004
 Byggingafultrúinn í Hafnarfirði
 F.h. Kristján Þórarinnsson


RP

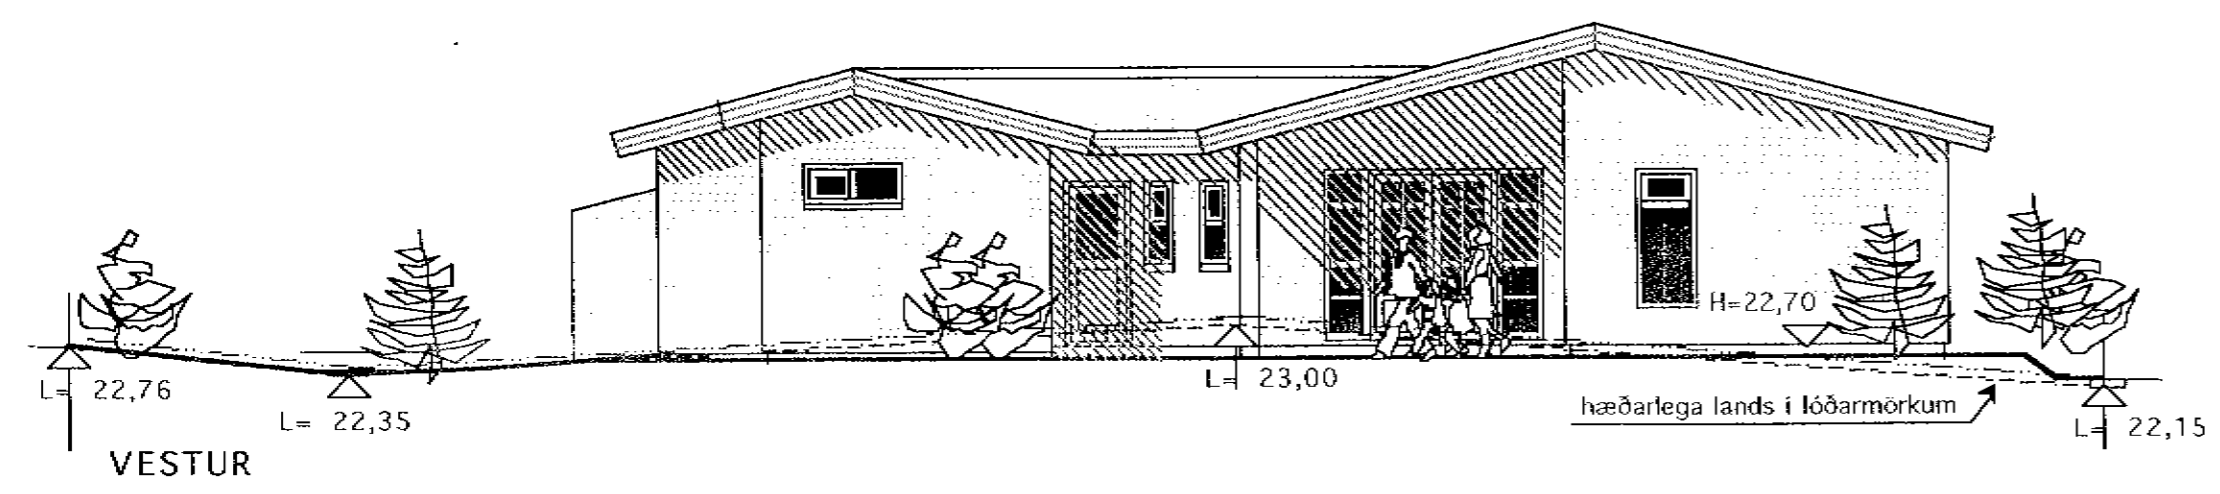

tifftopdf - www.rubissoftware.com - Demo Version

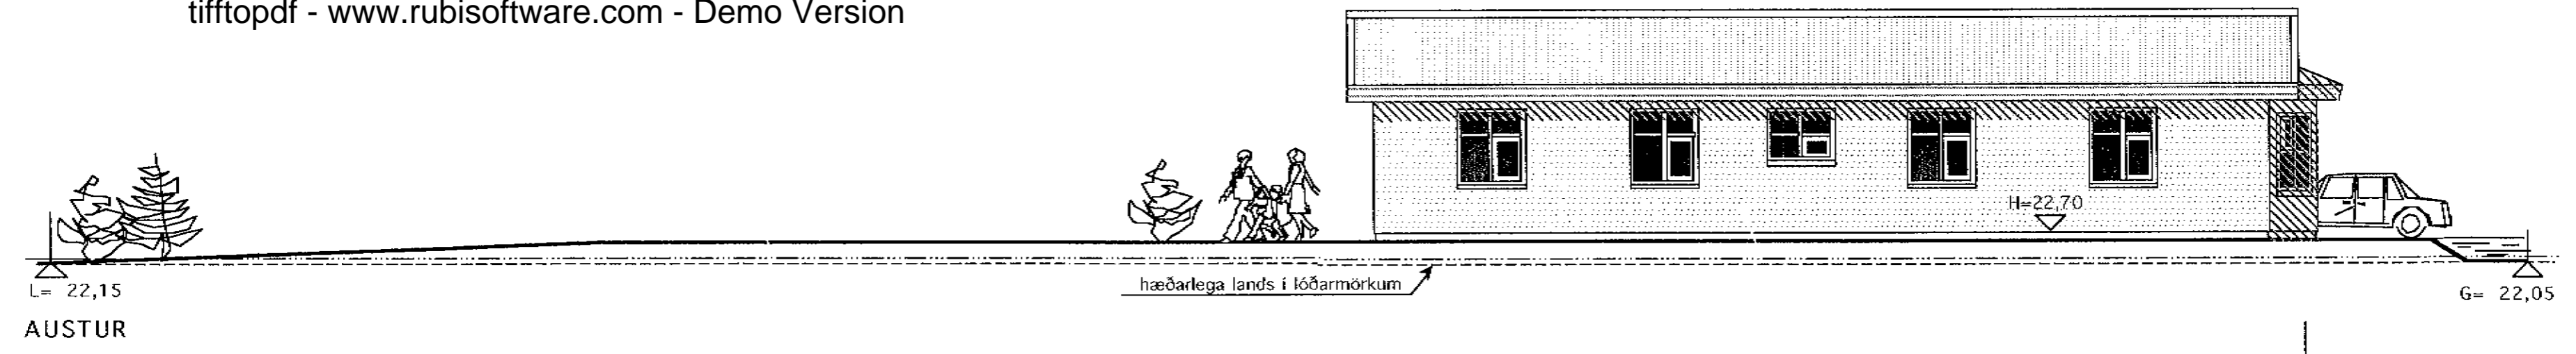

BREYTT 4 APRÍL. 2004
 SÓTT ER UM LEYFI TIL HÆKKA GÖLFKÖT UM 10 CM

	Verkefni	FURUVELLIR 35 HAFNARFIRÐI
	Heiti	ÚTLITSMYNDIR
kvarði	1:100	verk.nr
dags.	5 NÓV. 2003	dags br.
hönnun	G. G.	teikn nr
teikn	G.G.	A-3

Hringbraut 17 220 Hafnarfirði
 s. 555-2020 fax 555-2021
 Gísli G. Gunnarsson BFI kt. 0206492409
 www.kvardi.is - www.kvardi.is yortex.is

Gísli Gunnarsson