





Samþykkt þann

07 SEPT. 2004

Byggingafulltrúinn í Hafnarfirði
F.h. Kristján Þórarinnsson

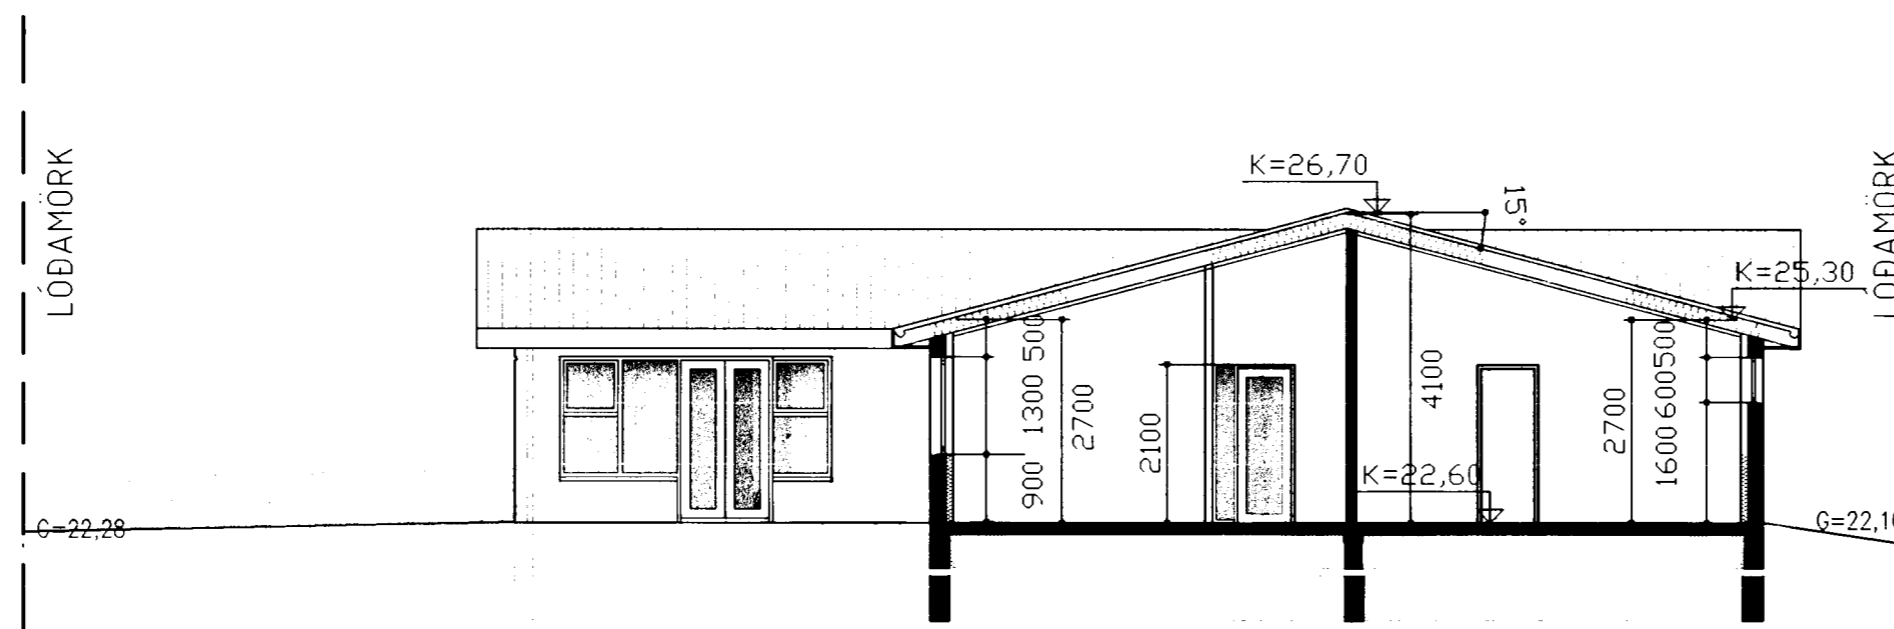

SNEIÐING A-A
1:100

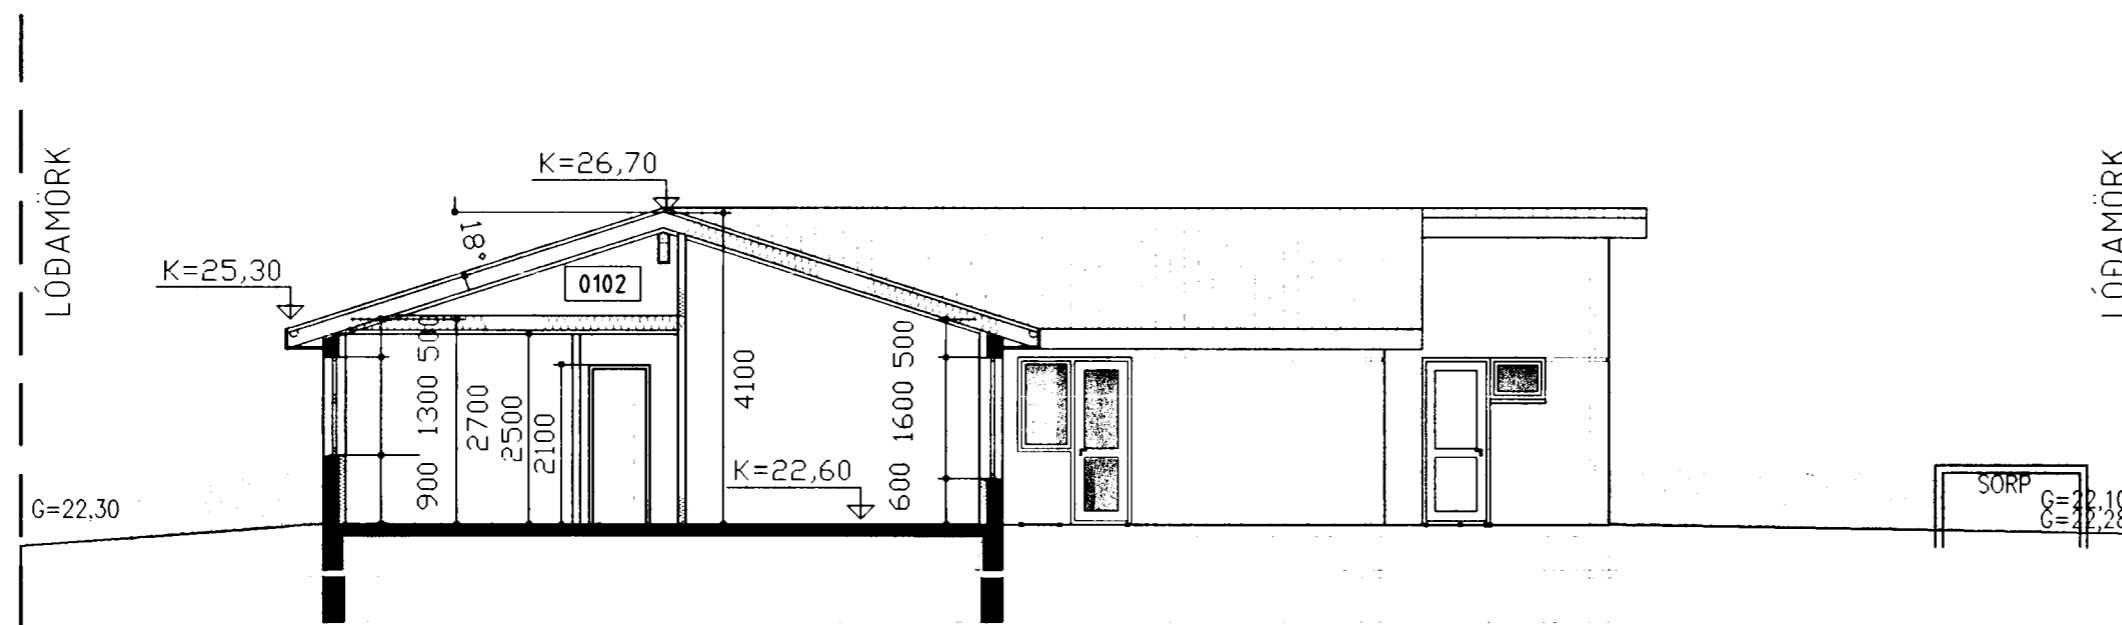

SNEIÐING B-B
1:100

BREYTINGAR			
NR.	DAGS.	BREYTING	Sp.
01	16.08.04	ELDHÚS GLUGGI OG BILSKÚRSHURÐ	
02	16.08.04	300 mm. HÆKKUN HÚSS	

BYGGINGAFRÆÐINGUR
JÓN M. HALLDÓRSSON

BLIKAHÓLAR 2
111 REYKJAVÍK
KT: 091162-3509

SÍMI: 557-5282
SÍMI: 897-3860
NETF: JMH@SIMNET.IS

SAMÞYKKT

VERK
FURUVELLIR-39
HAFNARFIRÐI

TEIKNING
SNEIÐINGAR:A-A,B-B

KVARDI
1:100



DAGS.
15.10.2003
TEIKNAD AF
JMH

TEIKNING NR.

10-04